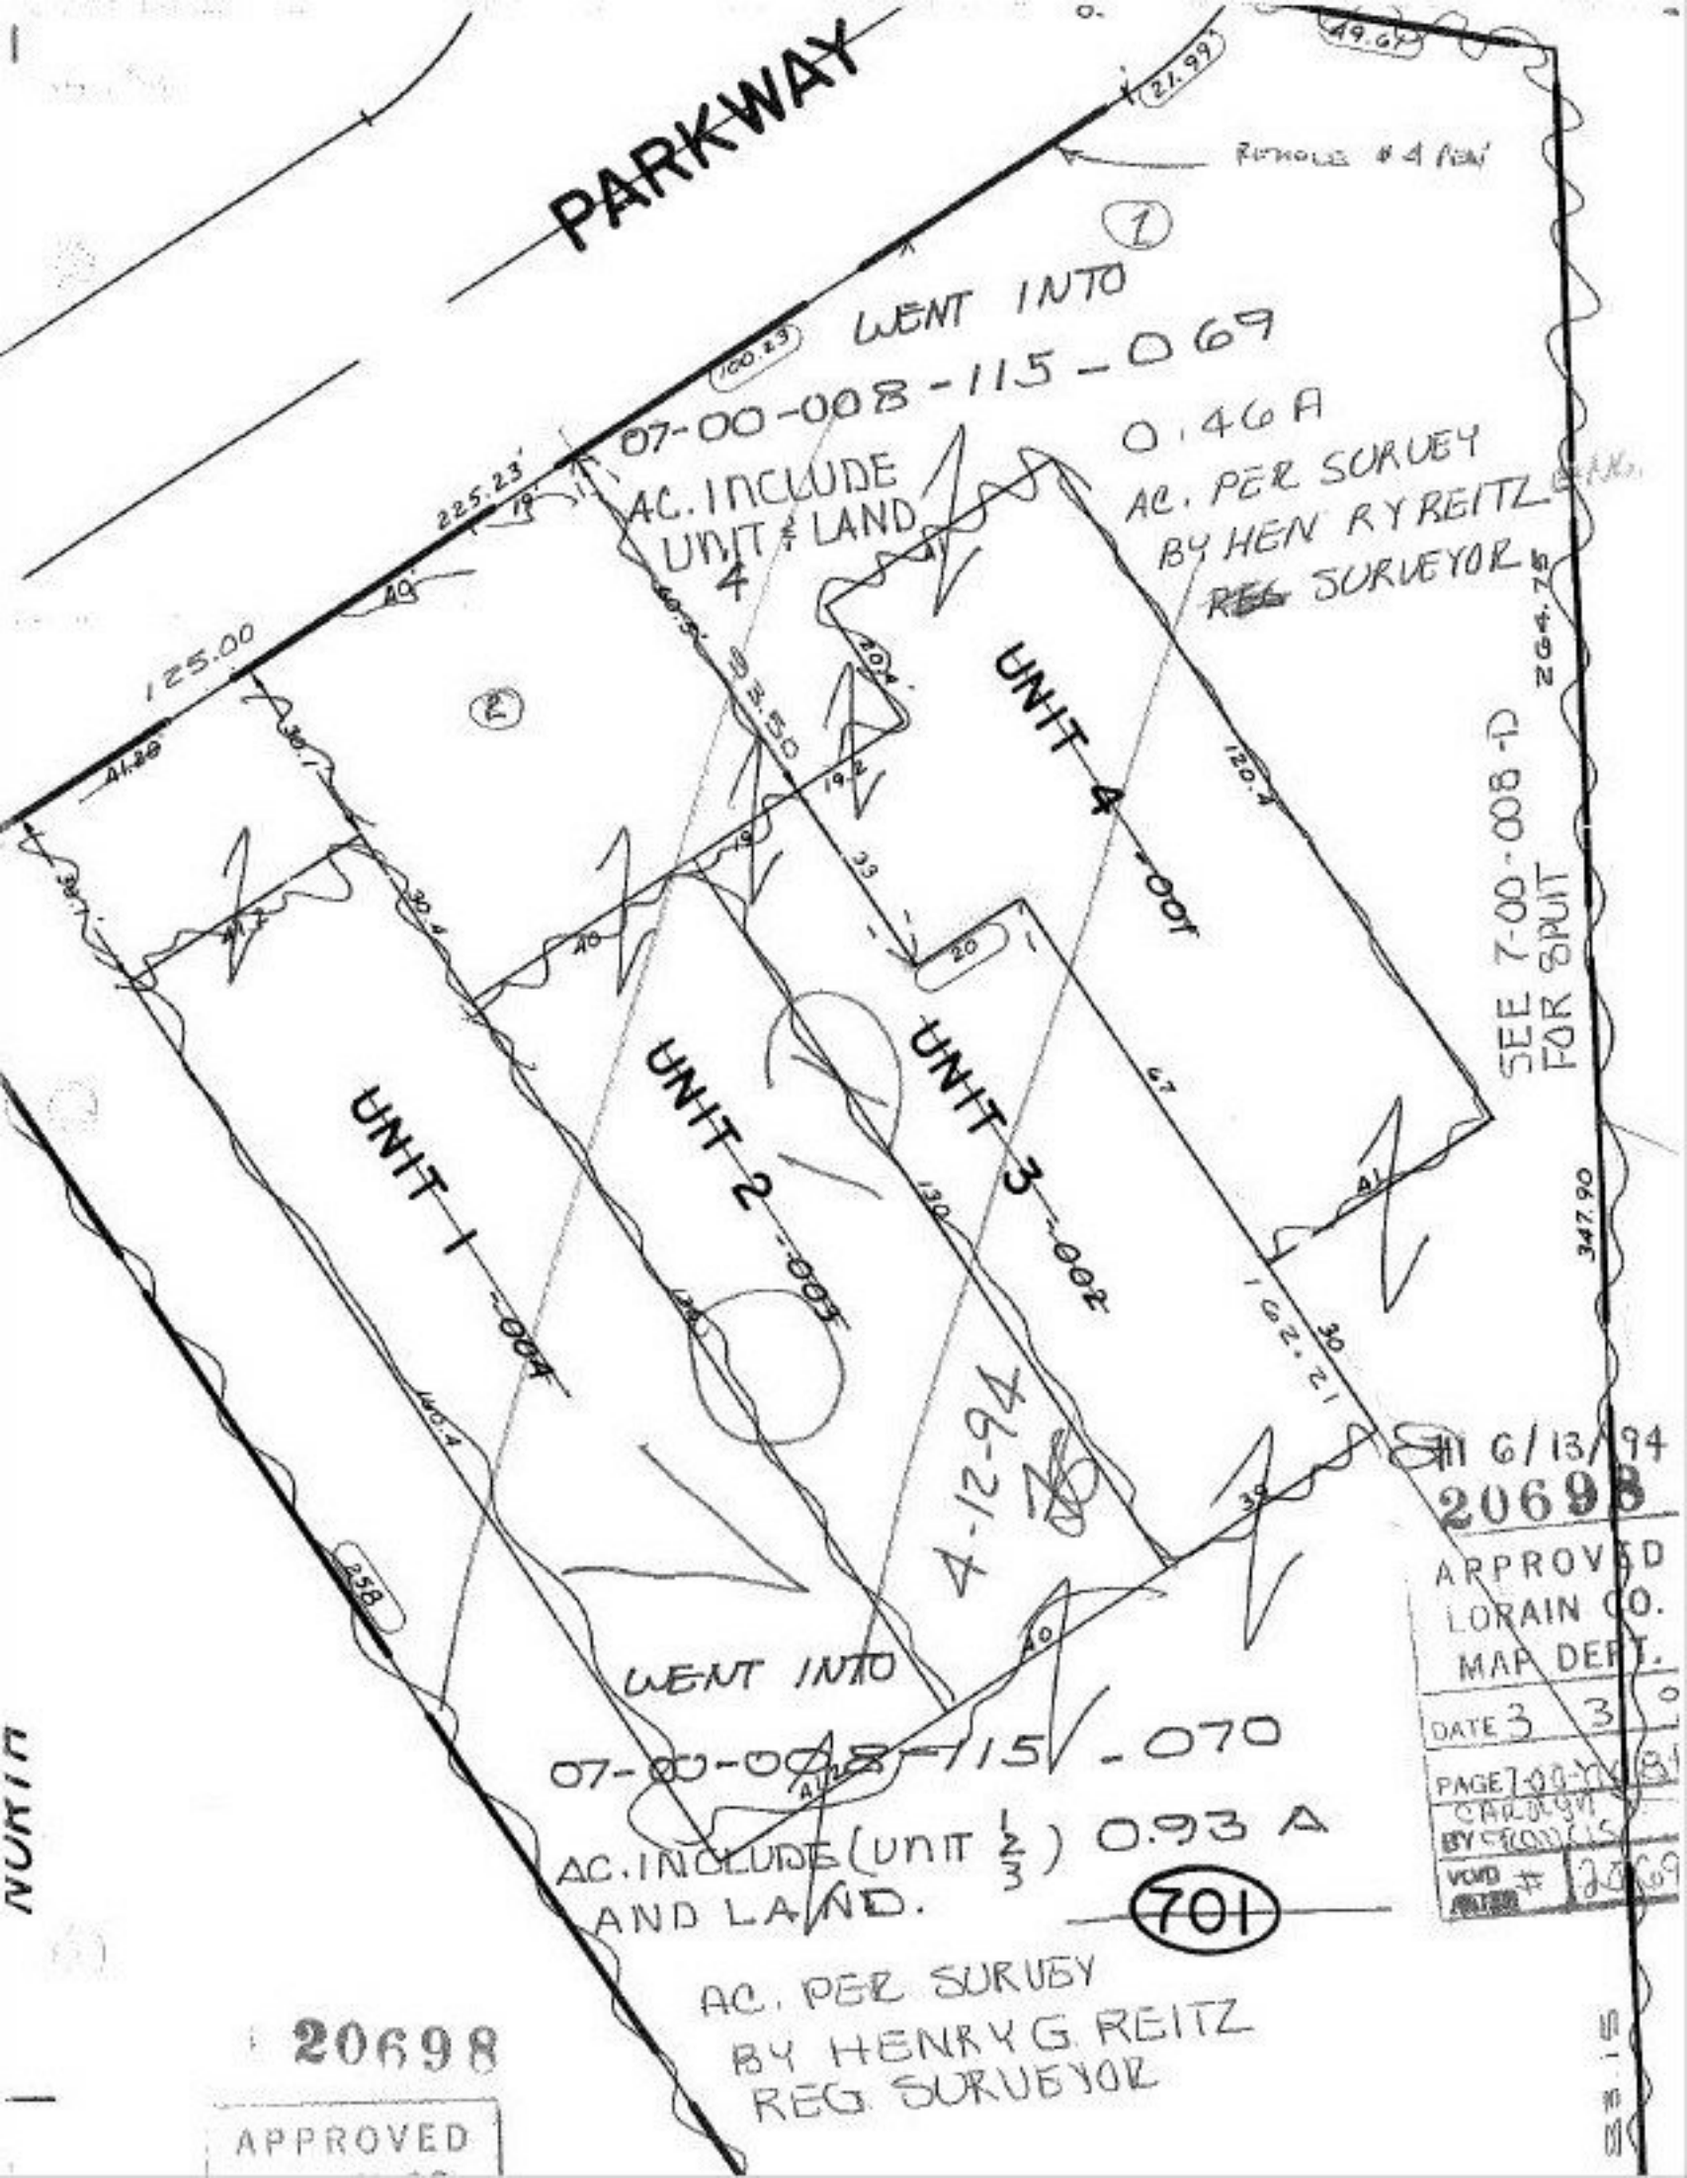
PARKWAY
REMOVE #4 PEN
WENT INTO
07-00-008-115-069
AC. INCLUDE UNIT 4 LAND
0.46 A
AC. PER SURVEY BY HENRY REITZ REG SURVEYOR
UNIT 4 -001
UNIT 3 -002
UNIT 2 -003
UNIT 1 -004
SEE 7-00-008-D FOR SPLIT
4-12-94
WENT INTO
07-00-008-115-070
AC. INCLUDE (UNIT 1 2 3) 0.93 A AND LAND.
701
AC. PER SURVEY BY HENRY G. REITZ REG. SURVEYOR
NORTH
6/13/94
20698
APPROVED
LORAIN CO.
MAP DEPT.
DATE 3 3
PAGE 7-00-008
CAROLYN
BY
VOID #
20698
APPROVED