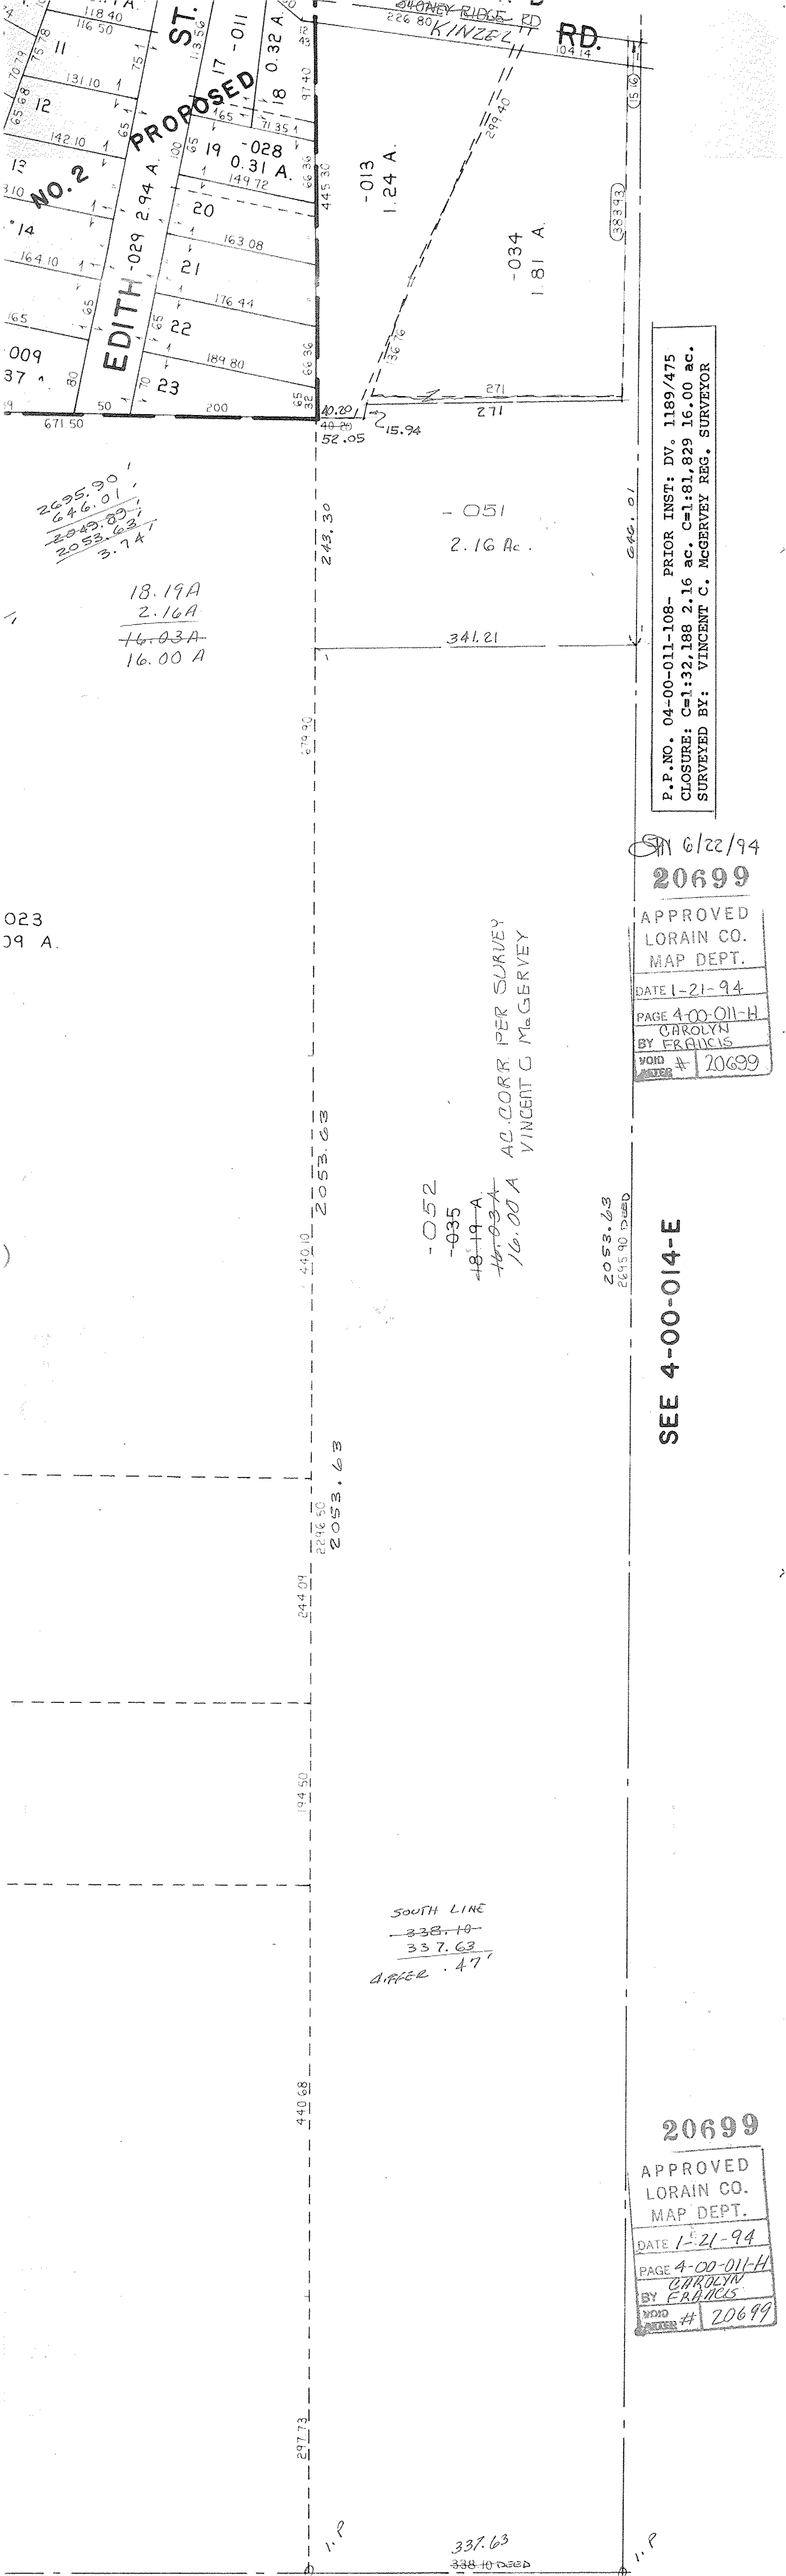
SWONEY RIDGE RD
226.80
KINZEL RD.
104.14
PROPOSED ST.
NO. 2
EDITH
-029 2.94 A.
-011
-018 0.32 A.
-028 0.31 A.
-013 1.24 A.
-034 1.81 A.
-051 2.16 Ac.
-052
-035
18.19A
2.16A
16.03A
16.00 A
2695.90
646.01
2049.89
2053.63
3.74
243.30
646.01
341.21
279.90
2053.63
440.10
222.50
244.09
194.50
440.68
297.73
337.63
338.10 DEED
SOUTH LINE
338.10
337.63
DIFFER .47'
AC. CORR. PER SURVEY
VINCENT C McGERVEY
SEE 4-00-014-E
P.P.NO. 04-00-011-108- PRIOR INST: DV. 1189/475
CLOSURE: C=1:32,188 2.16 ac. C=1:81,829 16.00 ac.
SURVEYED BY: VINCENT C. McGERVEY REG. SURVEYOR
6/22/94
20699
APPROVED
LORAIN CO.
MAP DEPT.
DATE 1-21-94
PAGE 4-00-011-H
CAROLYN
BY FRANCIS
VOID AFTER # 20699
20699
APPROVED
LORAIN CO.
MAP DEPT.
DATE 1-21-94
PAGE 4-00-011-H
CAROLYN
BY FRANCIS
VOID AFTER # 20699