1-4-94

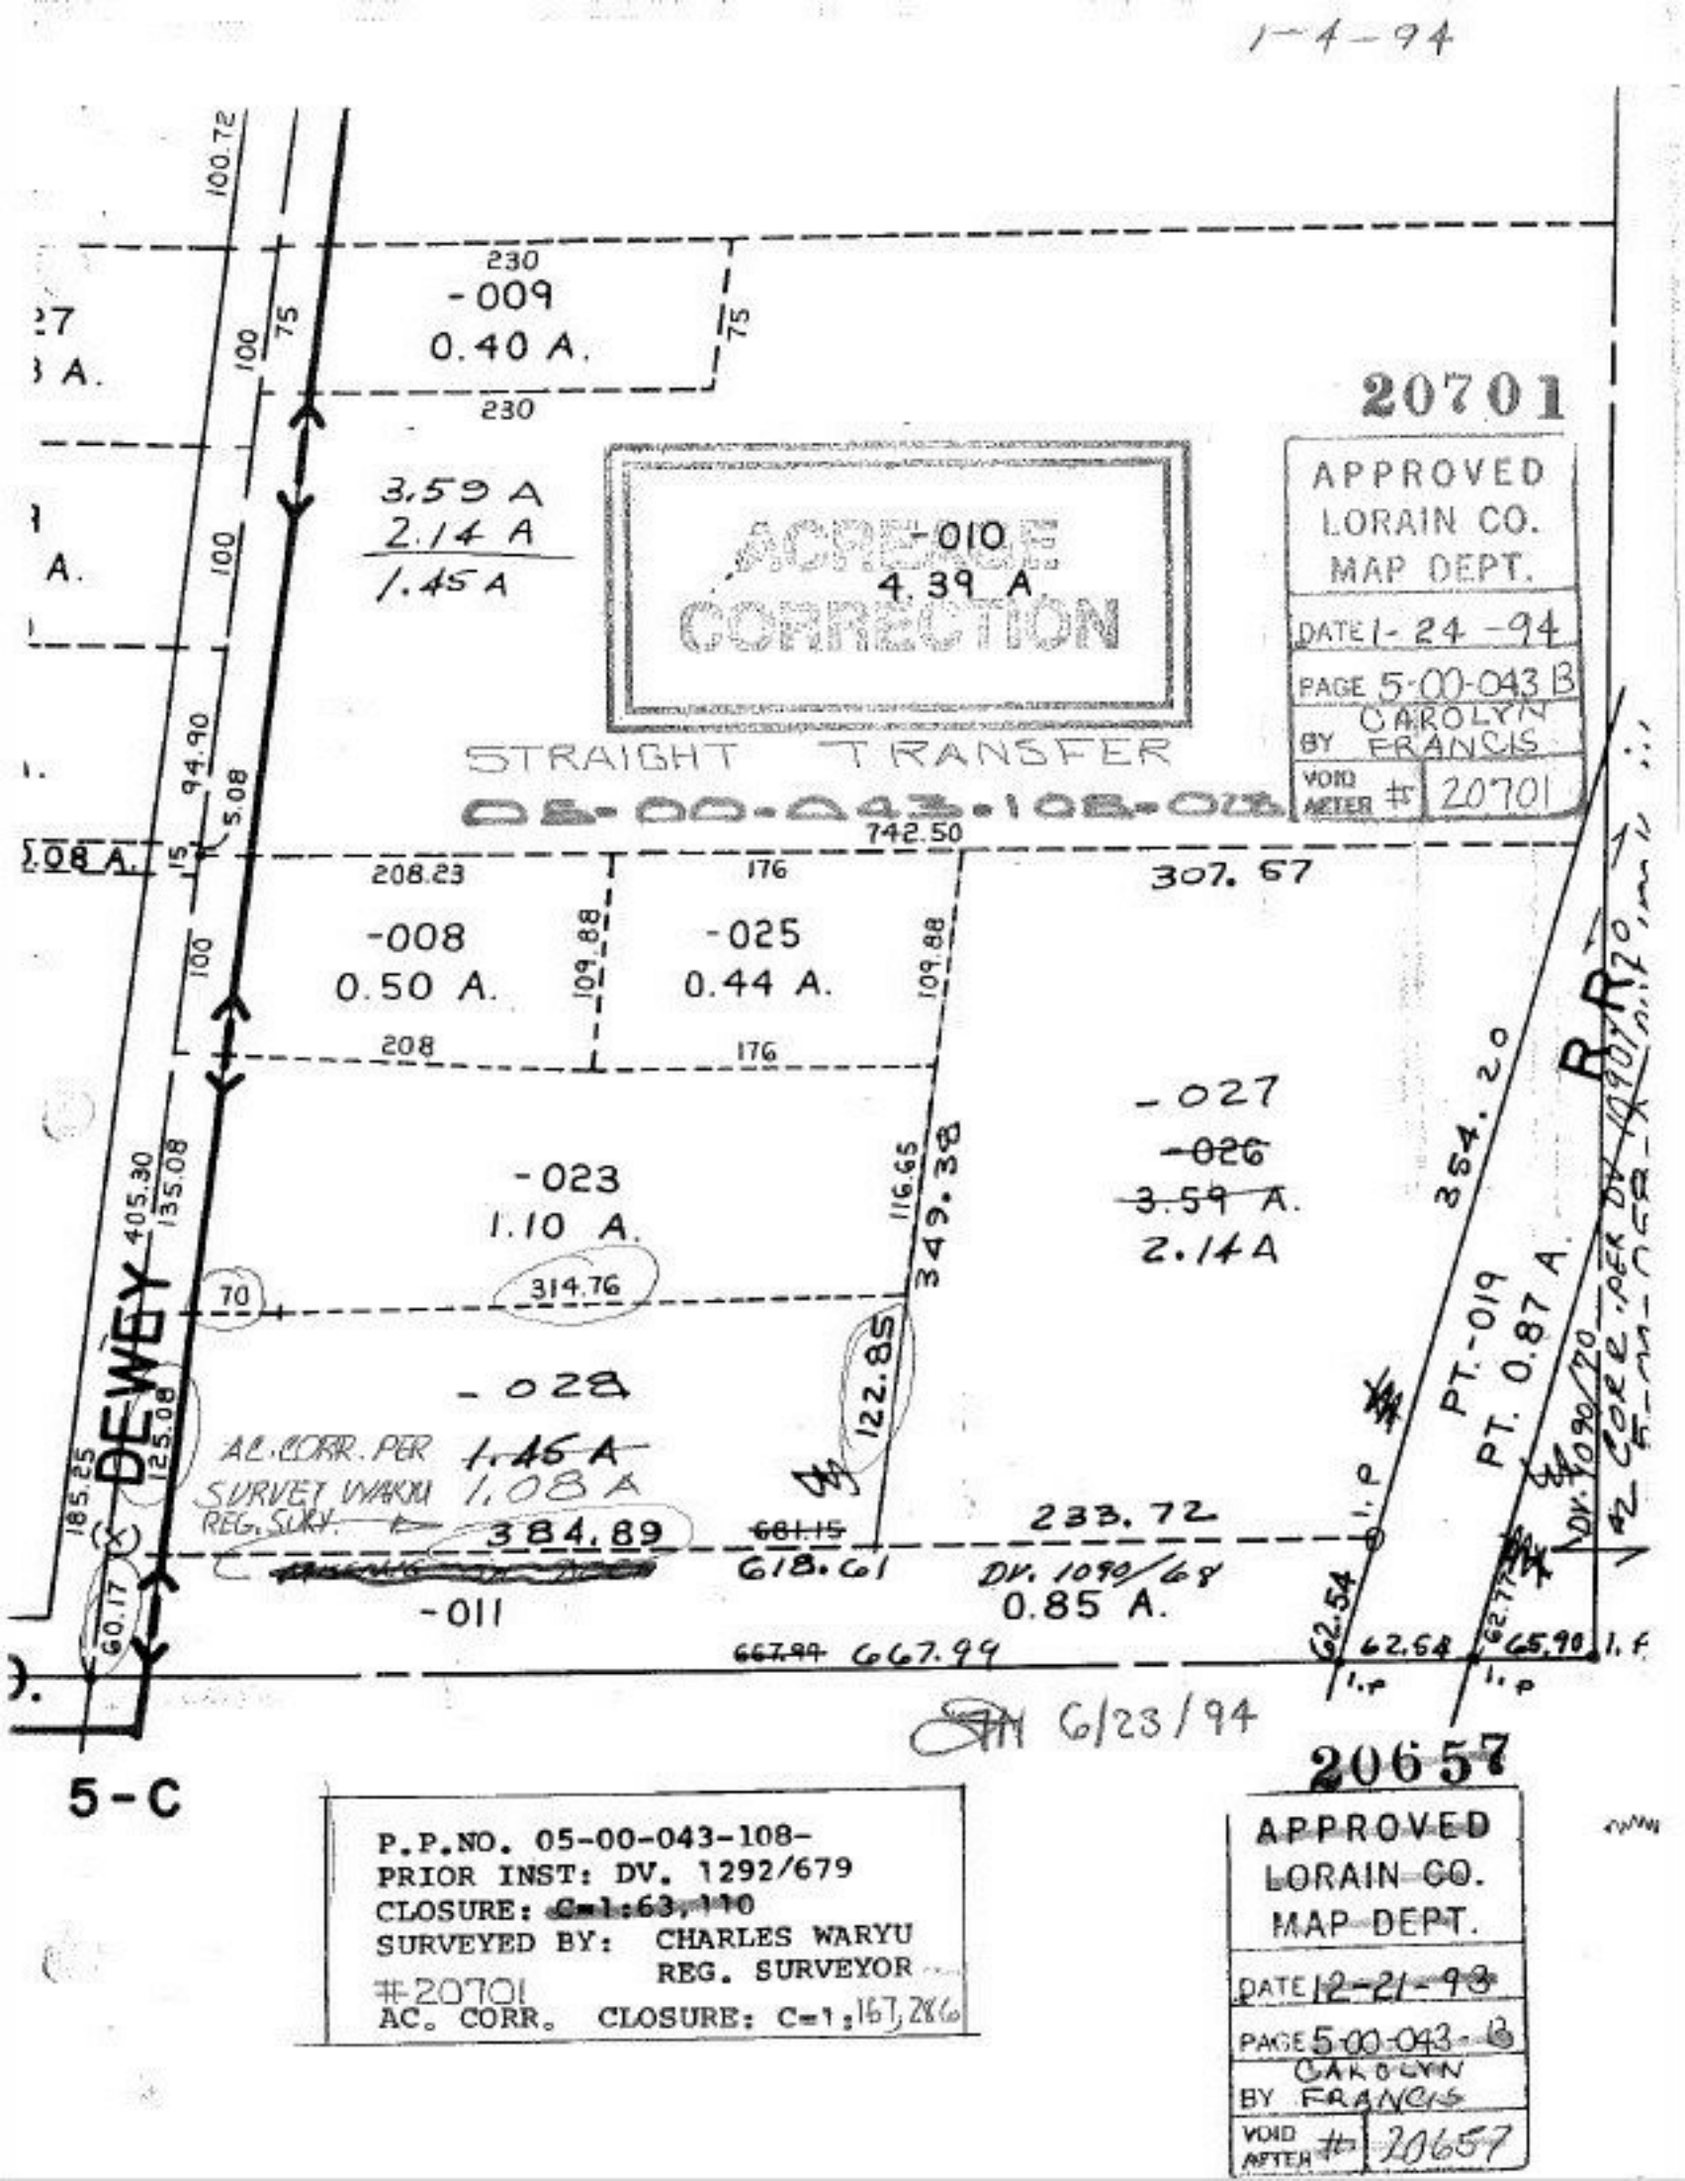

ACREAGE CORRECTION

-010
4.39 A

STRAIGHT TRANSFER

05-00-043-108-013

20701

APPROVED
LORAIN CO.
MAP DEPT.
DATE 1-24-94
PAGE 5-00-043 B
BY CAROLYN FRANCIS
VOID AFTER # 20701

P.P.NO. 05-00-043-108-
PRIOR INST: DV. 1292/679
CLOSURE: ~~C=1:63,110~~
SURVEYED BY: CHARLES WARYU
REG. SURVEYOR
#20701
AC. CORR. CLOSURE: C=1:167,286

20657

APPROVED
LORAIN CO.
MAP DEPT.
DATE 12-21-93
PAGE 5-00-043-B
BY CAROLYN FRANCIS
VOID AFTER # 20657