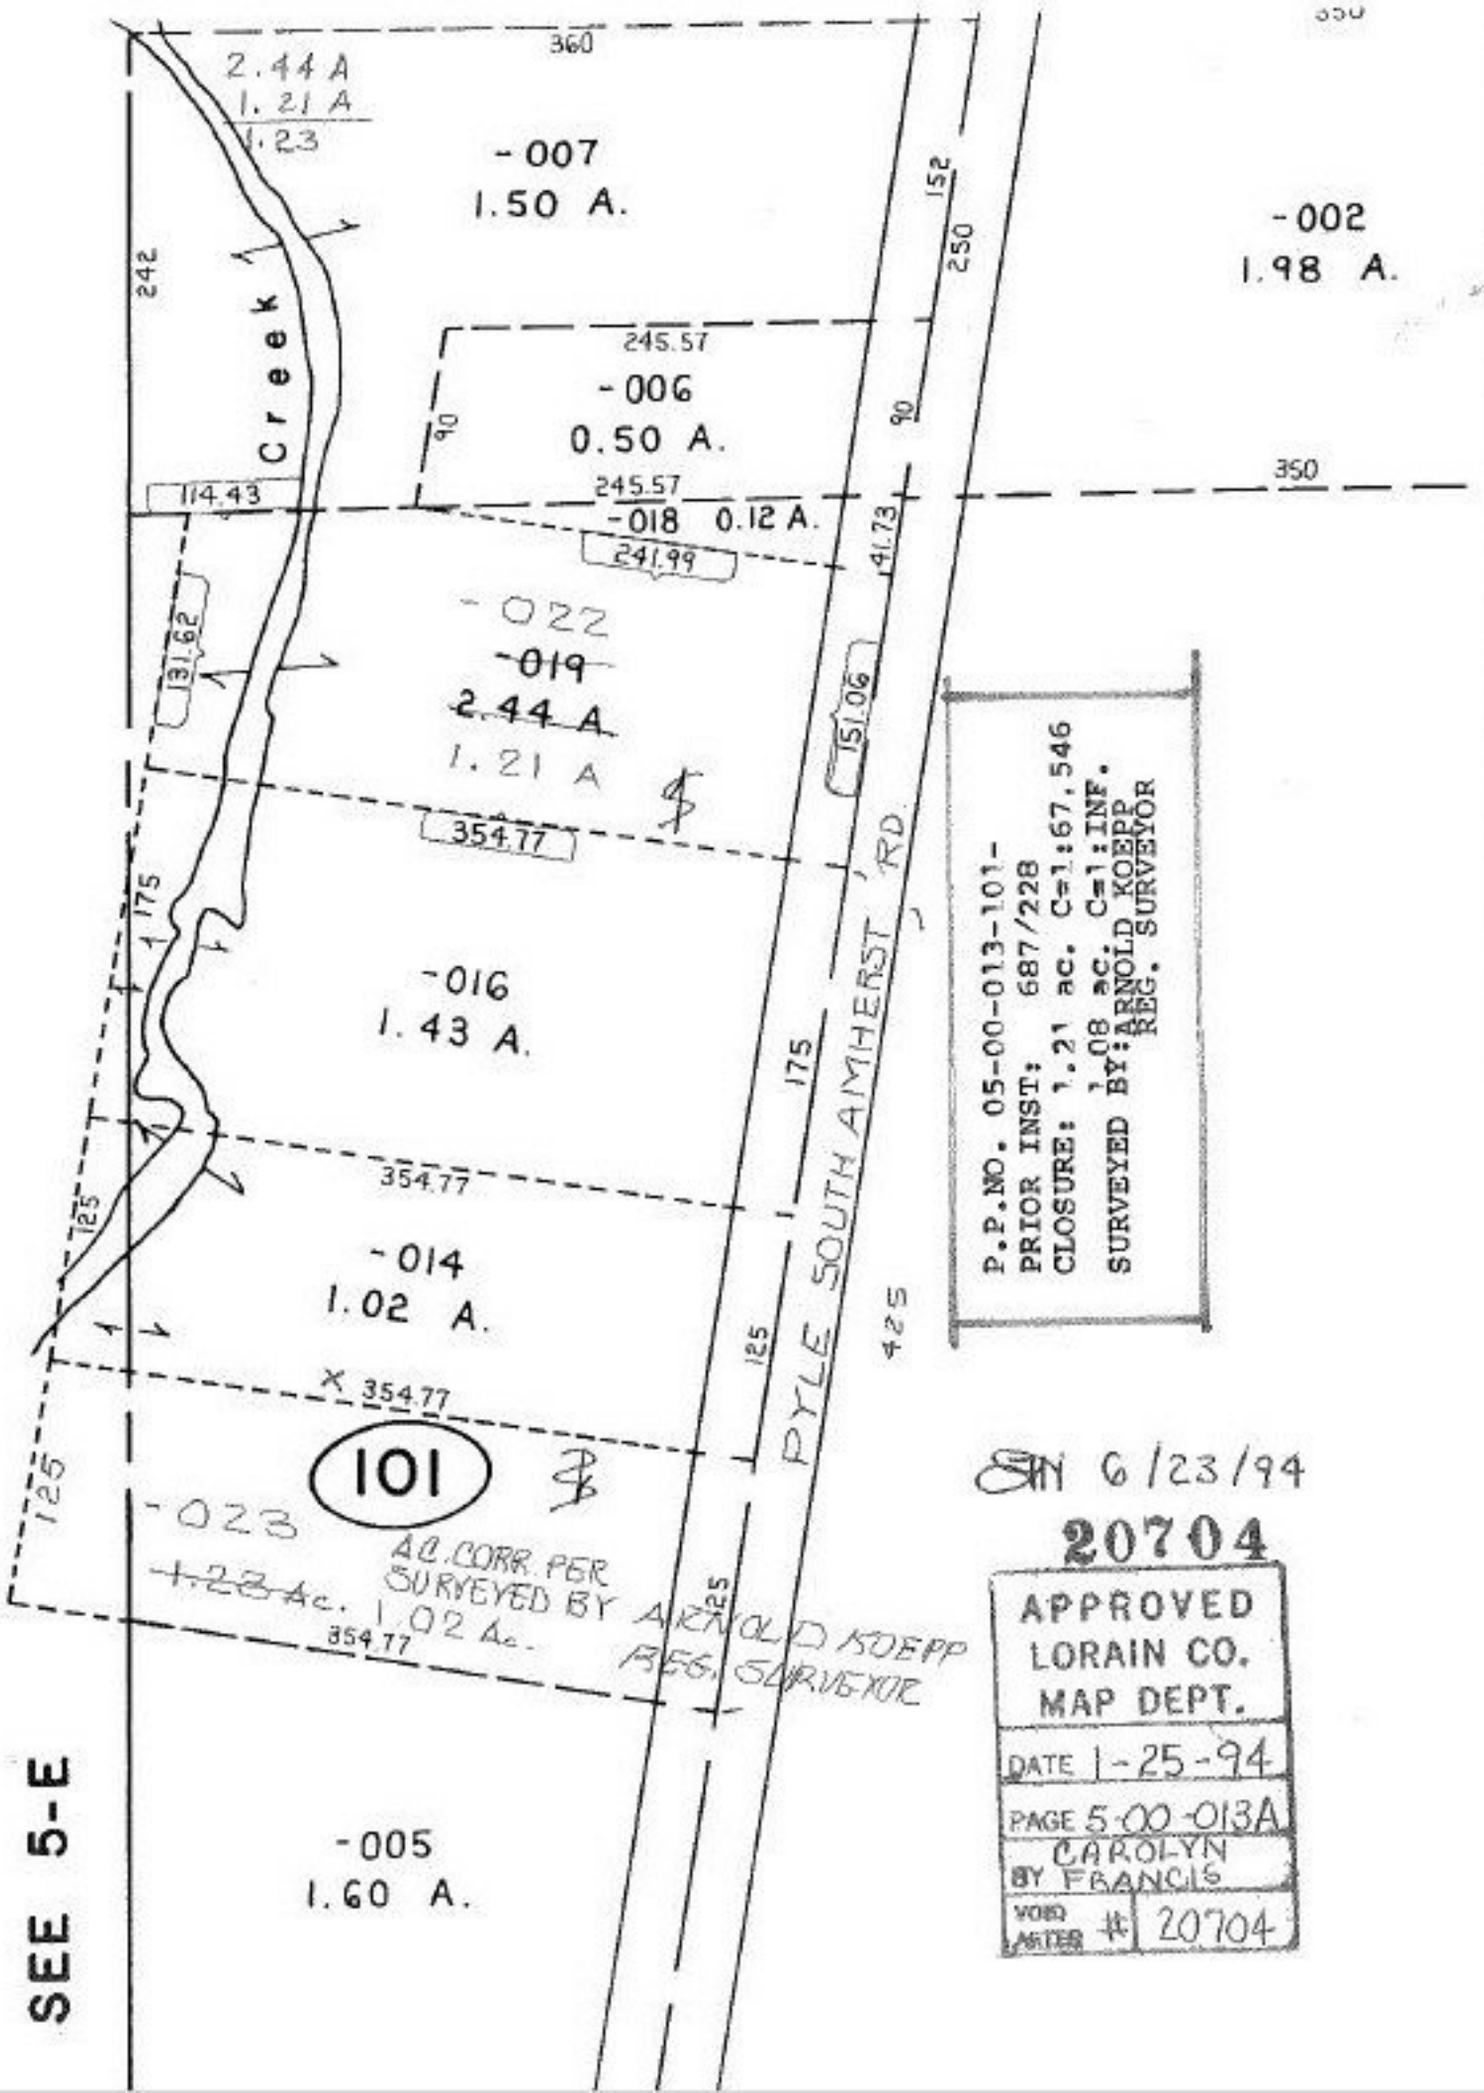
2.44 A
1.21 A
1.23
360
-007
1.50 A.
-002
1.98 A.
242
Creek
245.57
-006
0.50 A.
90
152
250
350
114.43
245.57
-018 0.12 A.
241.99
41.73
-022
-019
2.44 A
1.21 A
31.62
151.06
354.77
175
-016
1.43 A.
354.77
125
-014
1.02 A.
X 354.77
425
PYLE SOUTH AMHERST RD.
101
-023
AC. CORR. PER SURVEYED BY ARNOLD KOEPP REG. SURVEYOR
1.28 Ac. 1.02 Ac.
354.77
-005
1.60 A.
SEE 5-E
P.P.NO. 05-00-013-101-
PRIOR INST: 687/228
CLOSURE: 1.21 ac. C=1:67,546
1.08 ac. C=1:INF.
SURVEYED BY: ARNOLD KOEPP
REG. SURVEYOR
SN 6/23/94
20704
APPROVED
LORAIN CO.
MAP DEPT.
DATE 1-25-94
PAGE 5-00-013A
CAROLYN
BY FRANCIS
VOID AFTER # 20704