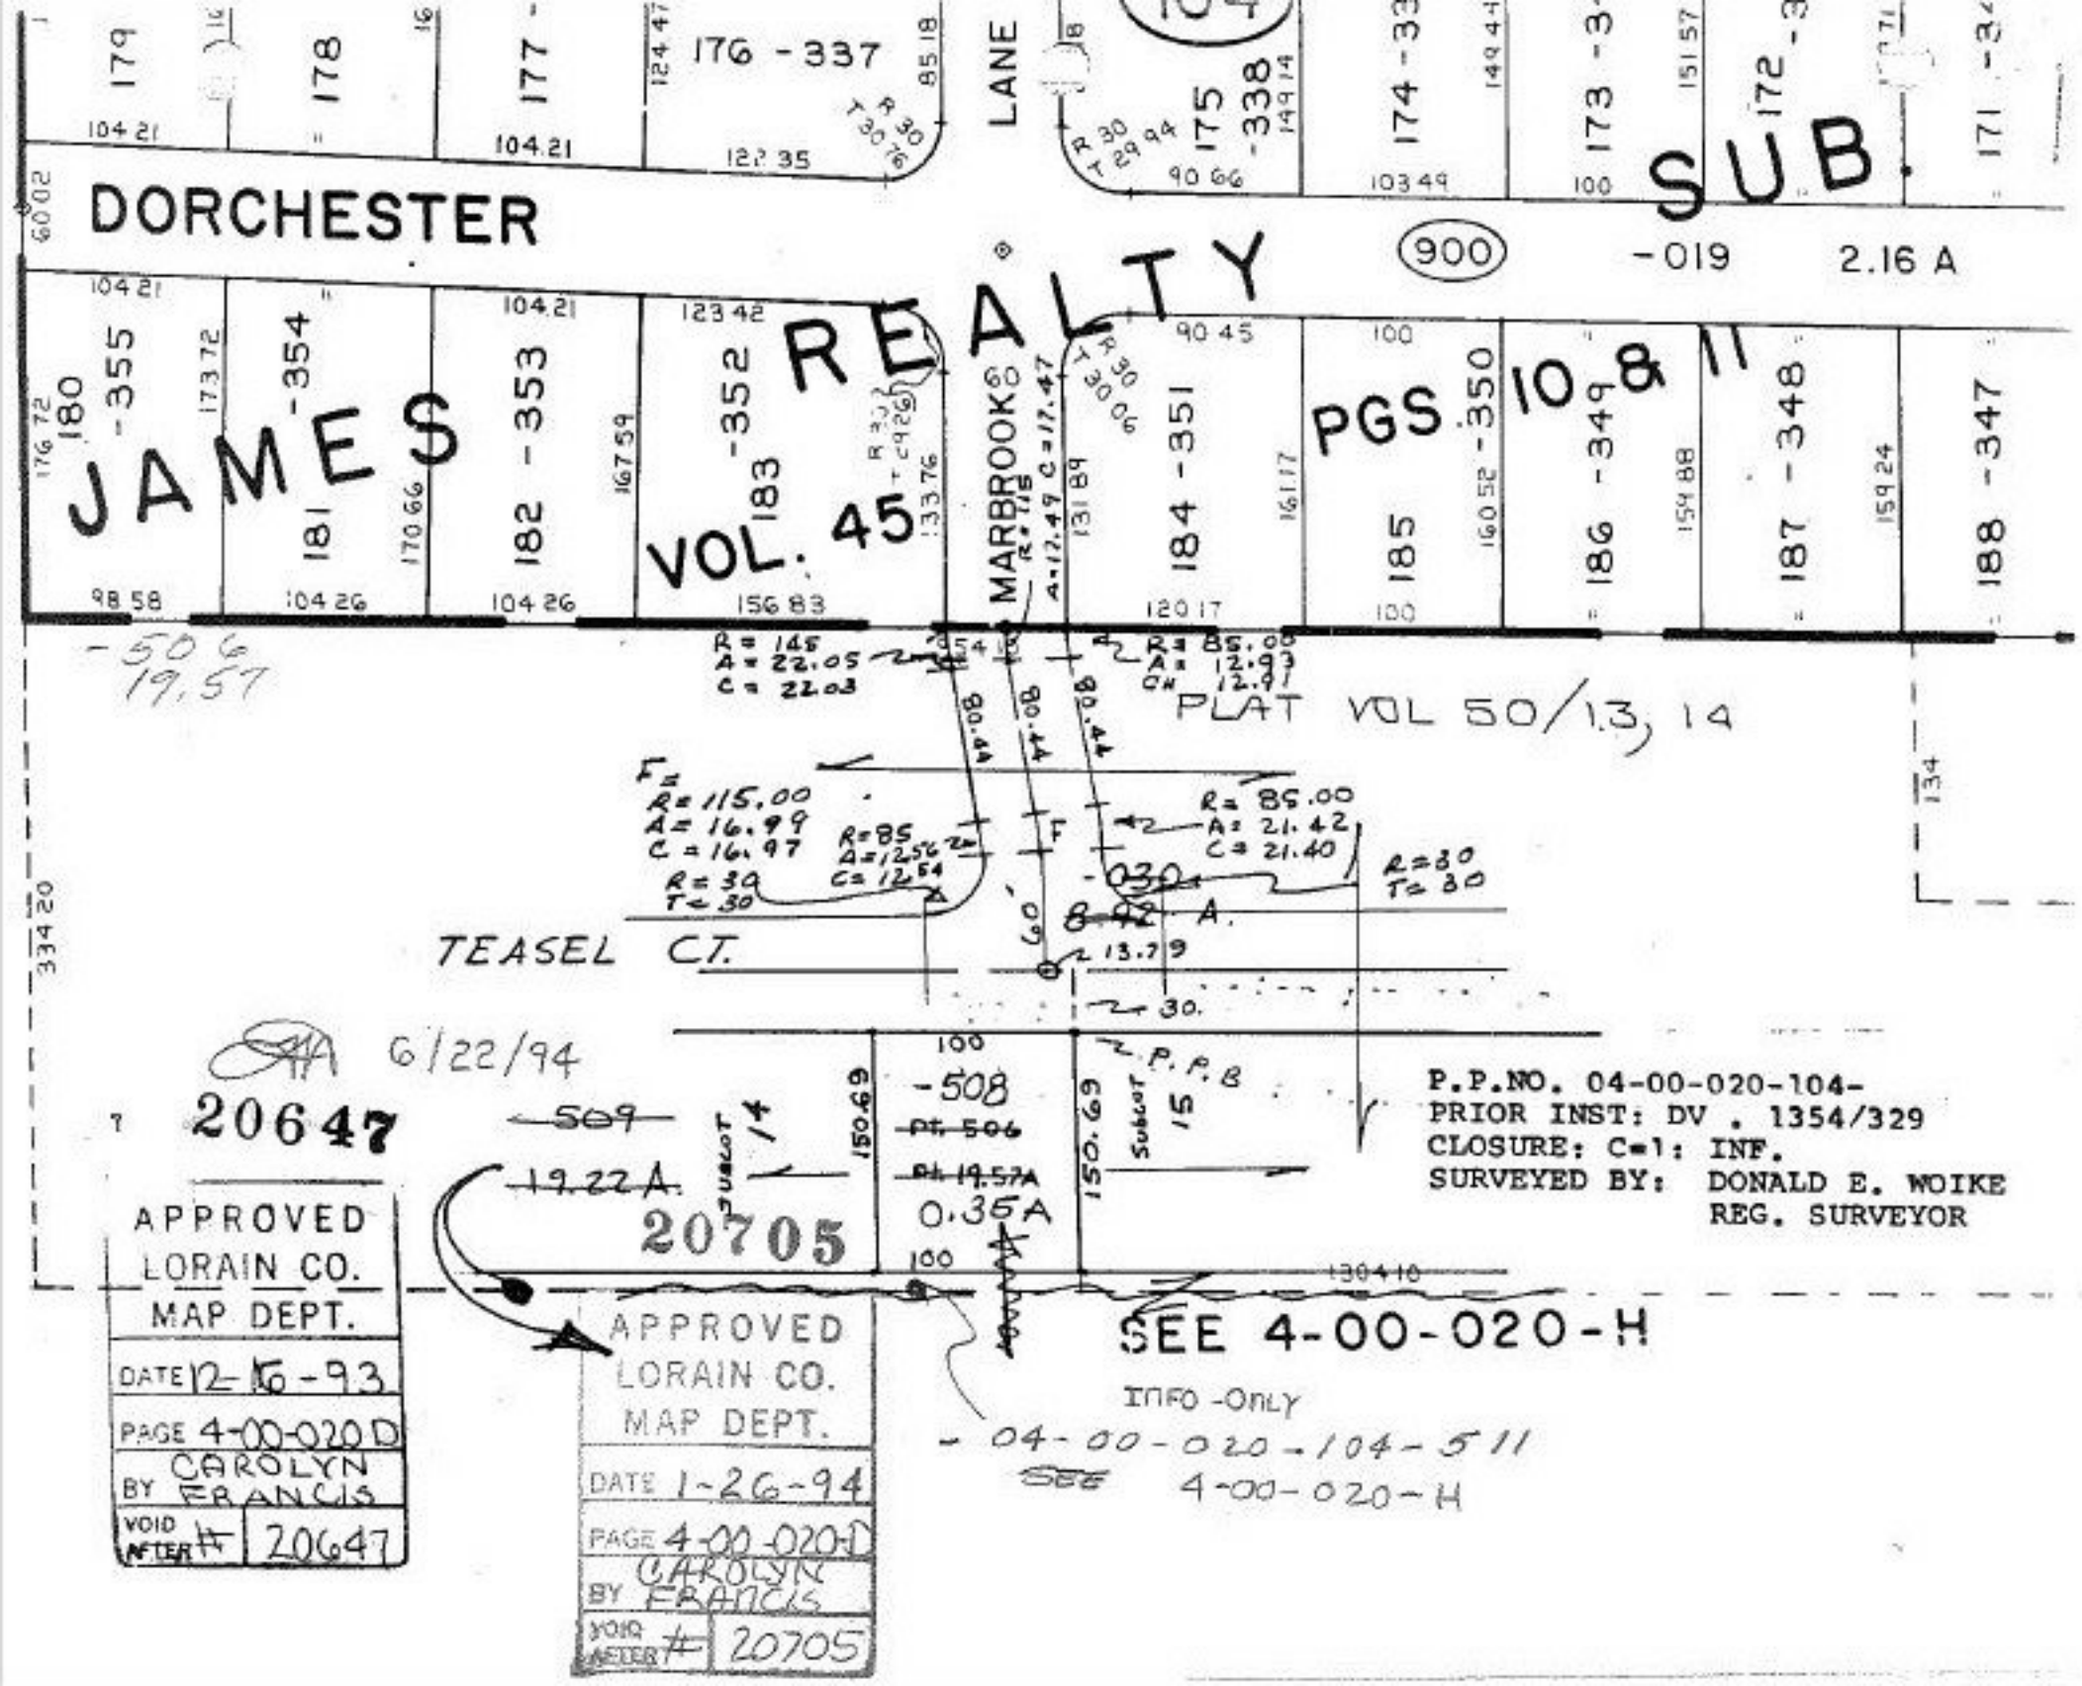
DORCHESTER
JAMES REALTY
SUB
VOL. 45
PGS 10 & 11
PLAT VOL 50/13, 14
MARBROOK
LANE
TEASEL CT.
900
-019 2.16 A
-506
19.57
-508
pt. 506
pt. 19.57A
0.35 A
-030
8.42 A.
20647
20705
19.22A.
-509
APPROVED LORAIN CO. MAP DEPT. DATE 12-16-93 PAGE 4-00-020 D BY CAROLYN FRANCIS VOID AFTER # 20647
APPROVED LORAIN CO. MAP DEPT. DATE 1-26-94 PAGE 4-00-020-D BY CAROLYN FRANCIS VOID AFTER # 20705
P.P.NO. 04-00-020-104-
PRIOR INST: DV . 1354/329
CLOSURE: C=1: INF.
SURVEYED BY: DONALD E. WOIKE
REG. SURVEYOR
SEE 4-00-020-H
INFO -ONLY
- 04-00-020-104-511
SEE 4-00-020-H
6/22/94