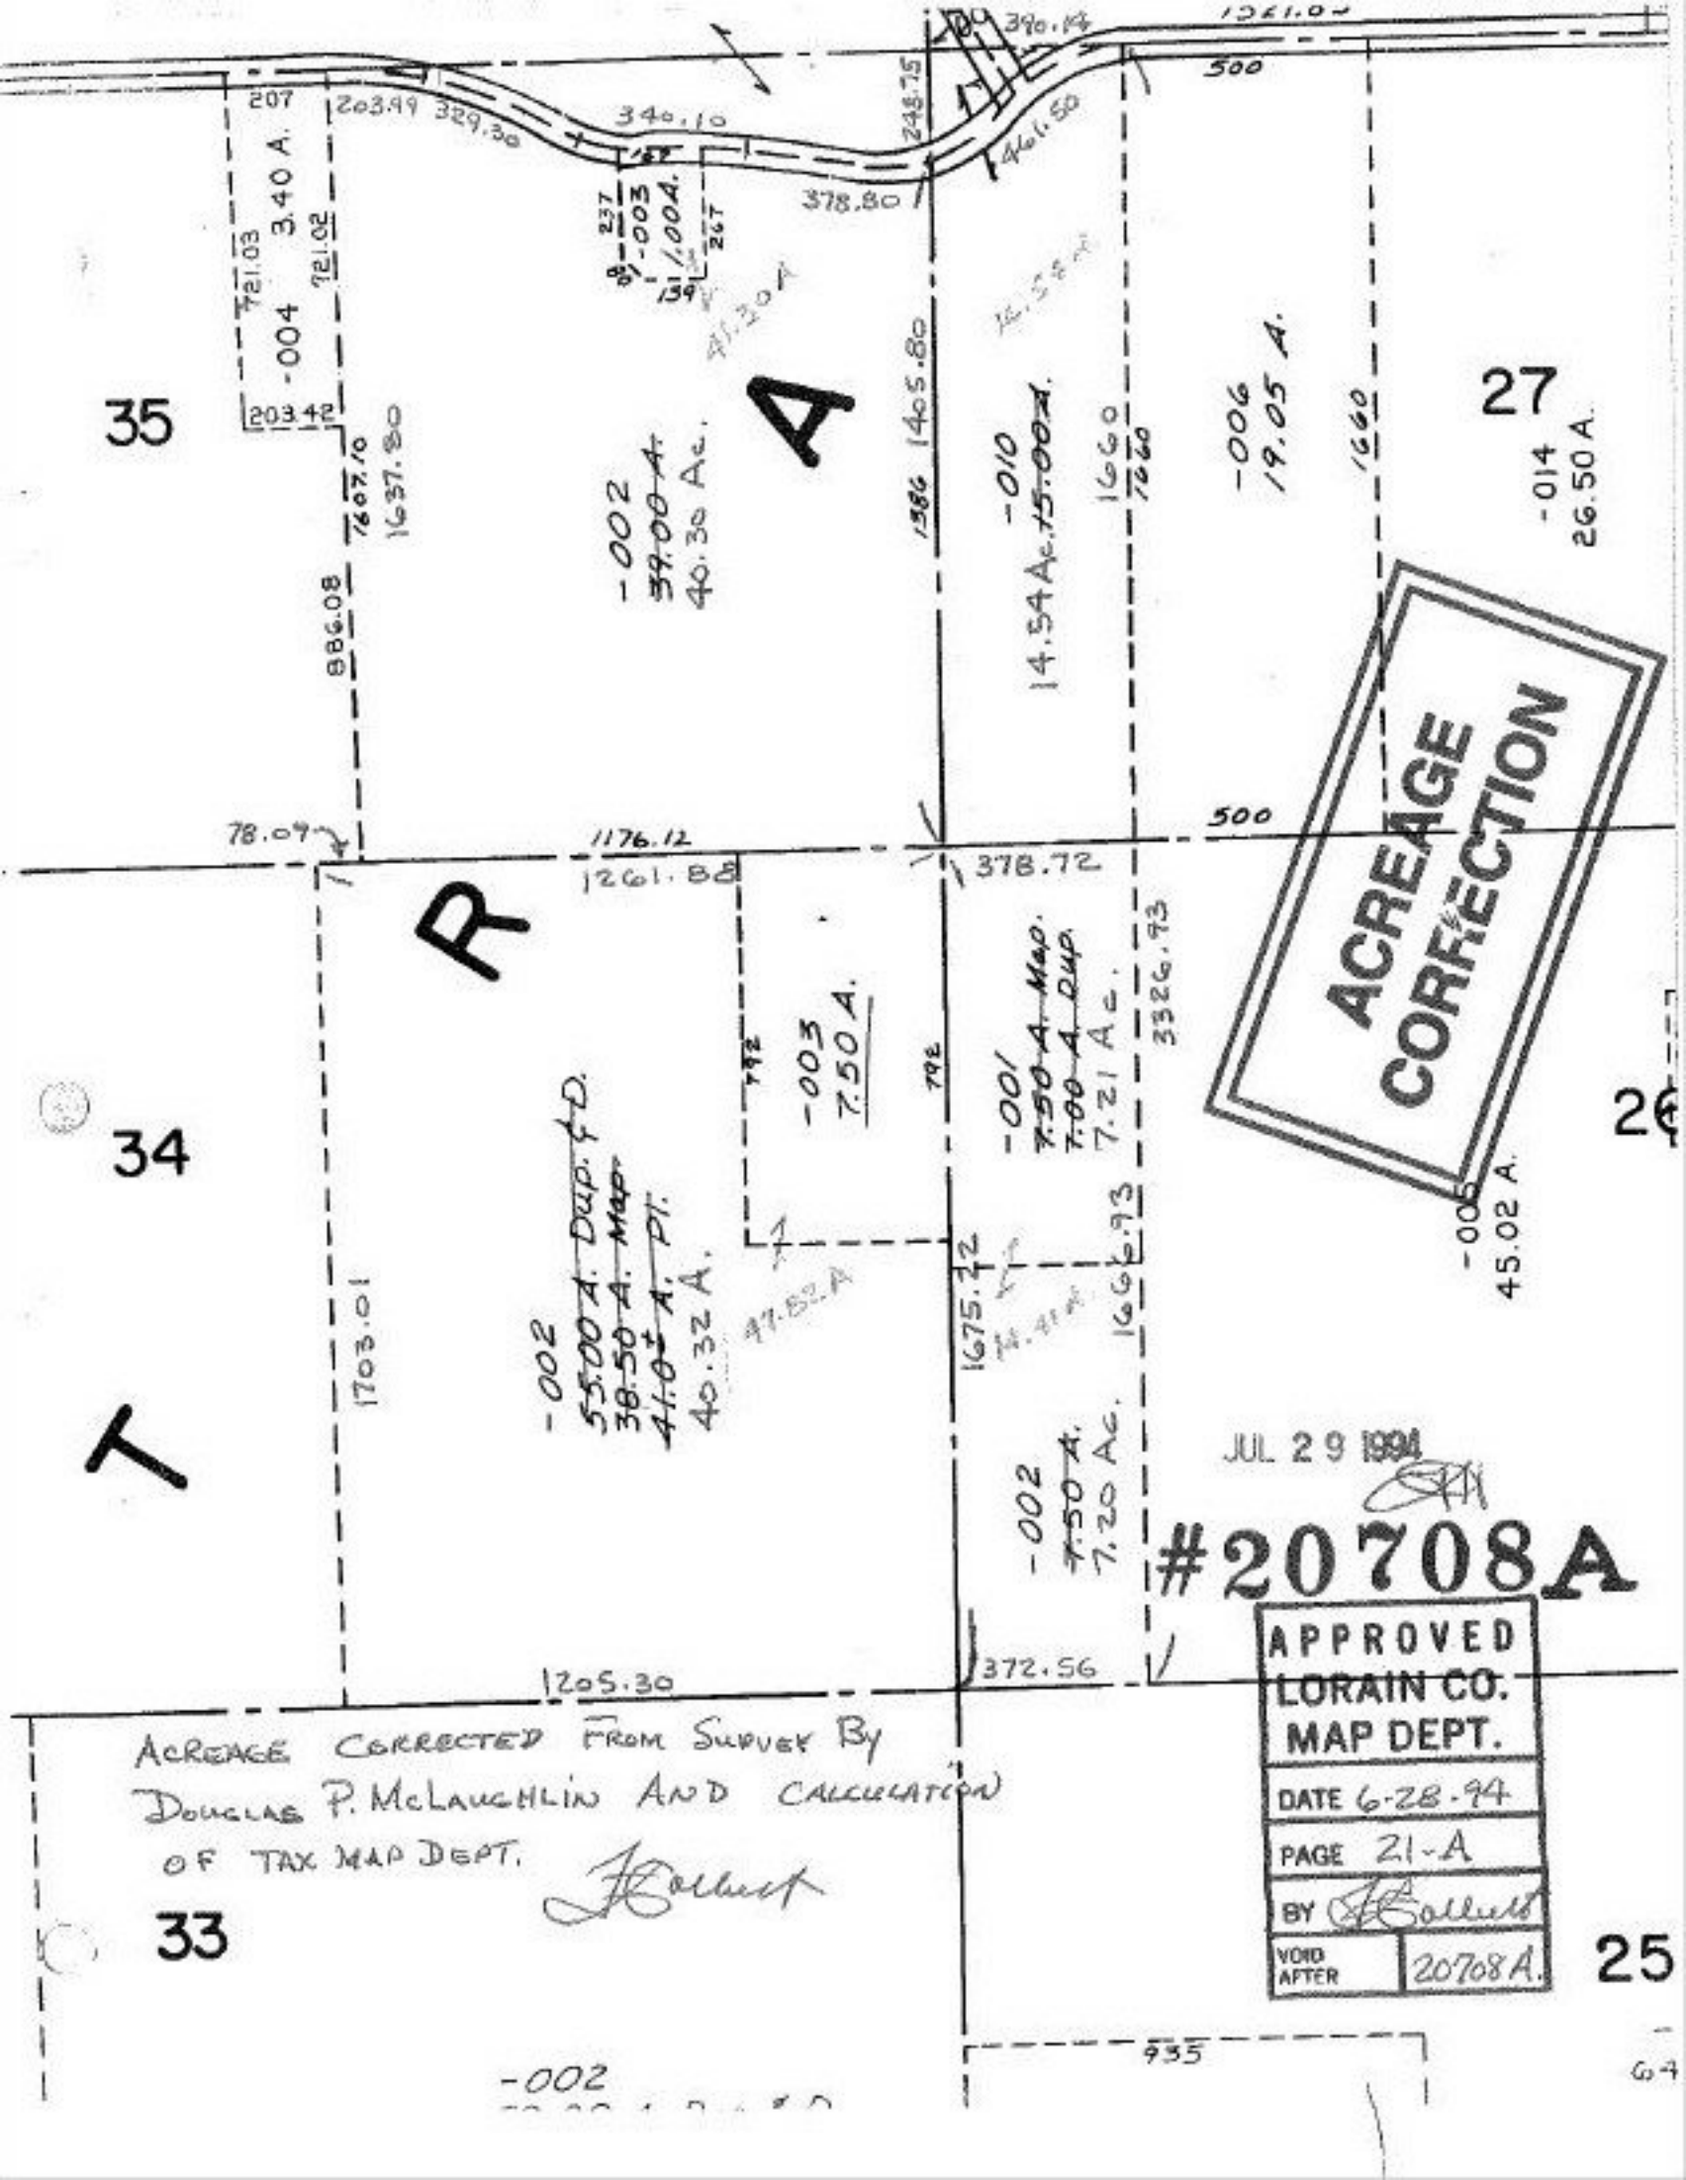

35
34
33
27
26
25
A
R
T
-004 3.40 A.
-002 39.00 A. 40.30 Ac.
-010 14.54 Ac. 15.00 A.
-006 19.05 A.
-014 26.50 A.
-003 7.50 A.
-001 7.50 A. Map. 7.00 A. Dup. 7.21 Ac.
-002 55.00 A. Dup. & D. 38.50 A. Map 41.0± A. Pl. 40.32 A.
-002 7.50 A. 7.20 Ac.
-005 45.02 A.
ACREAGE CORRECTION
JUL 29 1994
#20708A
APPROVED LORAIN CO. MAP DEPT.
DATE 6-28-94
PAGE 21-A
BY
VOID AFTER 20708A.
ACREAGE CORRECTED FROM SURVEY BY DOUGLAS P. McLAUGHLIN AND CALCULATION OF TAX MAP DEPT.