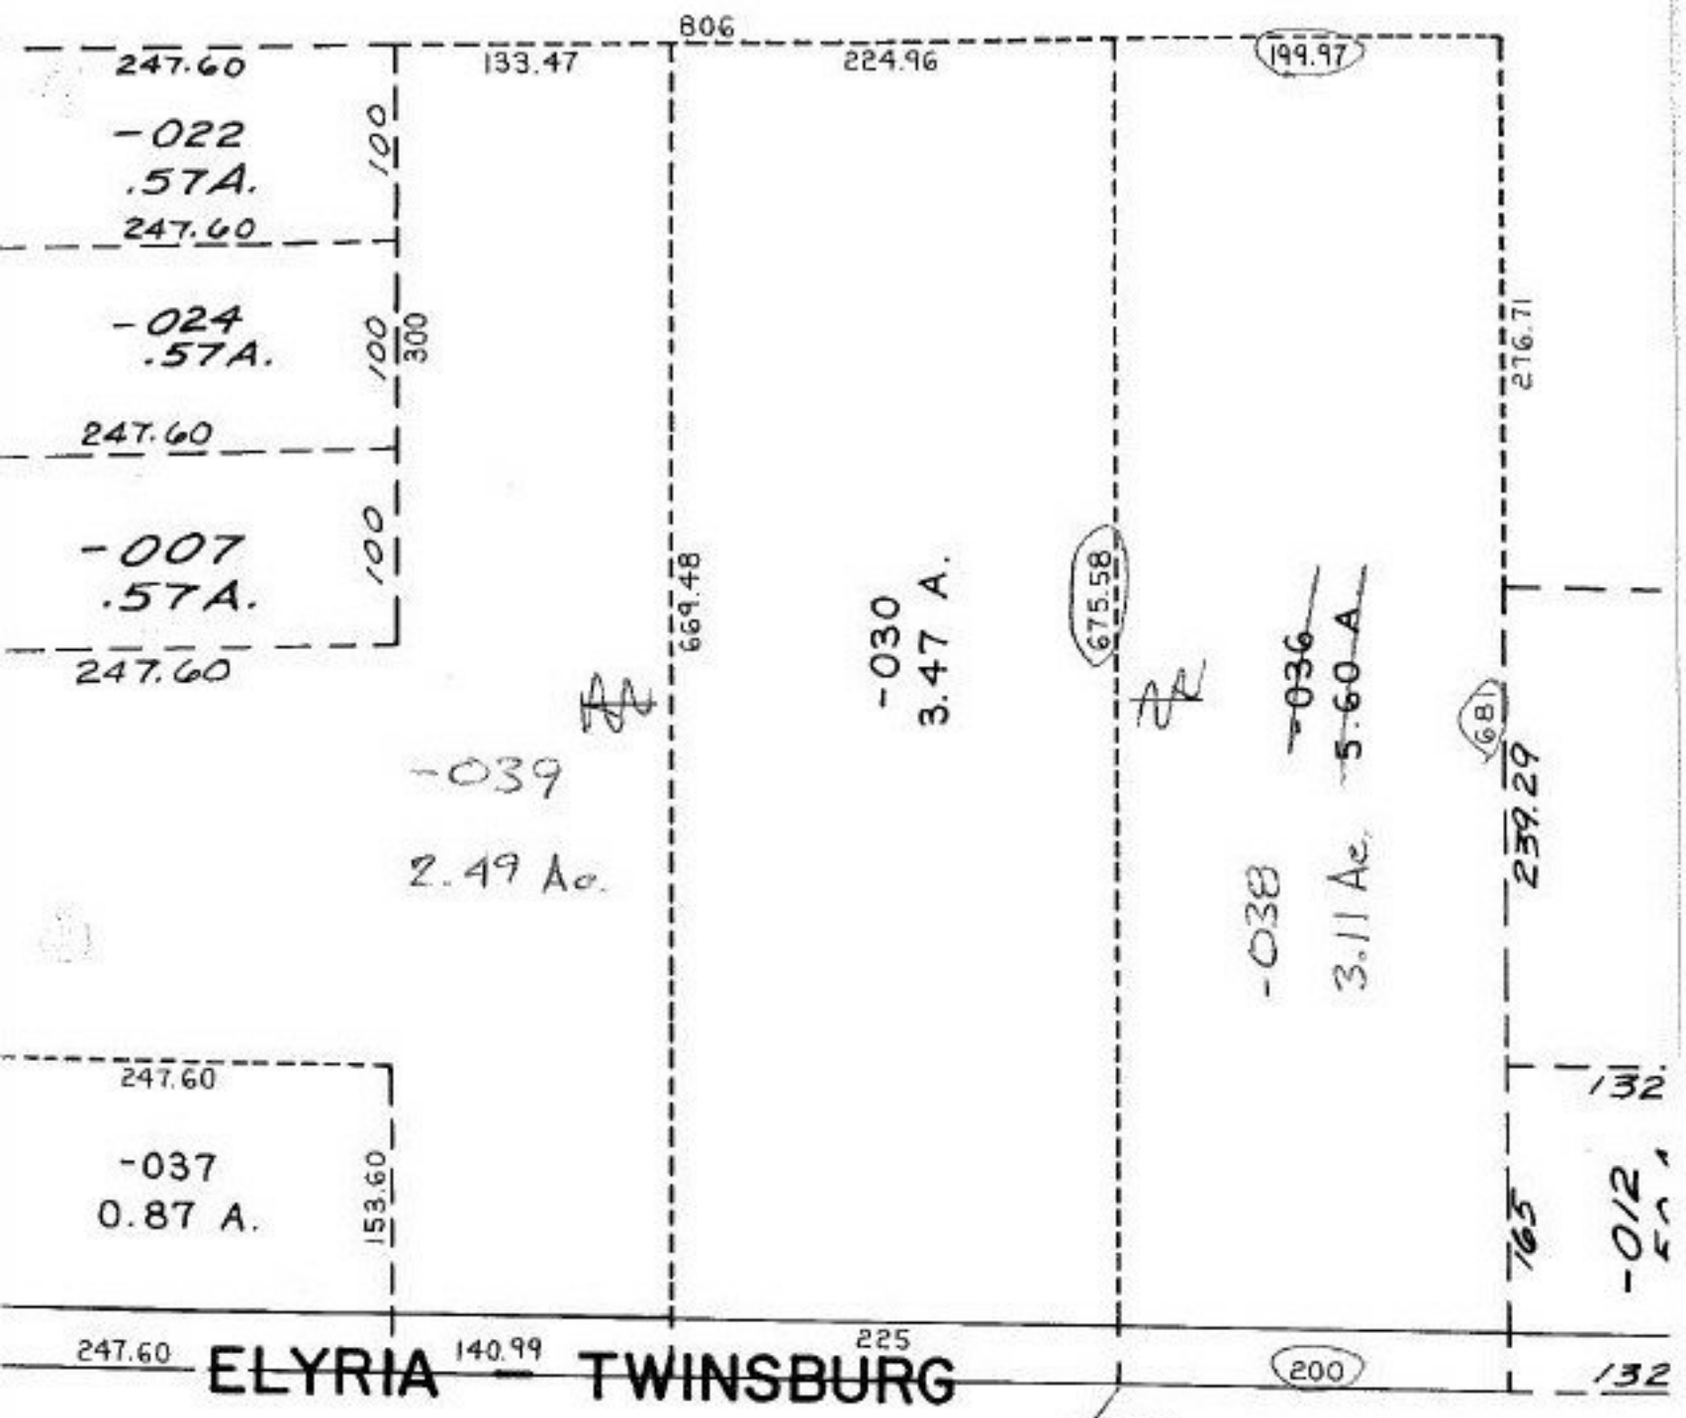


SEE SURVEY BY
CAUGHLIN, SIMKINS, CAHL & ASSOC.
NOVEMBER 1990 ℄ 1:444,352

PRIOR INST REF. - ORV 639, P. 237

AUG 5 1994

APPROVED
LORAIN CO.
MAP DEPT.
DATE 1-26-94
PAGE 11-00046-A
BY T. McClain
VOID AFTER 20709

100 200

# TON TWP