#20710-D

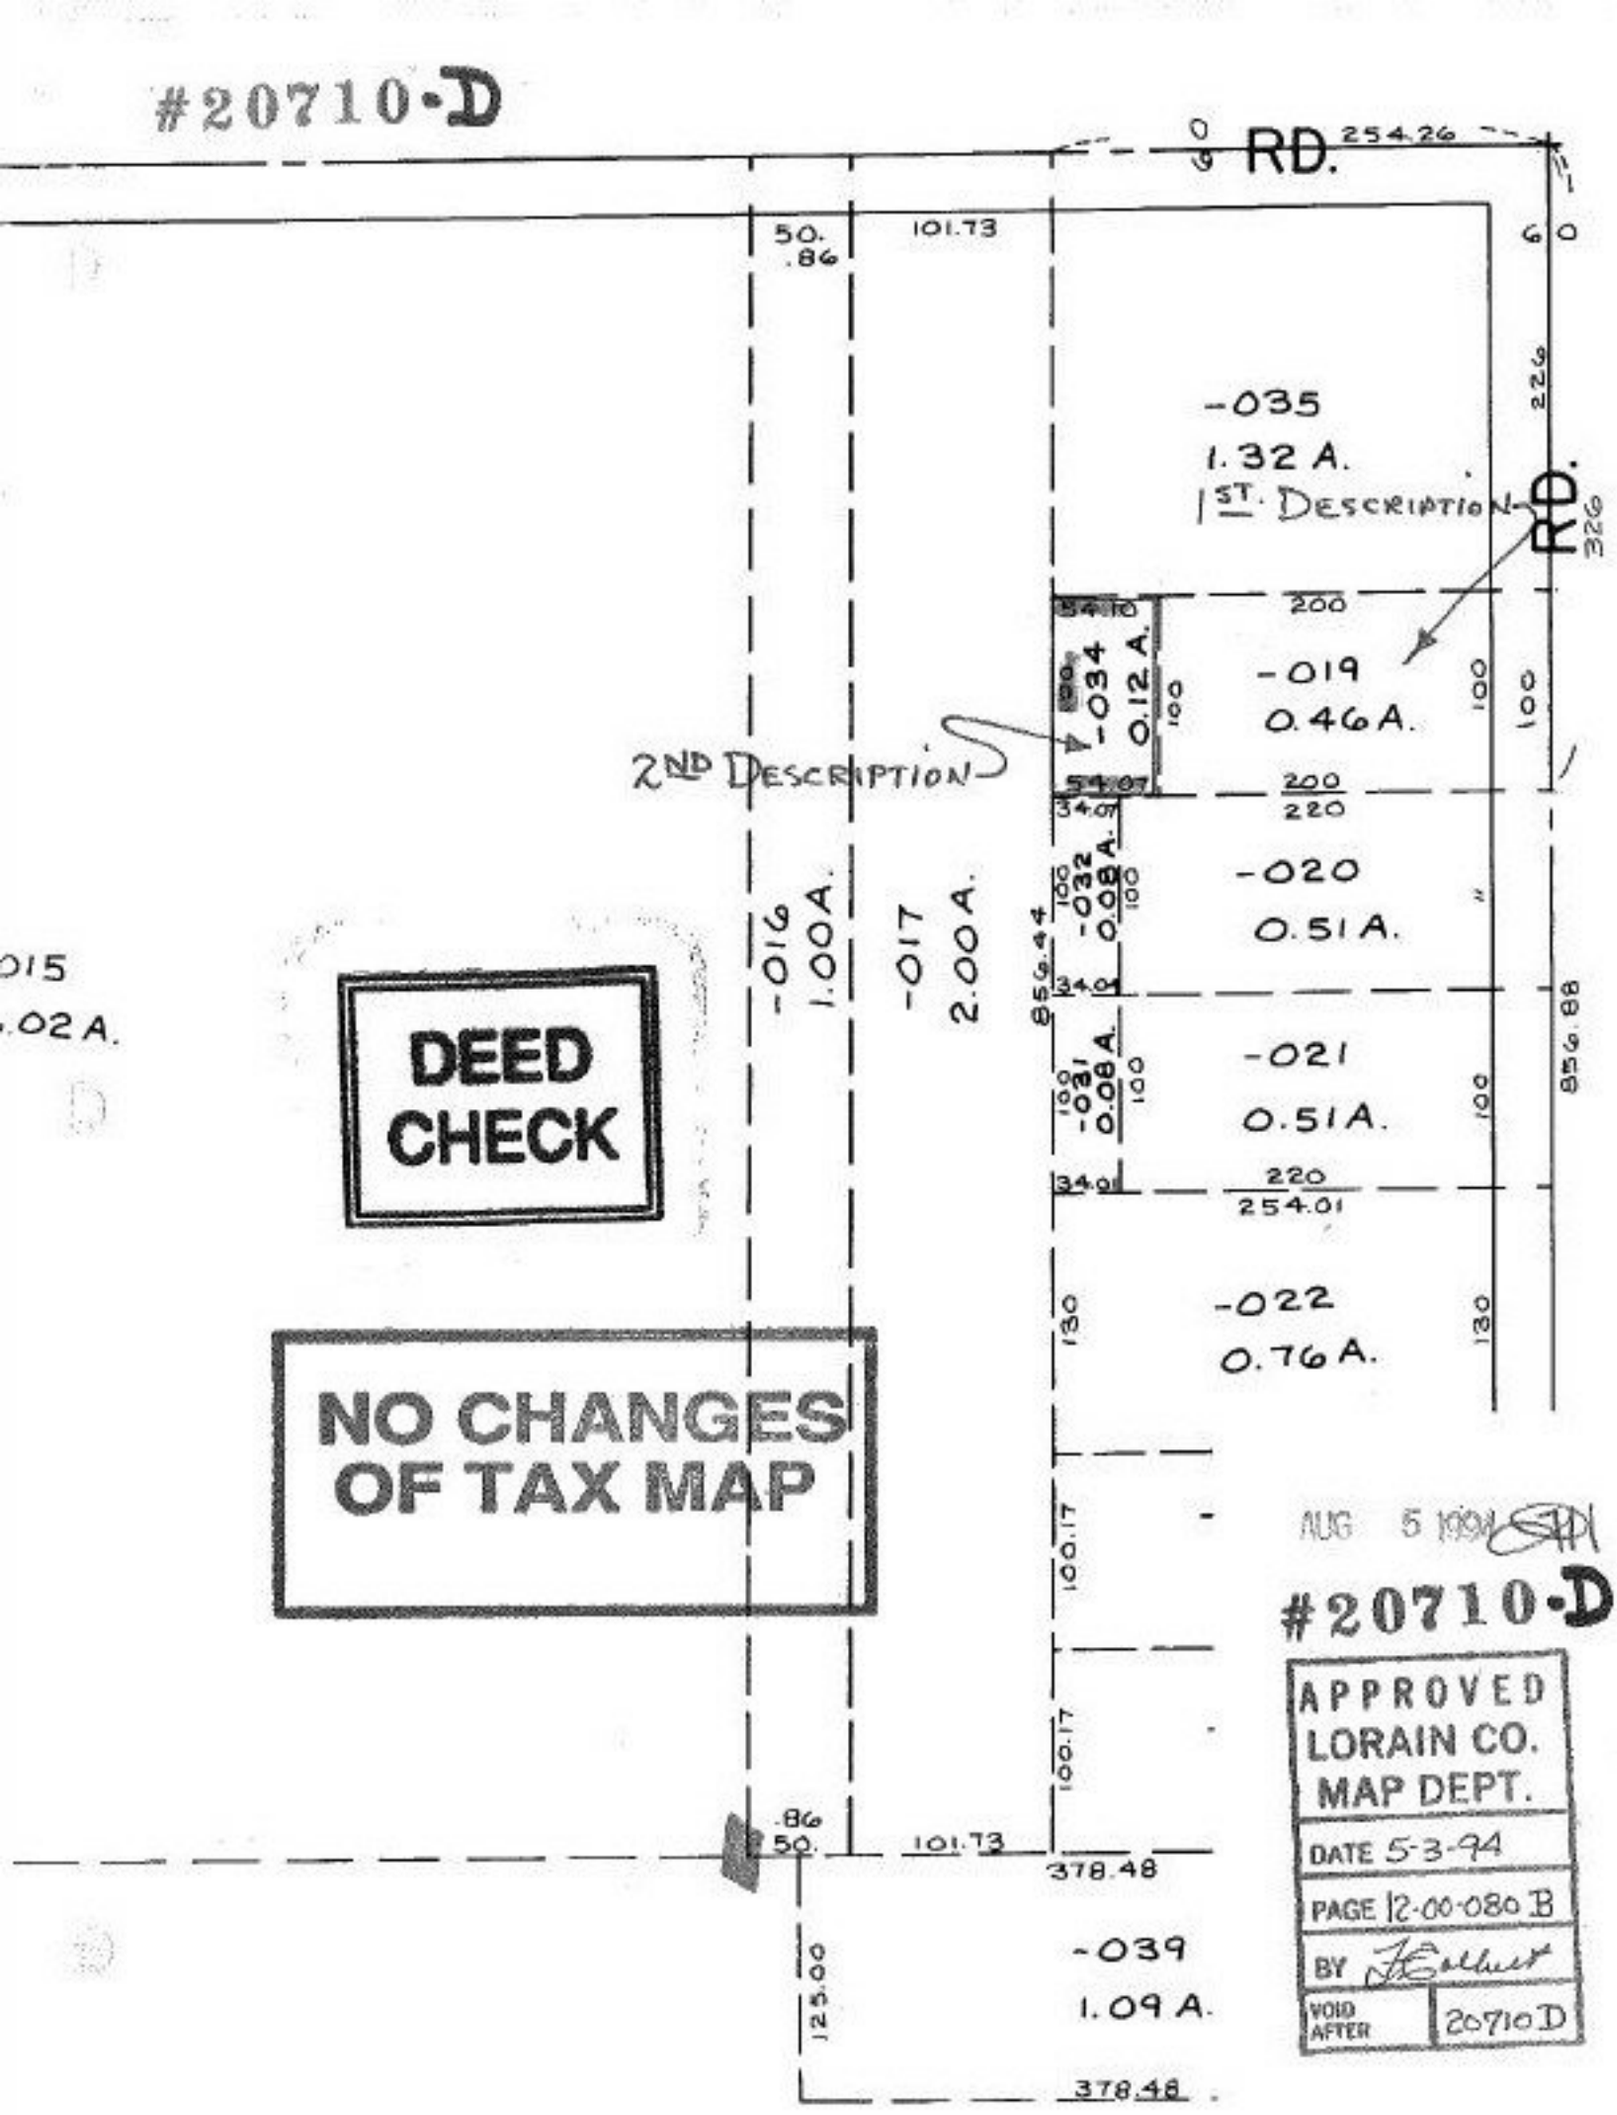

AUG 5 1994

#20710-D

APPROVED
LORAIN CO.
MAP DEPT.
DATE 5-3-94
PAGE 12-00-080 B
BY
VOID AFTER 20710D