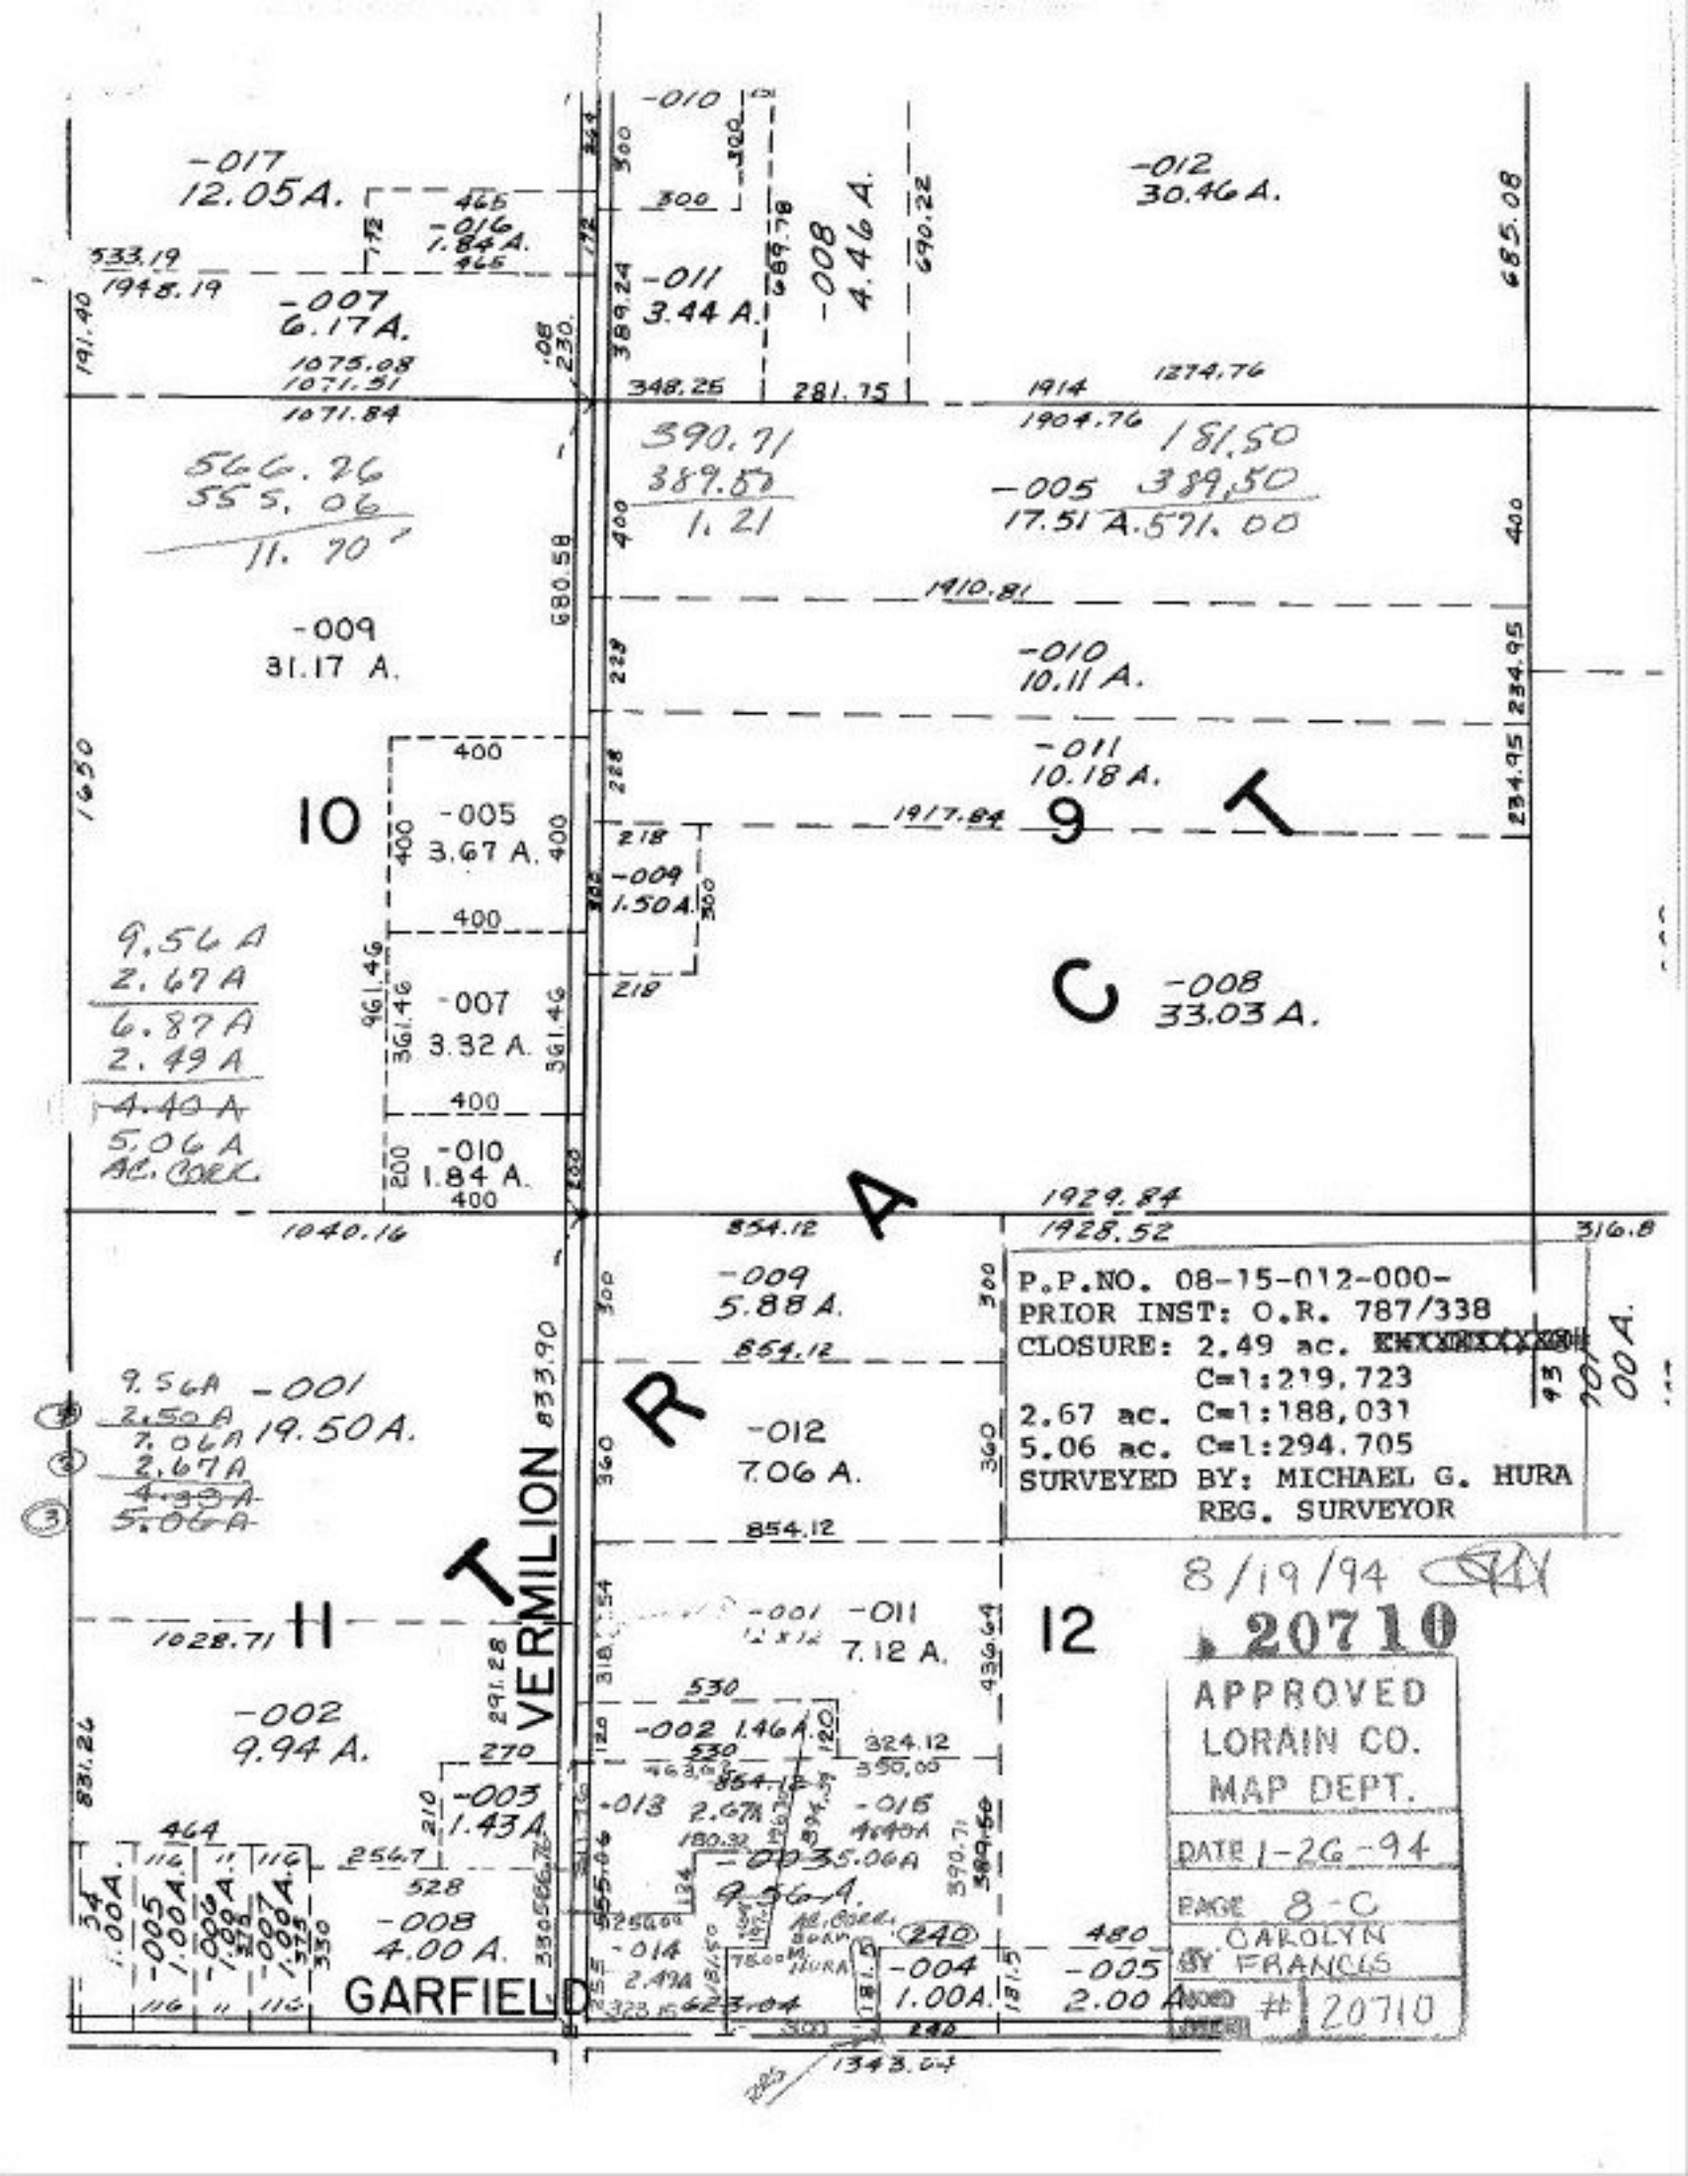
-017
12.05A.
-016
1.84A.
-007
6.17A.
-010
4.46 A.
-011
3.44 A.
-008
-012
30.46 A.
-009
31.17 A.
-005
3.67 A.
-007
3.32 A.
-010
1.84 A.
-009
1.50A.
-010
10.11 A.
-011
10.18 A.
-008
33.03 A.
-005
17.51 A.
-001
19.50A.
-009
5.88 A.
-012
7.06 A.
-001
-011
7.12 A.
-002
9.94 A.
-002 1.46A.
-003
1.43A.
-013
2.67A.
-015
4.40A.
-014
2.49A.
-004
1.00A.
-005
2.00 A.
-008
4.00 A.
-005
1.00A.
-006
1.00A.
-007
1.00A.
9.56A
2.67A
6.87A
2.49A
4.40A
5.06A
AC. CORK.
9.56A.
AC. CORK.
BOOM
M. HURA
10
9
C
A
R
T
VERMILION
GARFIELD
P.P.NO. 08-15-012-000-
PRIOR INST: O.R. 787/338
CLOSURE: 2.49 ac.
C=1:219,723
2.67 ac. C=1:188,031
5.06 ac. C=1:294.705
SURVEYED BY: MICHAEL G. HURA
REG. SURVEYOR
8/19/94
20710
APPROVED
LORAIN CO.
MAP DEPT.
DATE 1-26-94
PAGE 8-C
BY CAROLYN FRANCIS
ASSGD # 20710