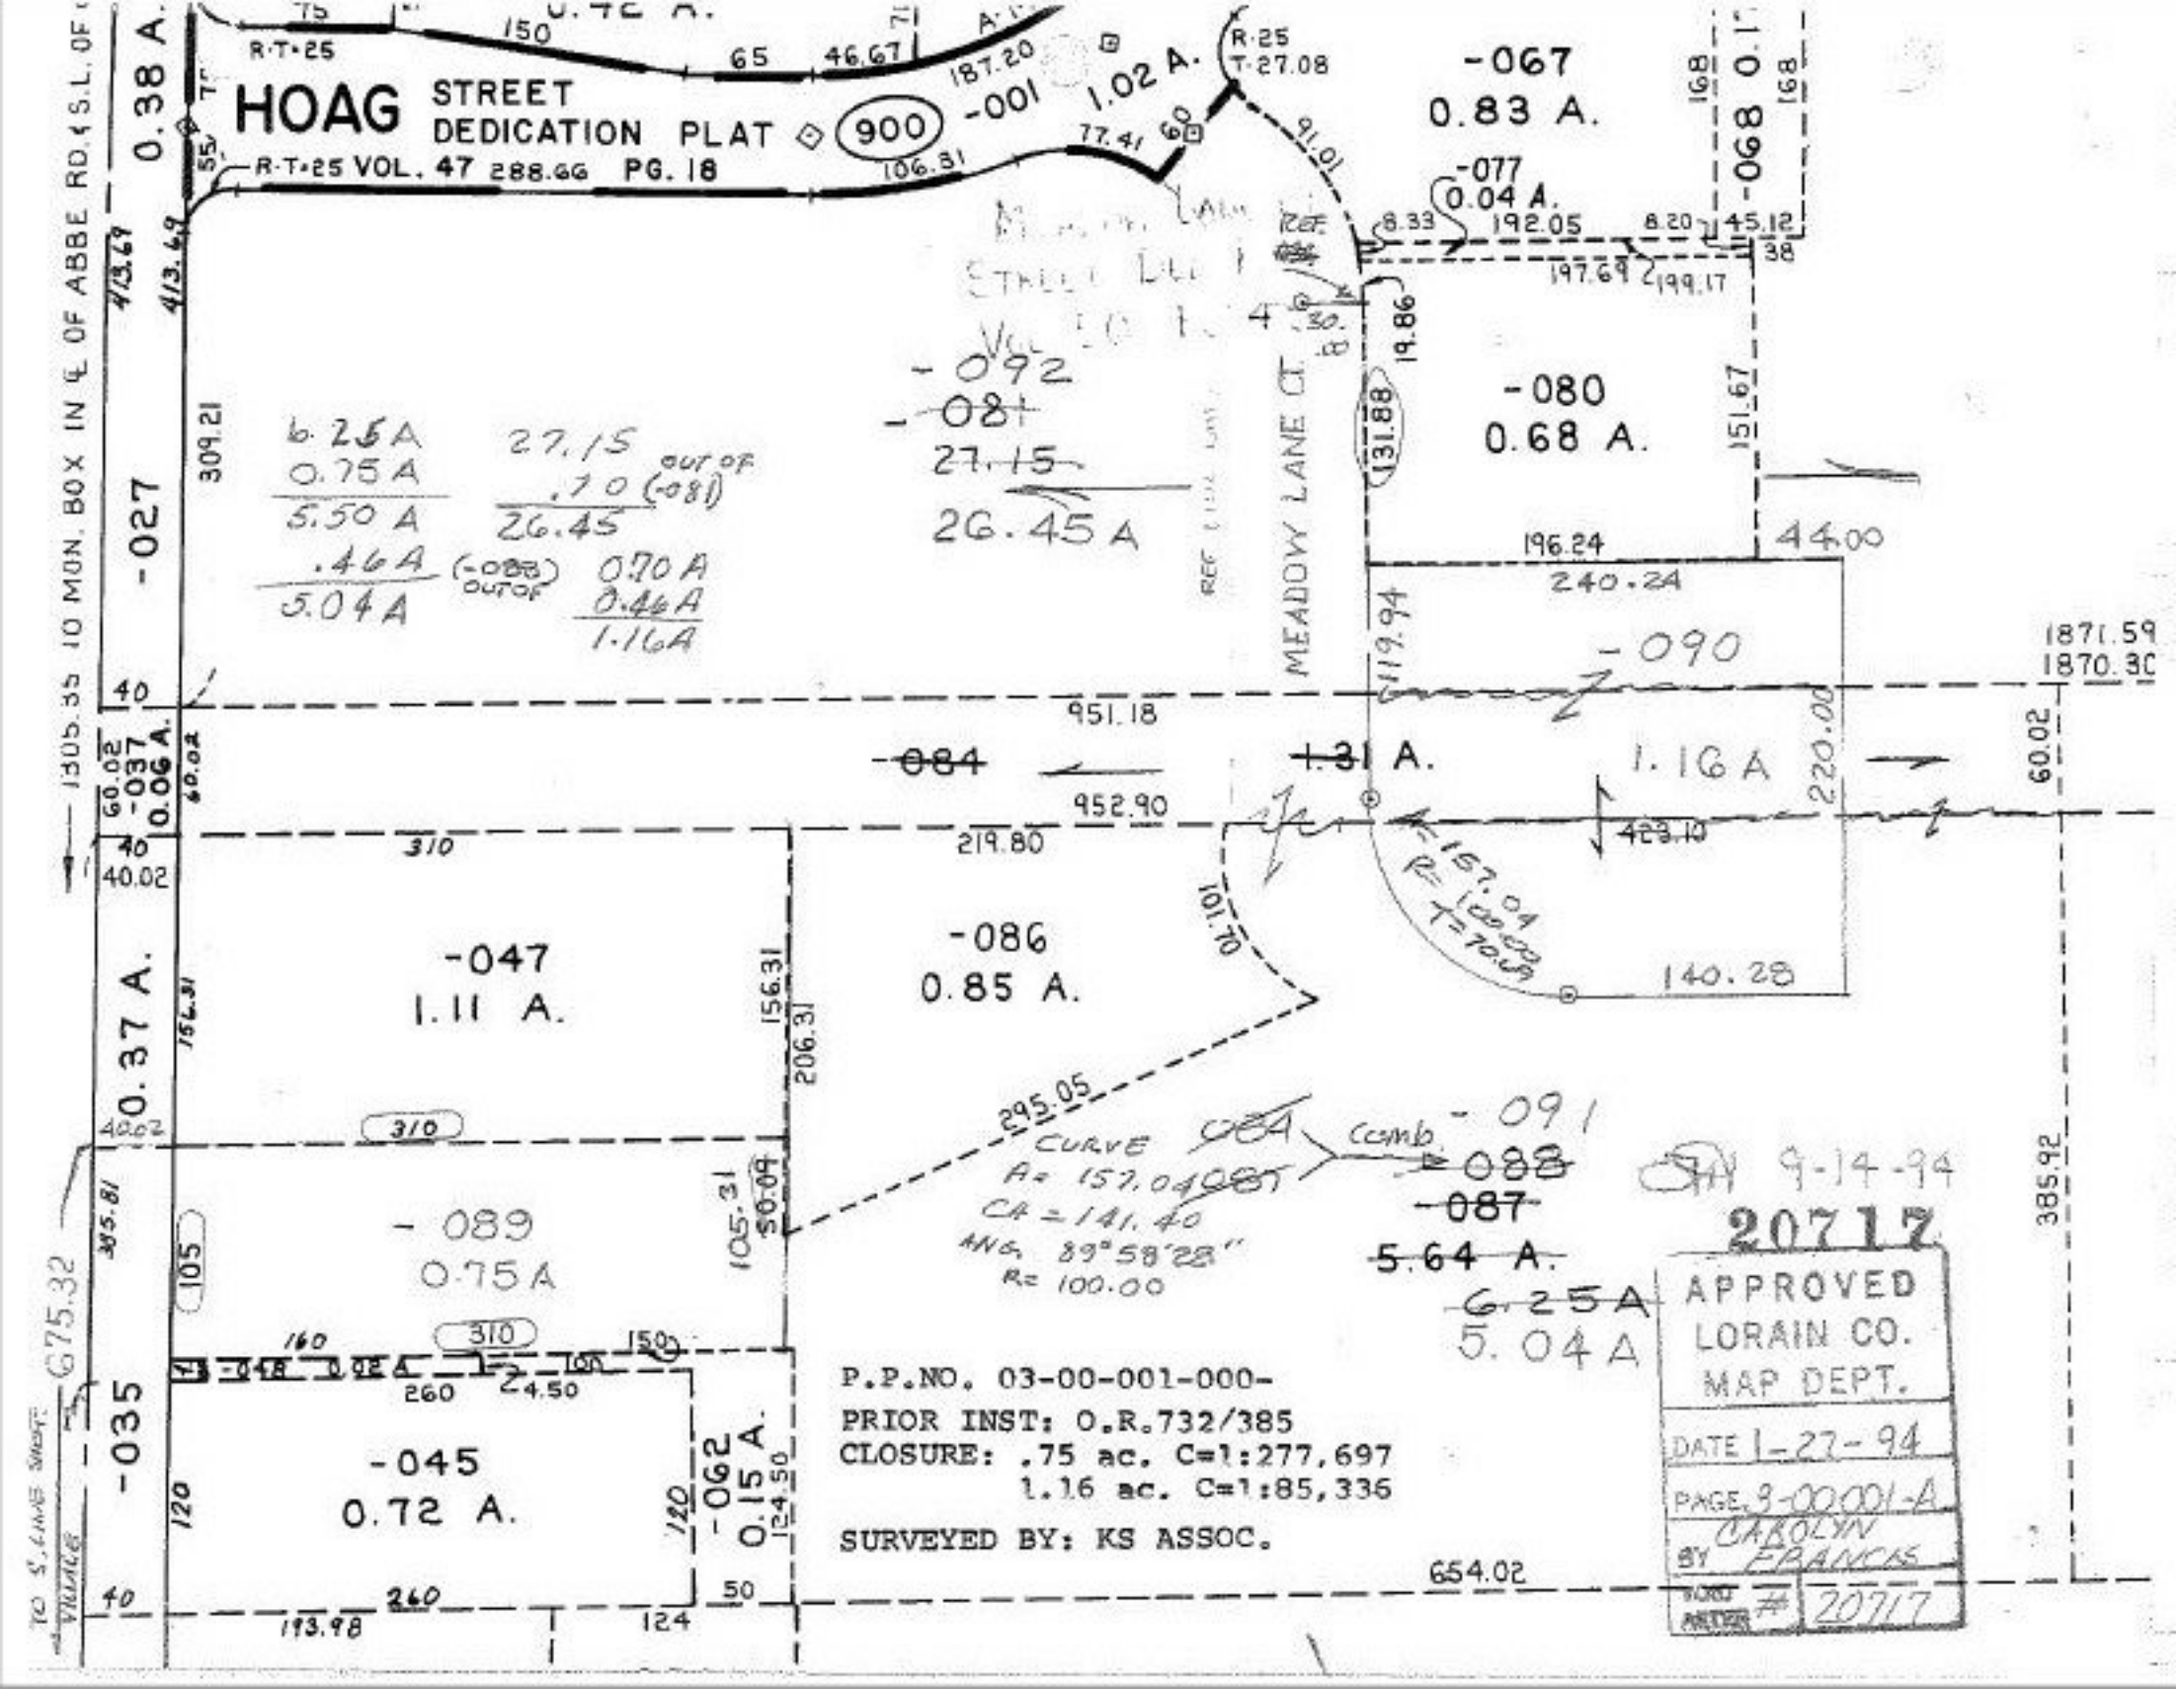
HOAG STREET DEDICATION PLAT 900
R-T-25 VOL. 47 288.66 PG. 18
MEADOW LANE CT.
-027
-035
-037
0.06 A.
-045
0.72 A.
-047
1.11 A.
-086
0.85 A.
-089
0.75 A.
-062
0.15 A.
-067
0.83 A.
-068
-077
0.04 A.
-080
0.68 A.
-090
1.16 A.
-091
5.04 A.
-092
-084
-088
-087
5.64 A.
26.45 A.
0.38 A.
1.02 A.
-001
0.37 A.
CURVE DATA
A= 157.04
CH= 141.40
ANG 89°58'23"
R= 100.00
P.P.NO. 03-00-001-000-
PRIOR INST: O.R.732/385
CLOSURE: .75 ac. C=1:277,697
1.16 ac. C=1:85,336
SURVEYED BY: KS ASSOC.
APPROVED
LORAIN CO.
MAP DEPT.
DATE 1-27-94
PAGE 3-00001-A
BY CAROLYN FRANCIS
PLAT NUMBER # 20717
9-14-94
20717
TO ST. ANNE SHRINE
VILLAGE