


SEE 15-C

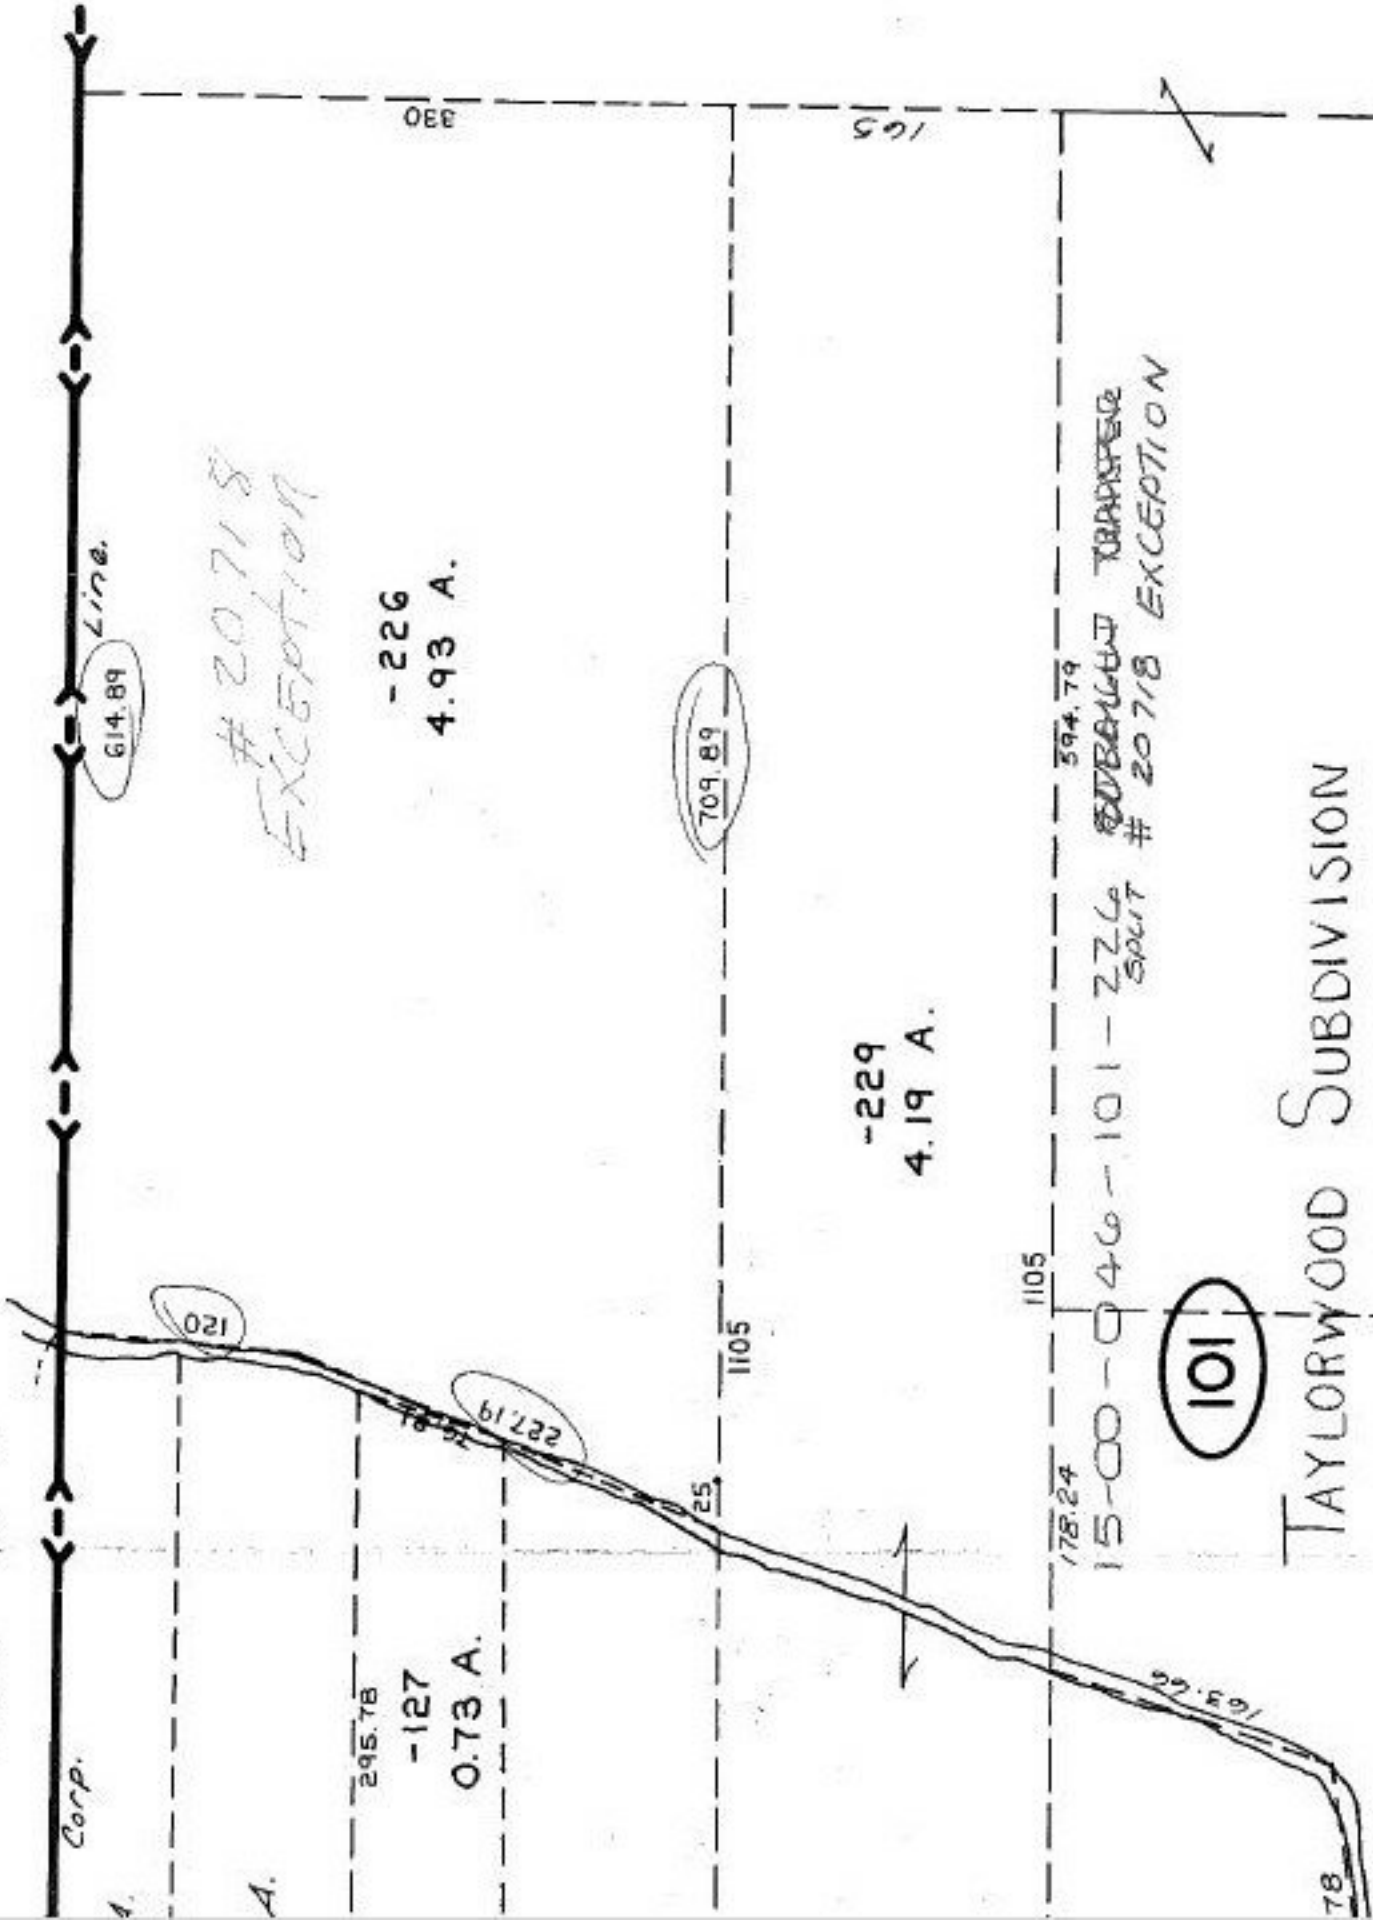

# 20718  
EXCEPTION

-226  
4.93 A.

-229  
4.19 A.


TAYLORWOOD SUBDIVISION

VOL. 48 Pgs. 67 & 68 of -125