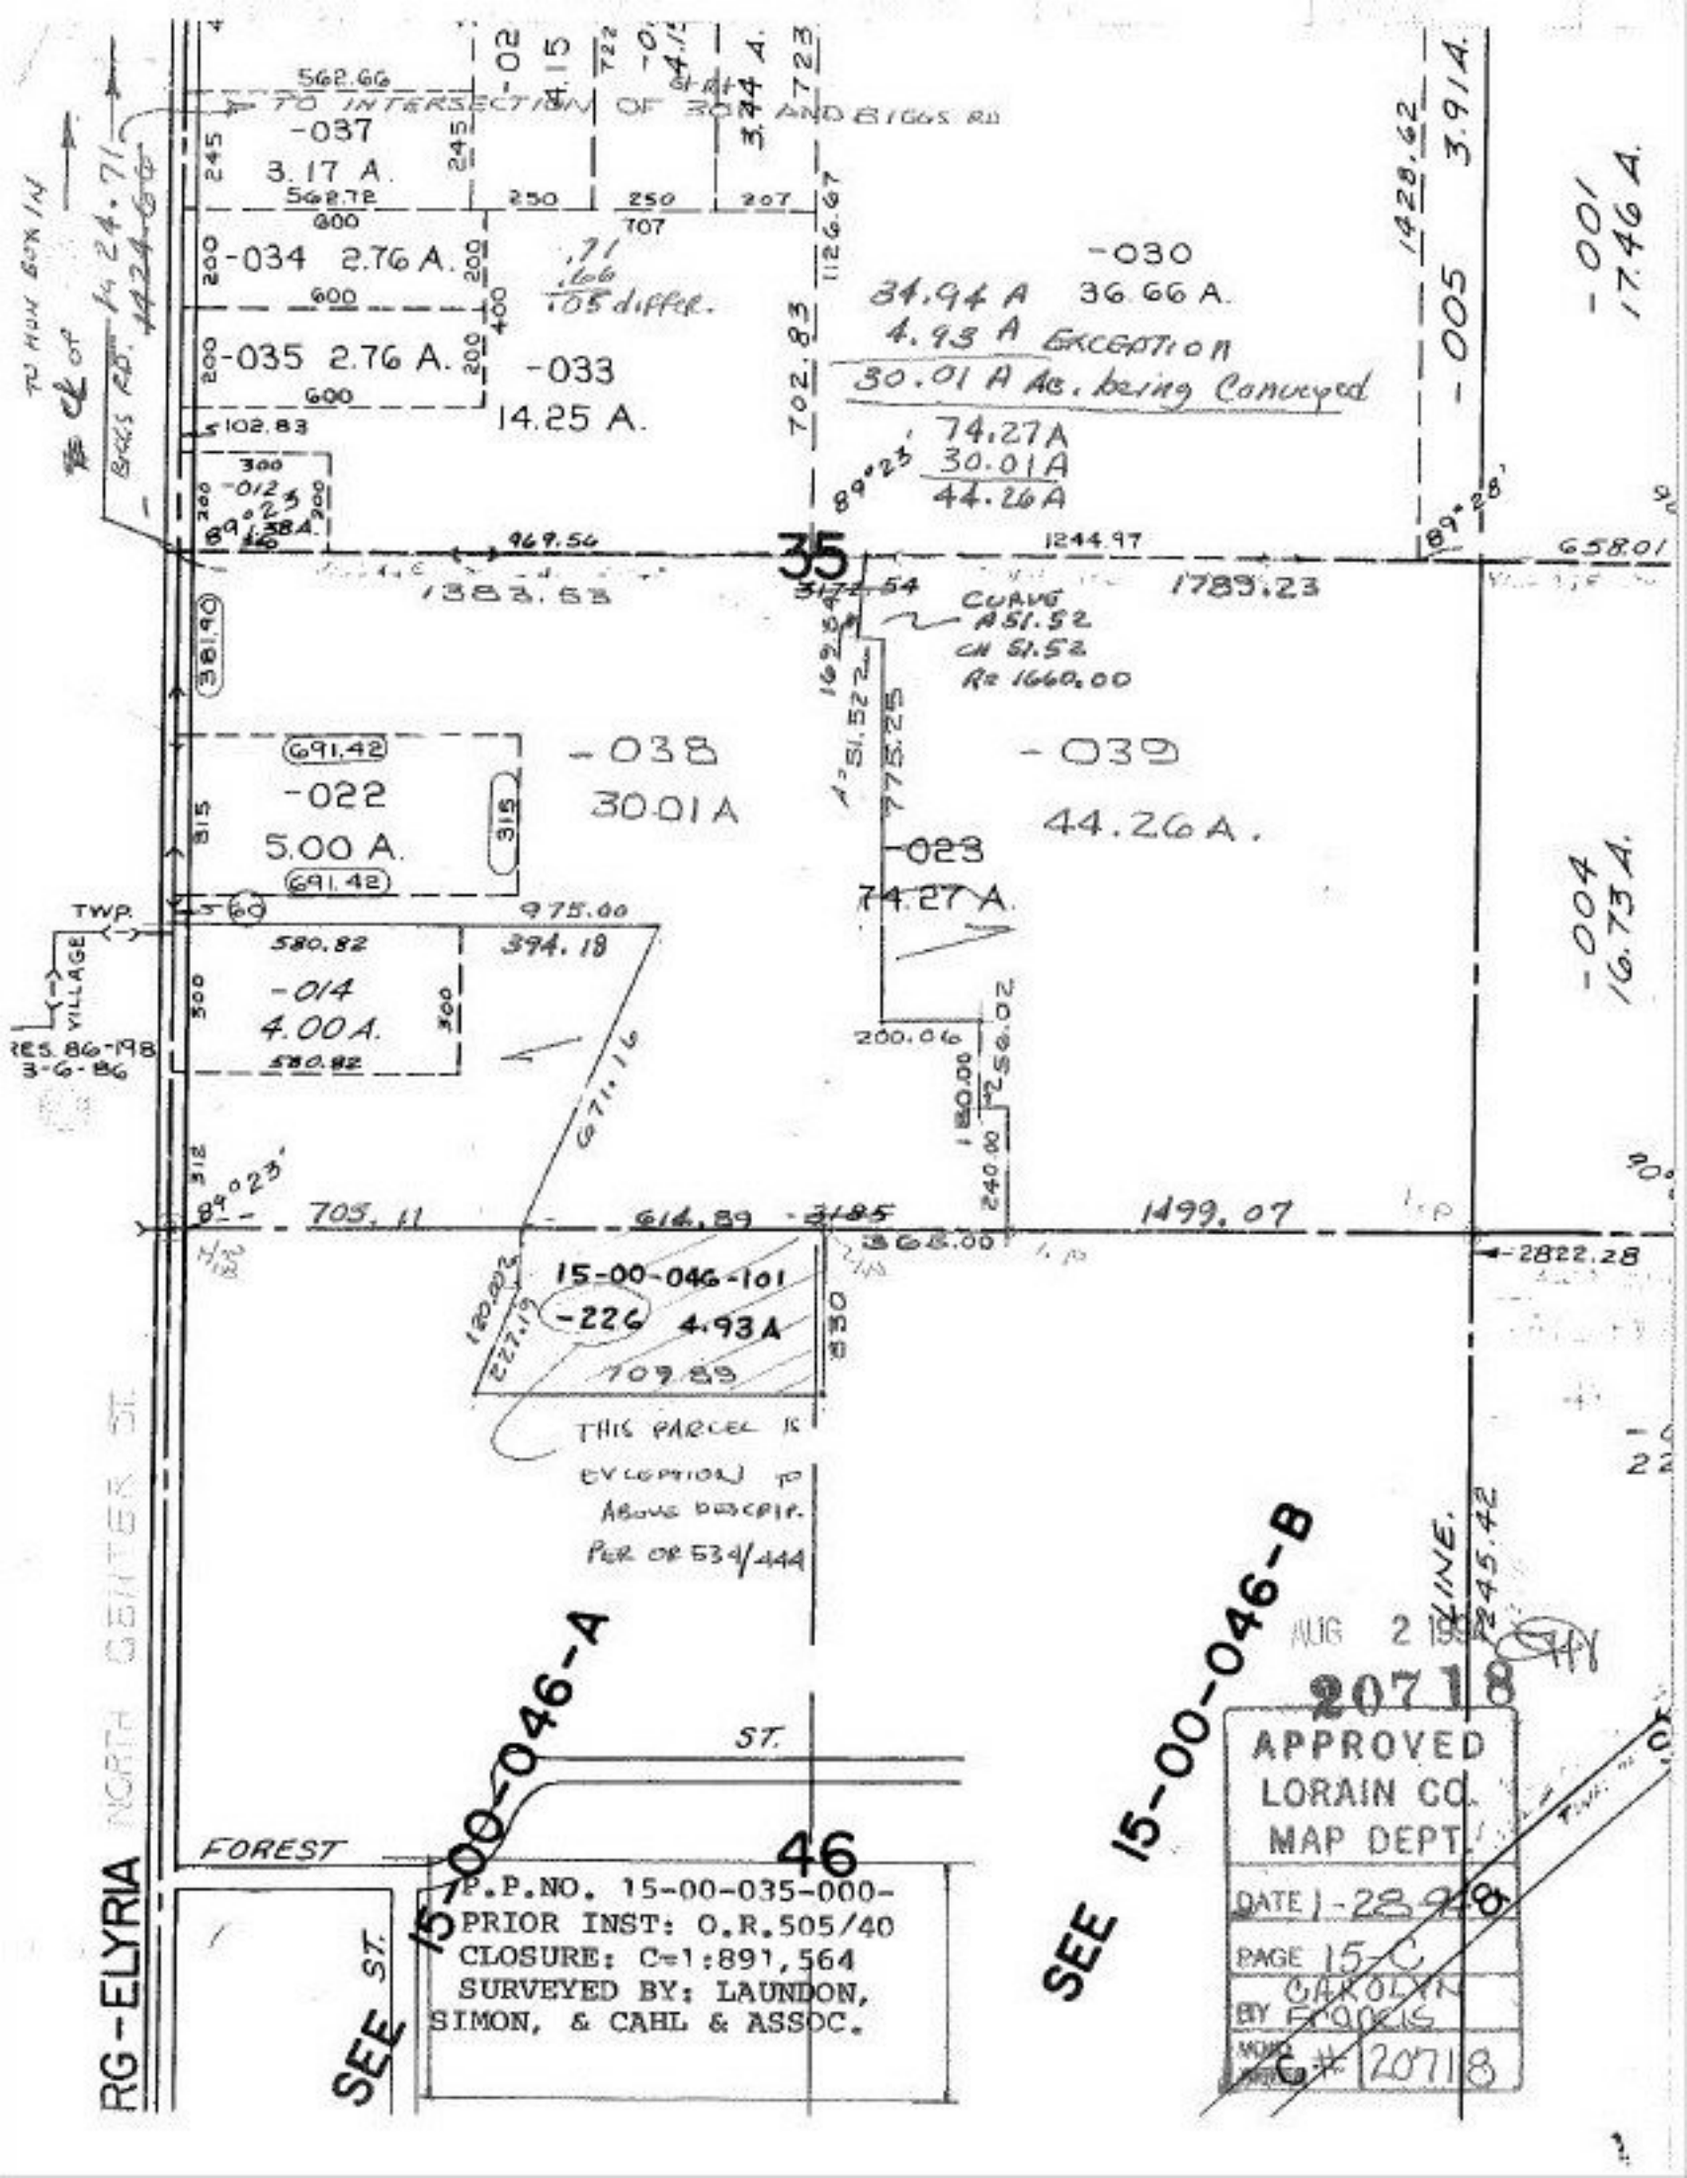
TO INTERSECTION OF 303 AND BIGGS RD
-037
3.17 A.
-034 2.76 A.
-035 2.76 A.
-033
14.25 A.
-030
34.94 A 36.66 A.
4.93 A EXCEPTION
30.01 A Ac. being Conveyed
74.27A
30.01A
44.26A
-001
17.46 A.
-005
3.914.
-038
30.01A
-039
44.26A.
-022
5.00 A.
-023
74.27 A.
-004
16.734.
-014
4.00A.
35
46
15-00-046-101
-226 4.93A
THIS PARCEL IS EXCEPTION TO ABOVE DESCRIP. PER OR 534/444
TWP.
VILLAGE
RES. 86-198 3-6-86
BIGGS RD.
RG-ELYRIA
NORTH GBITER ST.
FOREST
ST.
SEE 15-00-046-A
SEE 15-00-046-B
P.P.NO. 15-00-035-000-
PRIOR INST: O.R.505/40
CLOSURE: C=1:891,564
SURVEYED BY: LAUNDON, SIMON, & CAHL & ASSOC.
AUG 2 1
20718
APPROVED
LORAIN CO.
MAP DEPT.
DATE 1-28-98
PAGE 15-C
BY CAROLYN FRANCIS
MAP # 20718