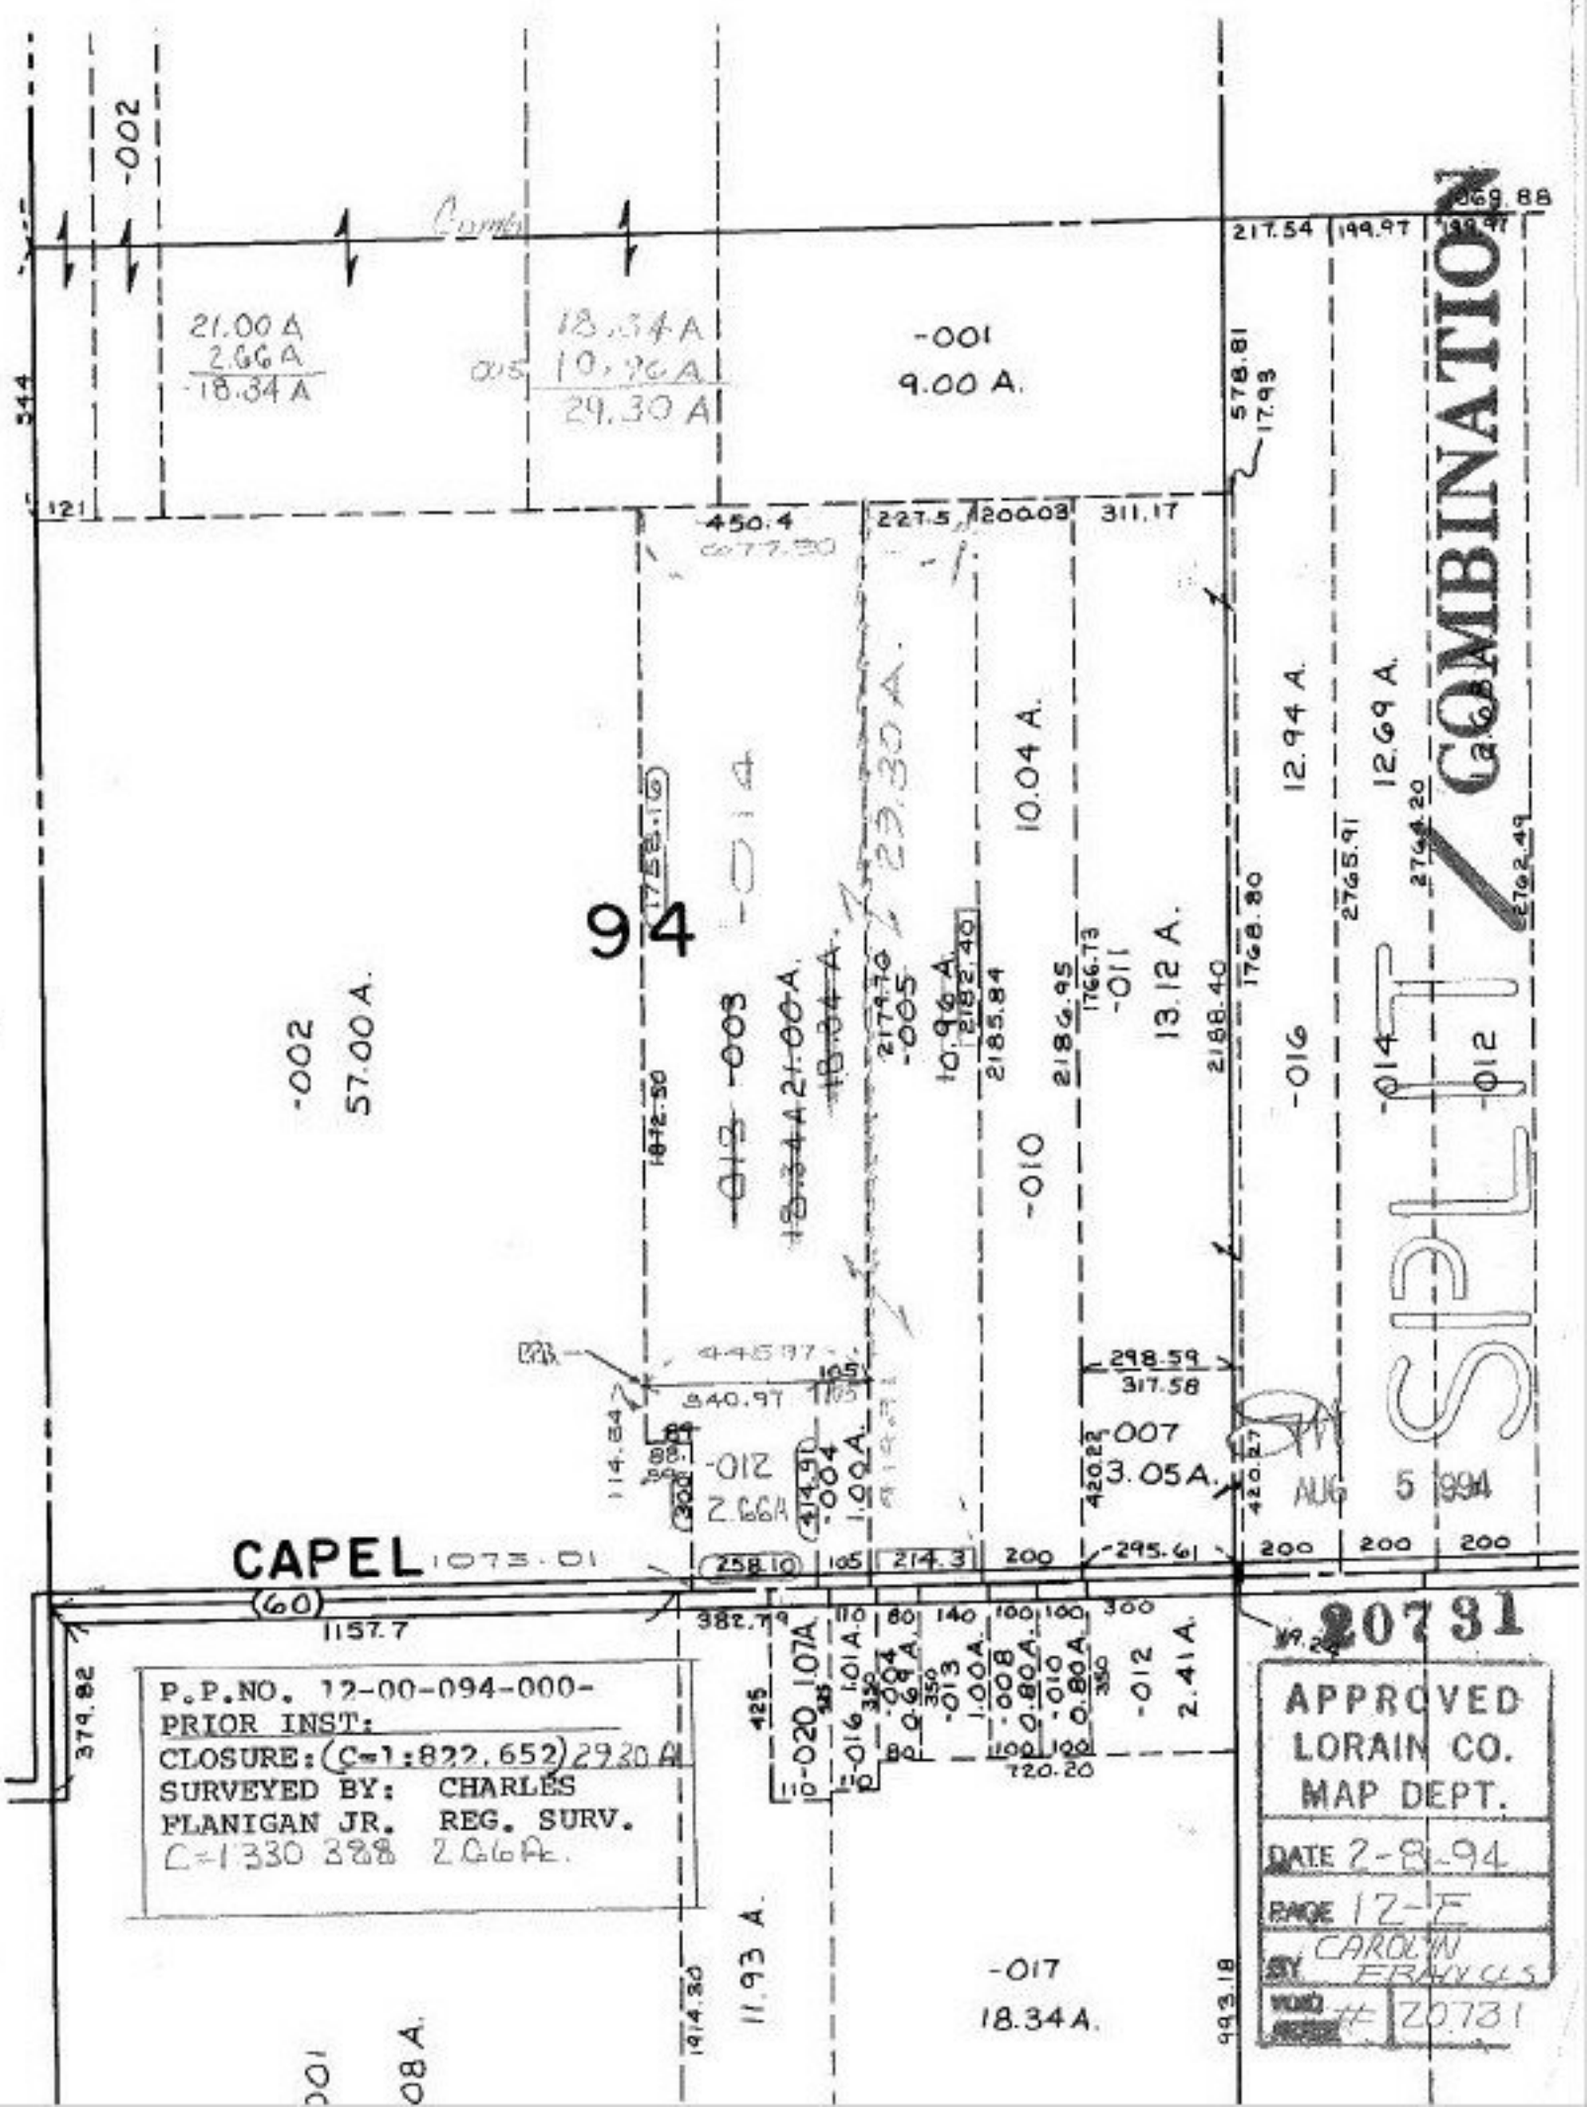
COMBINATION
CAPEL
94
-002
57.00 A.
-003
-004
1.02 A.
-005
10.96 A.
-010
10.04 A.
-011
13.12 A.
-012
2.66 A.
-013
1.00 A.
-014
-016
12.94 A.
12.69 A.
-017
18.34 A.
11.93 A.
-020
1.07 A.
-007
3.05 A.
2.41 A.
21.00 A
2.66 A
18.34 A
18.34 A
10.96 A
29.30 A
9.00 A.
P.P.NO. 12-00-094-000-
PRIOR INST:
CLOSURE: (C=1:822.652) 2920 A
SURVEYED BY: CHARLES
PLANIGAN JR. REG. SURV.
C-1330 388 2.66A.
APPROVED
LORAIN CO.
MAP DEPT.
DATE 2-8-94
PAGE 12-E
BY CAROLYN FRANCIS
VOID
20731
AUG 5 1994
20731