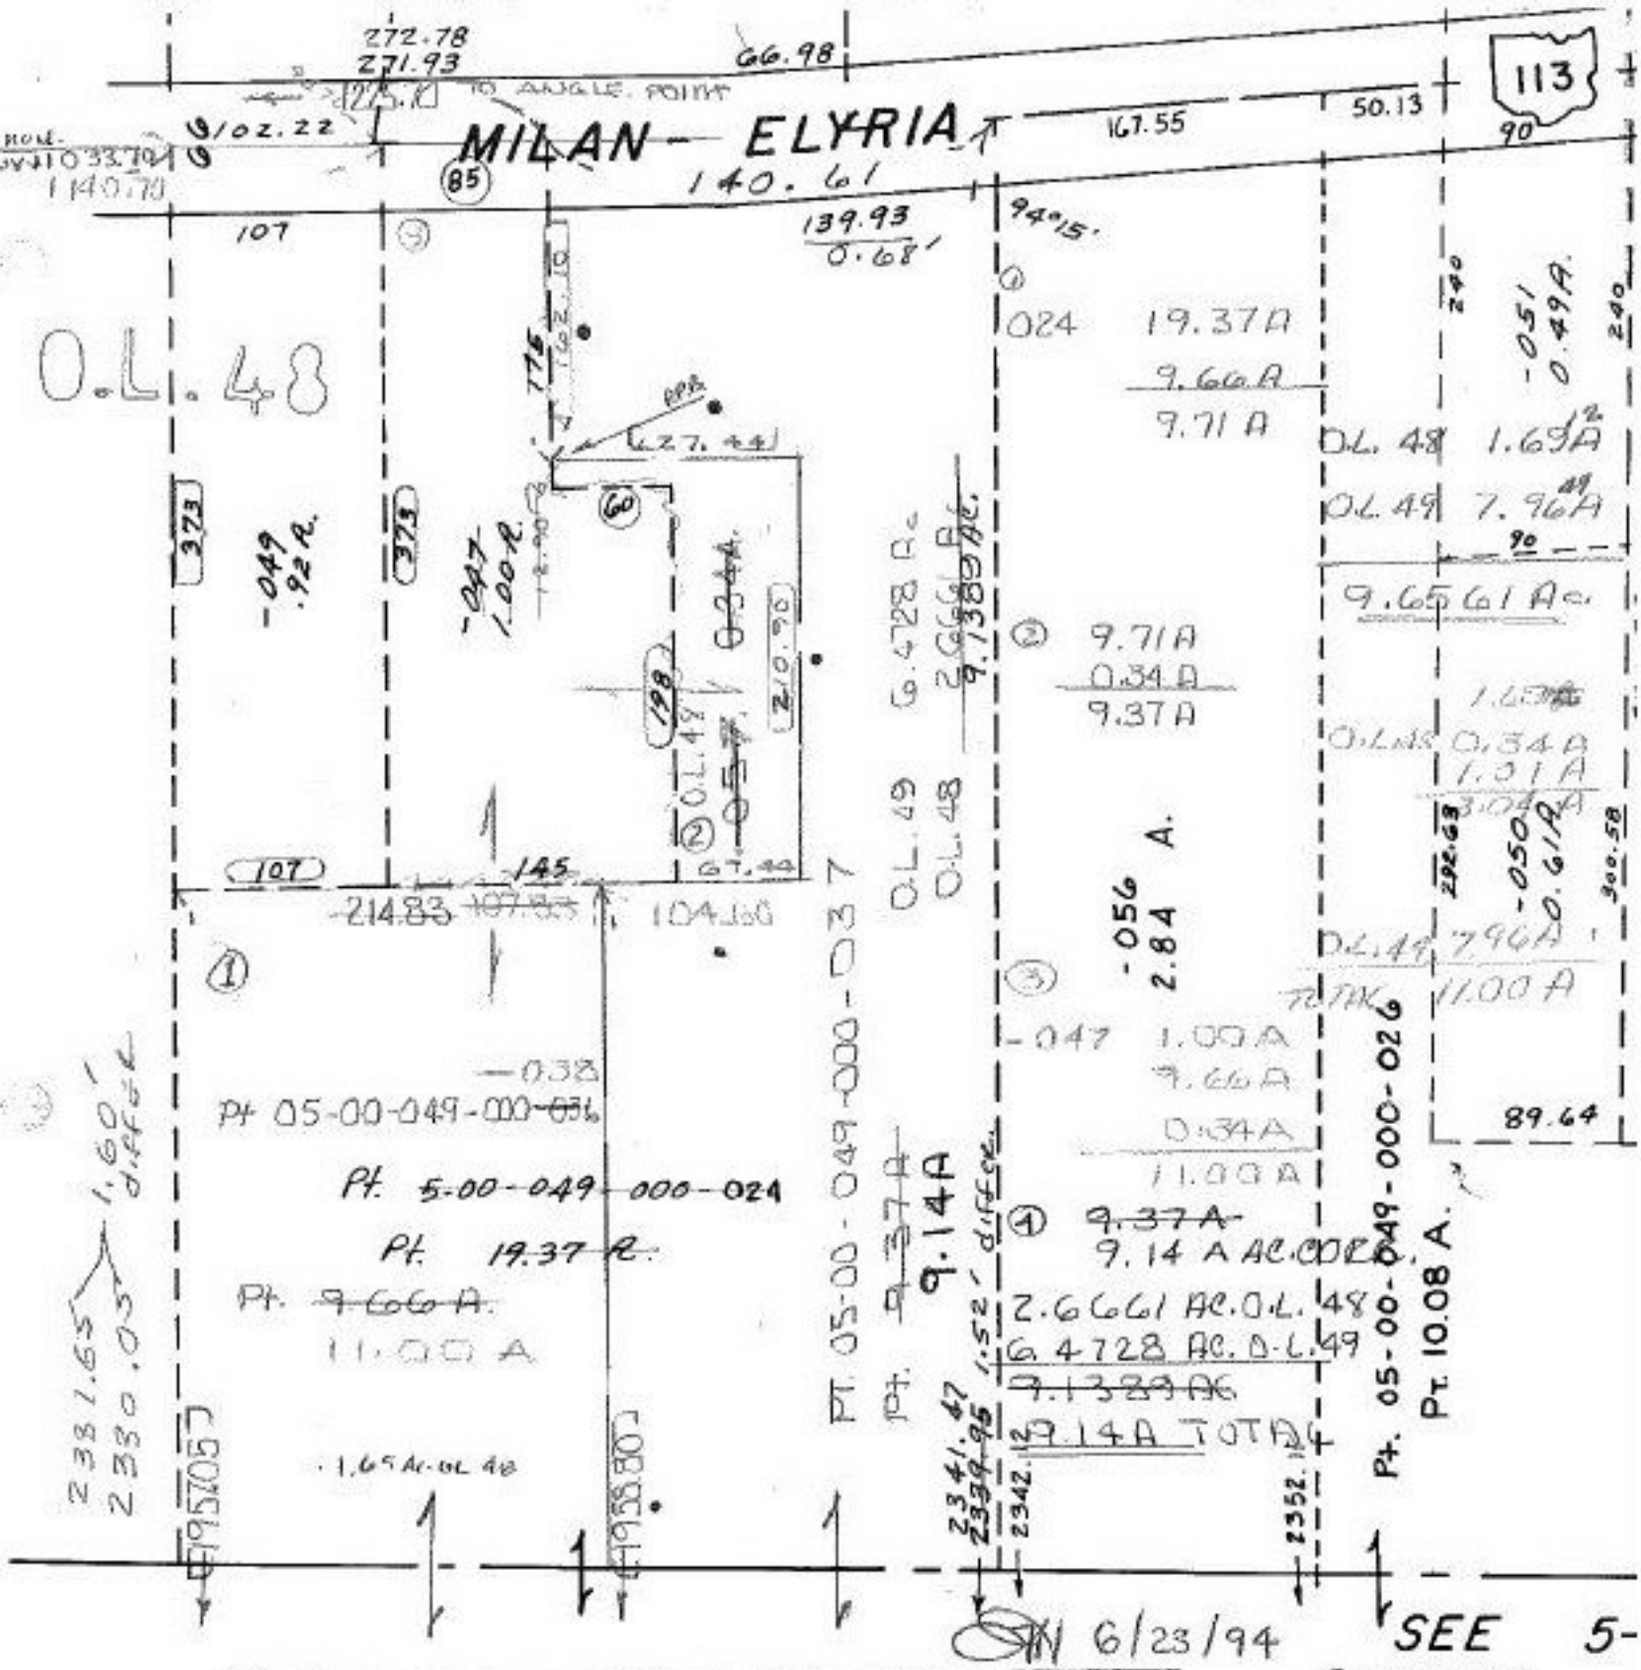

P.P.NO. 05-00-048-000- 05-00-049-000-
PRIOR INST: DV. 1337/542 dv.1085/361
CLOSURE: 1 & 2 9.66 ac. & 0.34 ac. C=1:INF.
11.00 ac. C=1:580,428
9.14 ac. C=1:591,708
SURVEYED BY: RICHARD ROSEBECK REG. SURVEYOR

APPROVED
LORAIN CO.
MAP DEPT.
DATE 2-9-94
PAGE 5-00-048-B
BY CAROLYN FRANCIS
VOID # 20732

O.L. 49