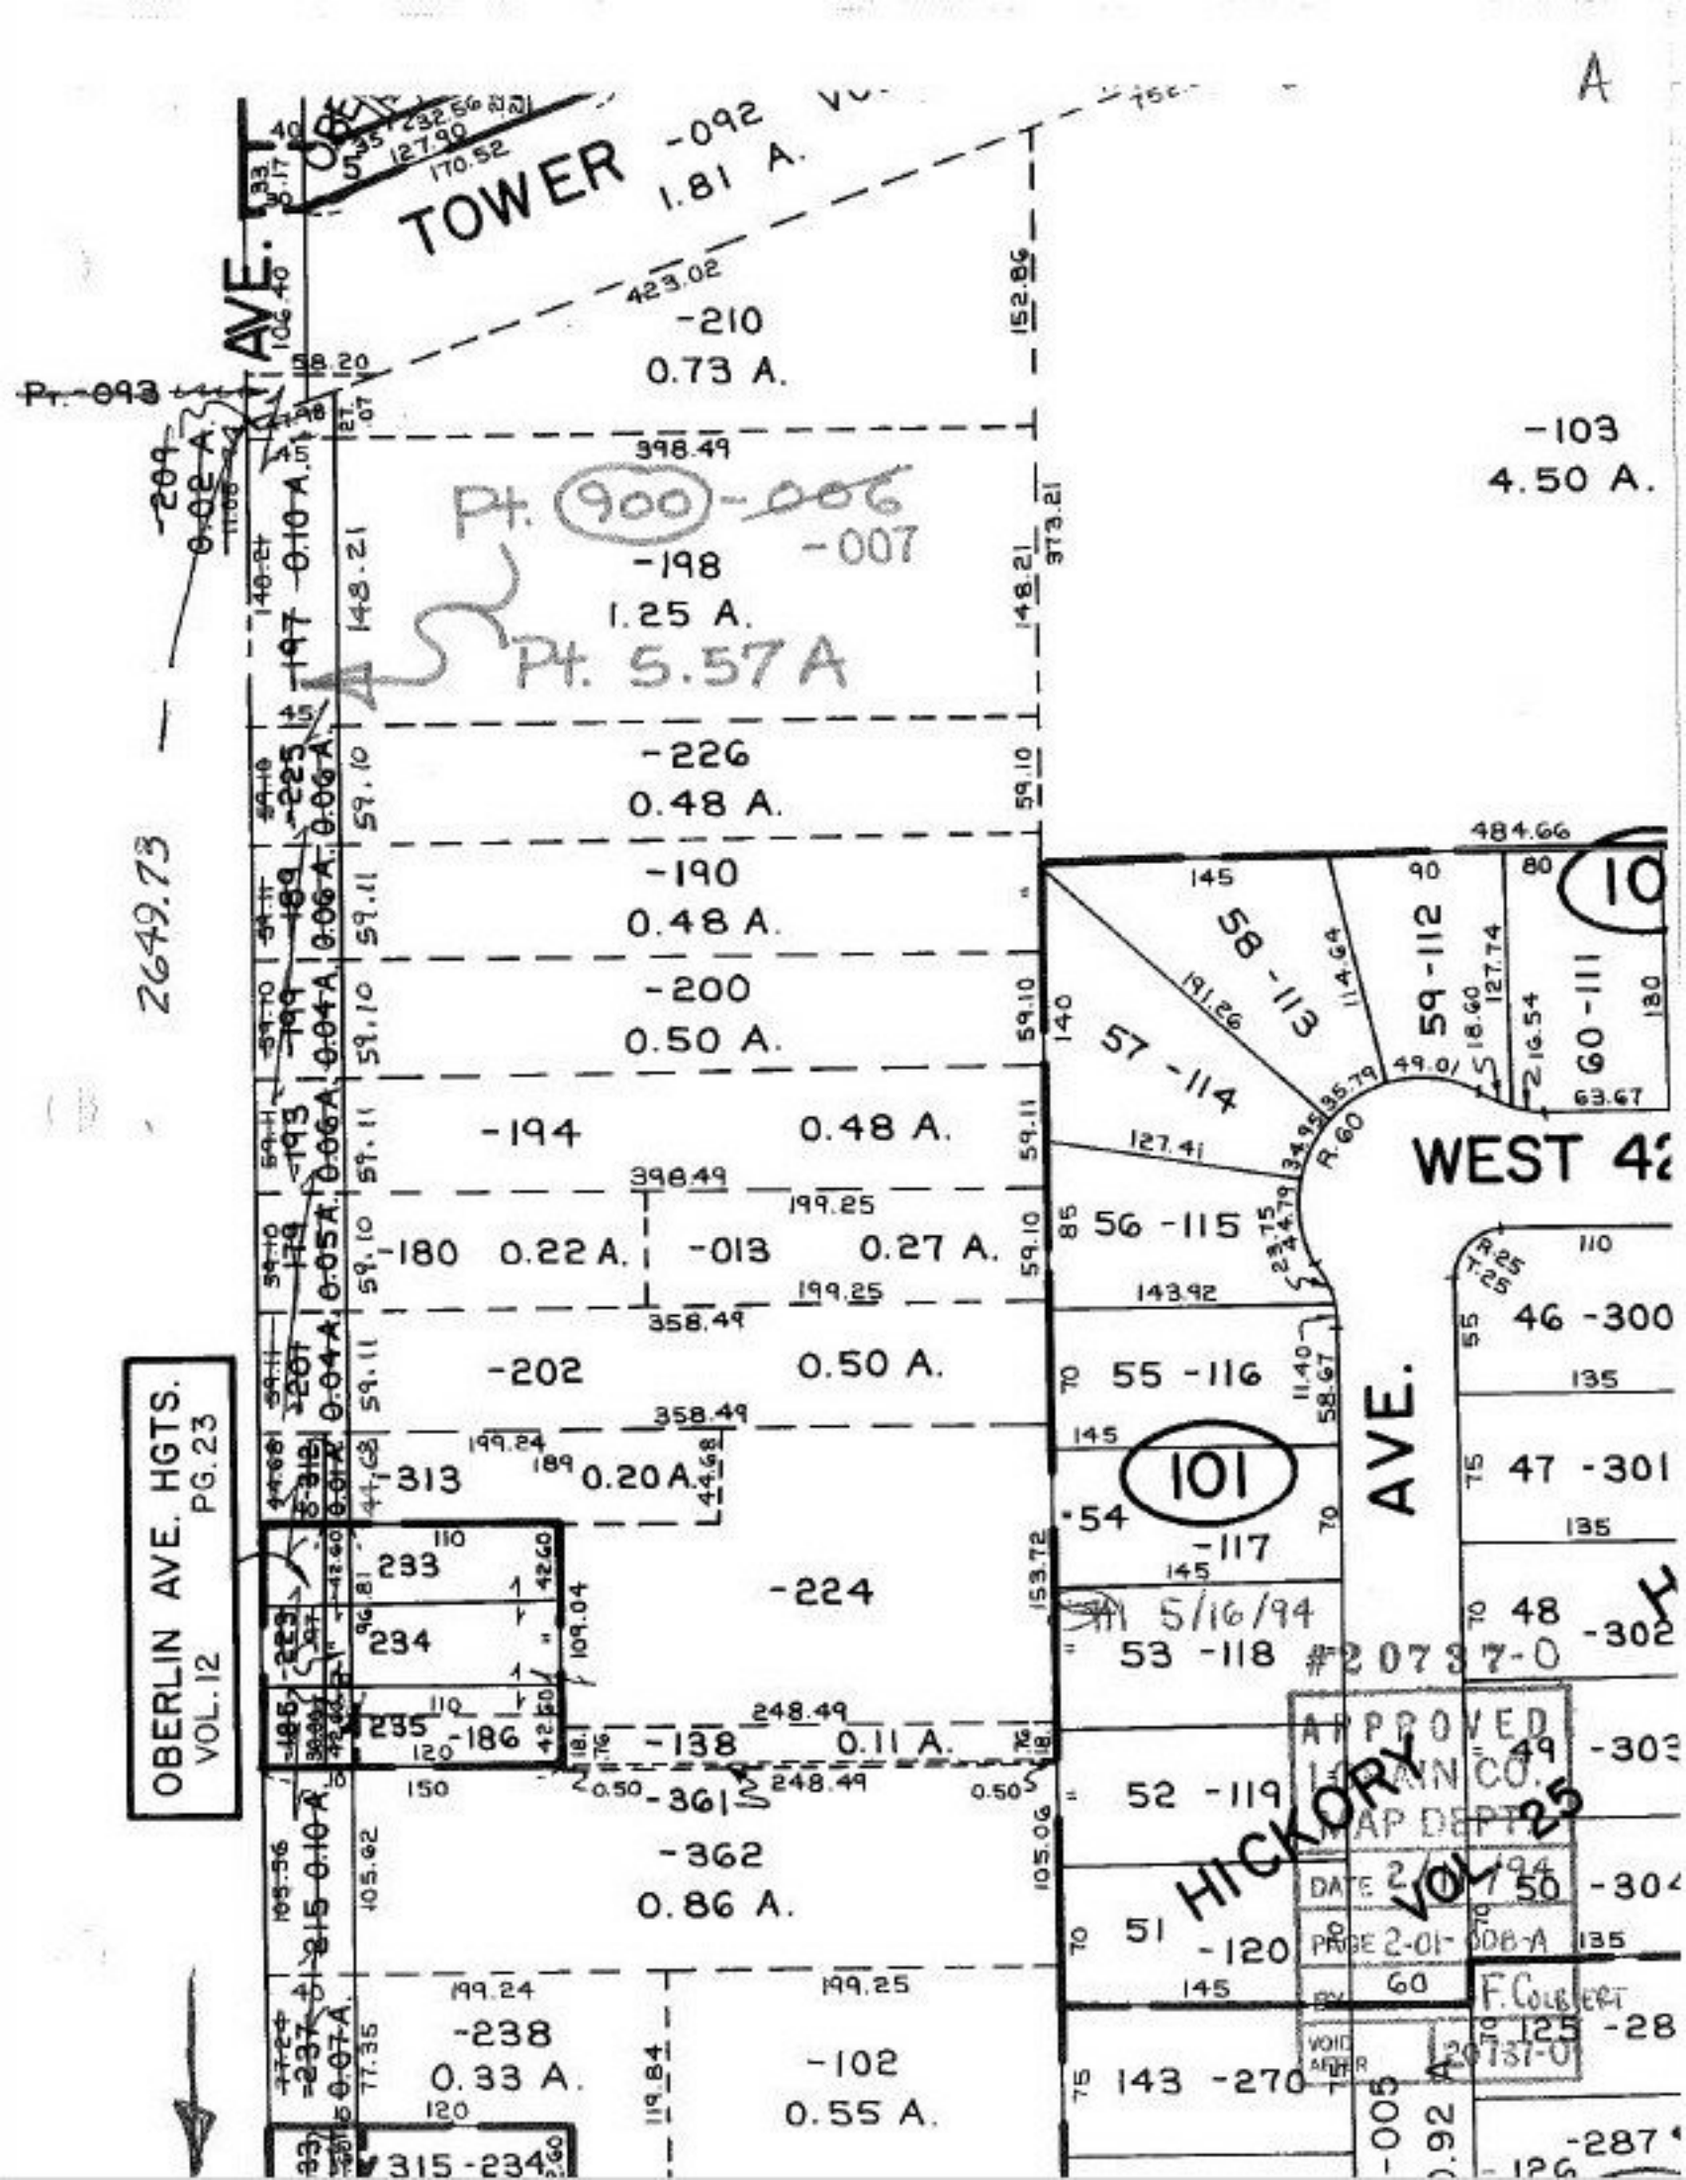
A
TOWER
1.81 A.
-092
AVE.
-210
0.73 A.
Pt. -093
-103
4.50 A.
Pt. 900 -006
-007
-198
1.25 A.
Pt. 5.57A
-226
0.48 A.
-190
0.48 A.
-200
0.50 A.
-194
0.48 A.
-180
0.22 A.
-013
0.27 A.
-202
0.50 A.
313
0.20 A.
-224
-138
0.11 A.
-361
-362
0.86 A.
-238
0.33 A.
-102
0.55 A.
315-234
2649.73
OBERLIN AVE. HGTS.
VOL. 12
PG. 23
WEST 42
HICKORY AVE.
101
10
58-113
57-114
59-112
60-111
56-115
55-116
54-117
53-118
52-119
51-120
46-300
47-301
48-302
49-303
50-304
125-28
143-270
-005
-287
#20737-0
5/16/94
APPROVED
LORAIN CO.
MAP DEPT.
DATE 2/7/94
PAGE 2-01
VOL 25
F. COLBERT
VOID AFTER TRANSFER