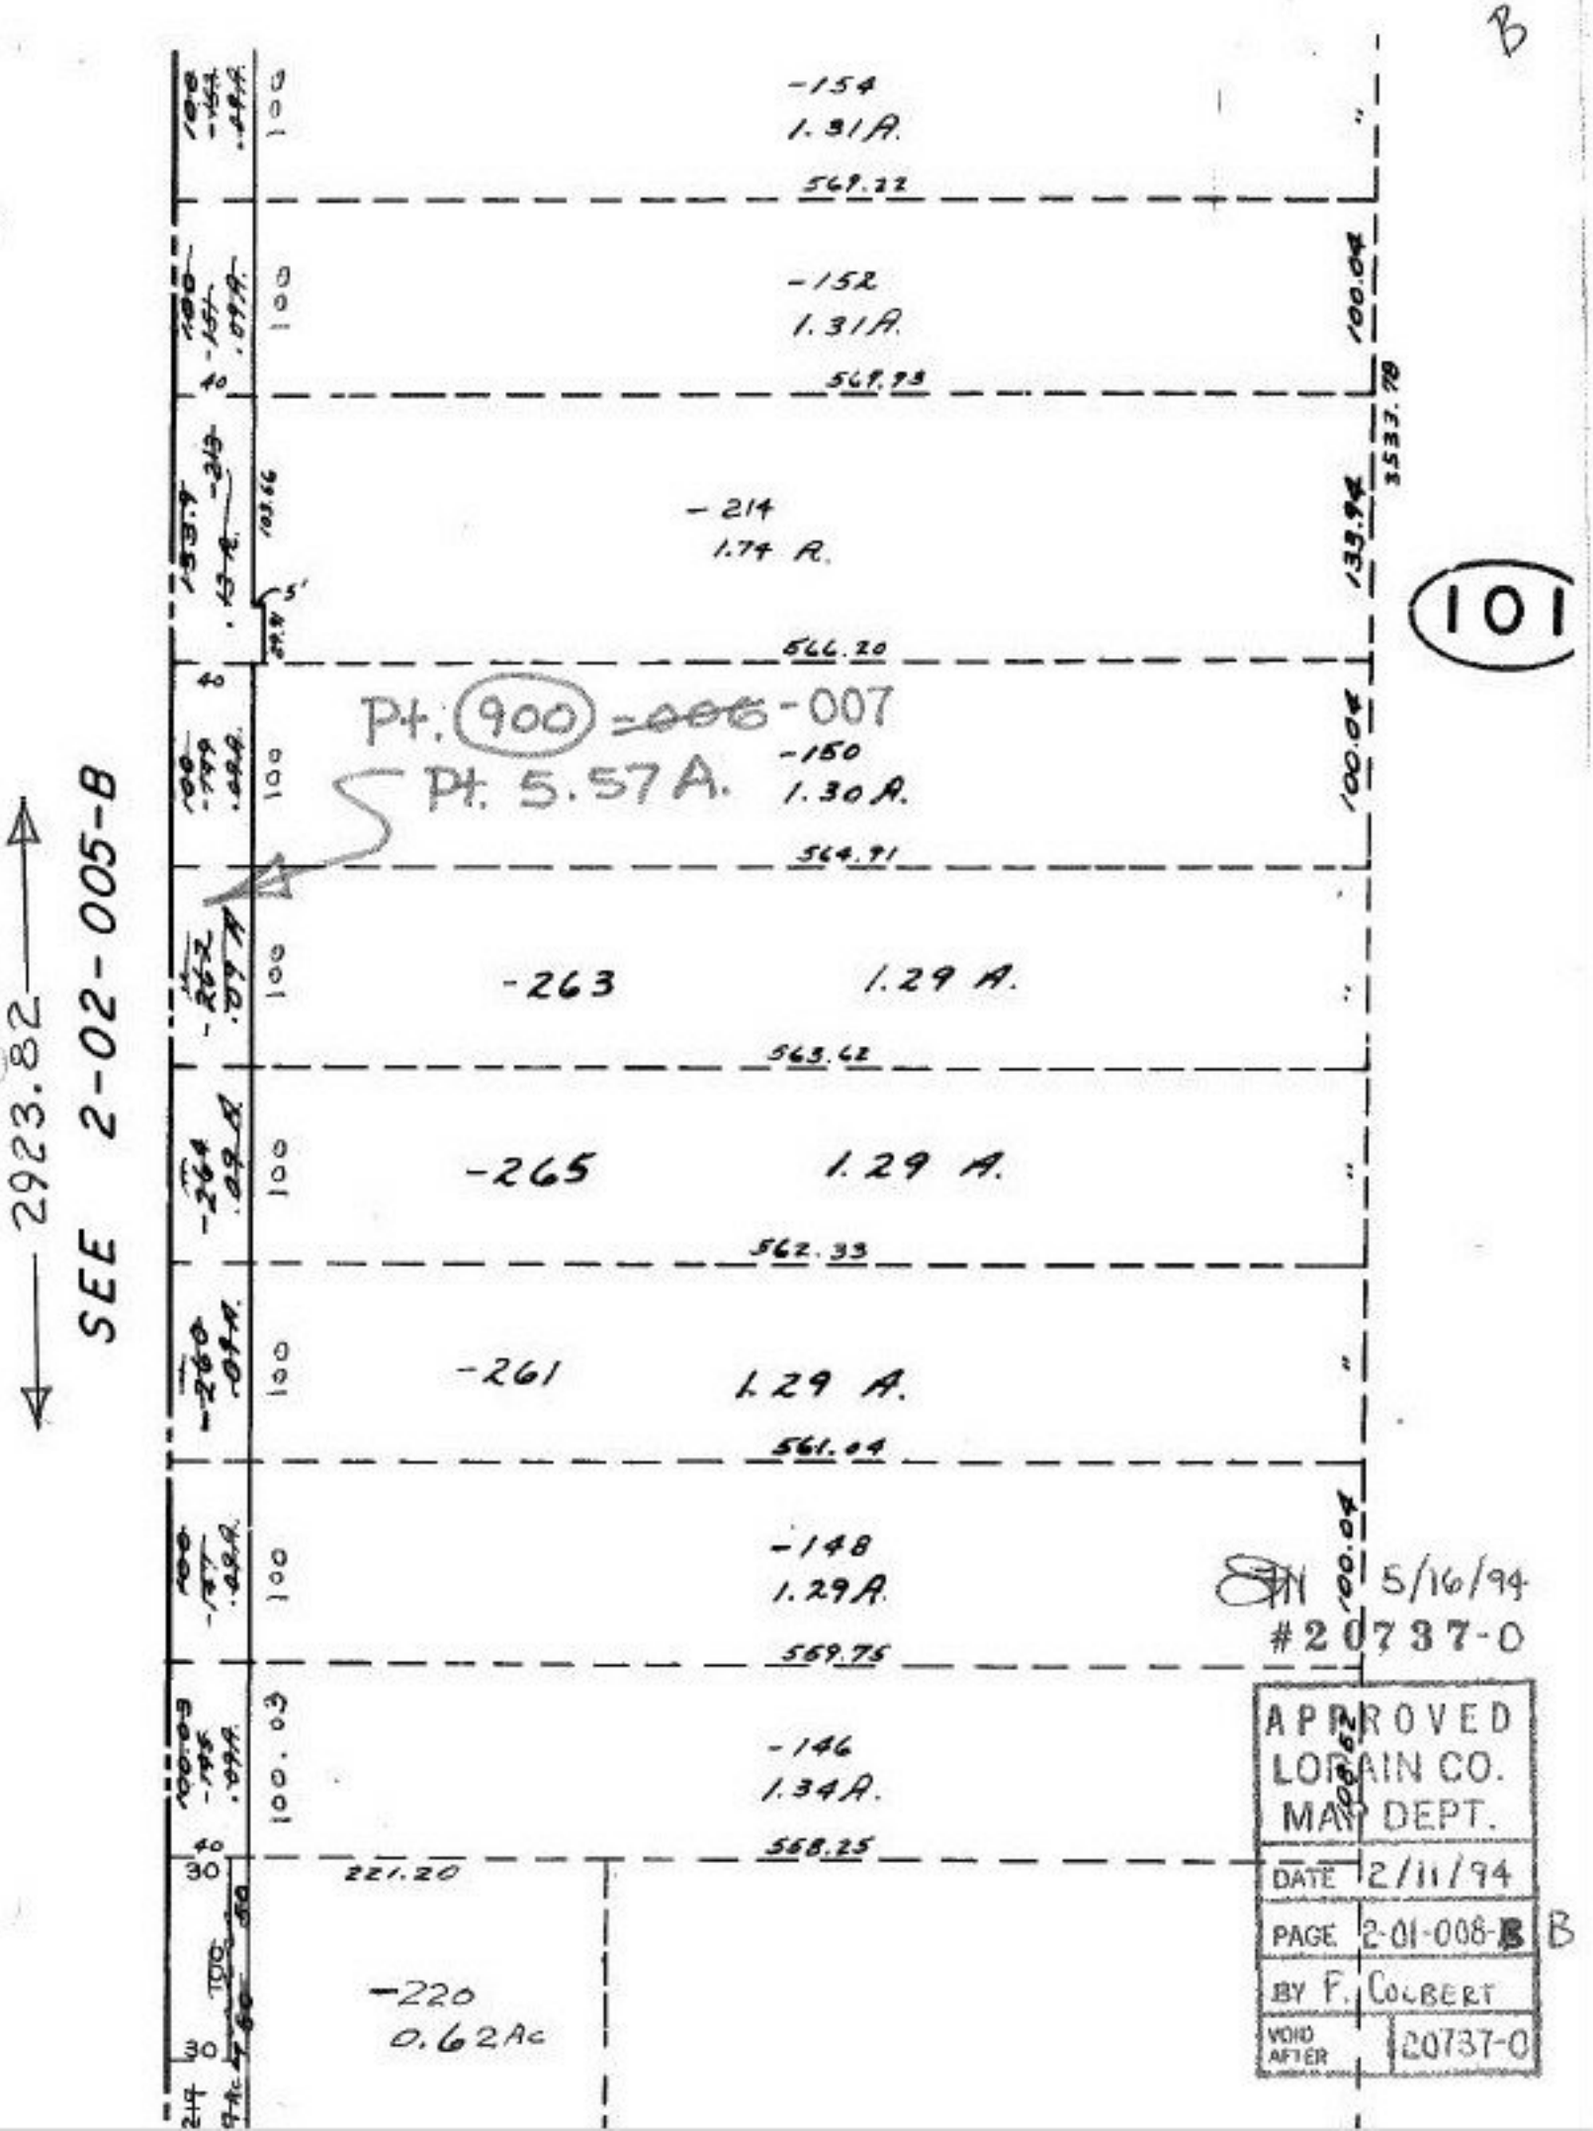
B
-154
1.31A.
569.22
-152
1.31A.
569.93
100.04
3537.78
-214
1.74 A.
566.20
139.94
101
Pt. (900) -006 -007
Pt. 5.57A.
-150
1.30 A.
564.91
100.04
-263
1.29 A.
563.62
-265
1.29 A.
562.33
-261
1.29 A.
561.04
-148
1.29A.
569.75
100.04
-146
1.34A.
568.25
221.20
-220
0.62Ac
SEE 2-02-005-B
2923.82
5/16/94
#20737-0
APPROVED
LORAIN CO.
MAP DEPT.
DATE 2/11/94
PAGE 2-01-008-B
BY F. COLBERT
VOID AFTER 20737-0