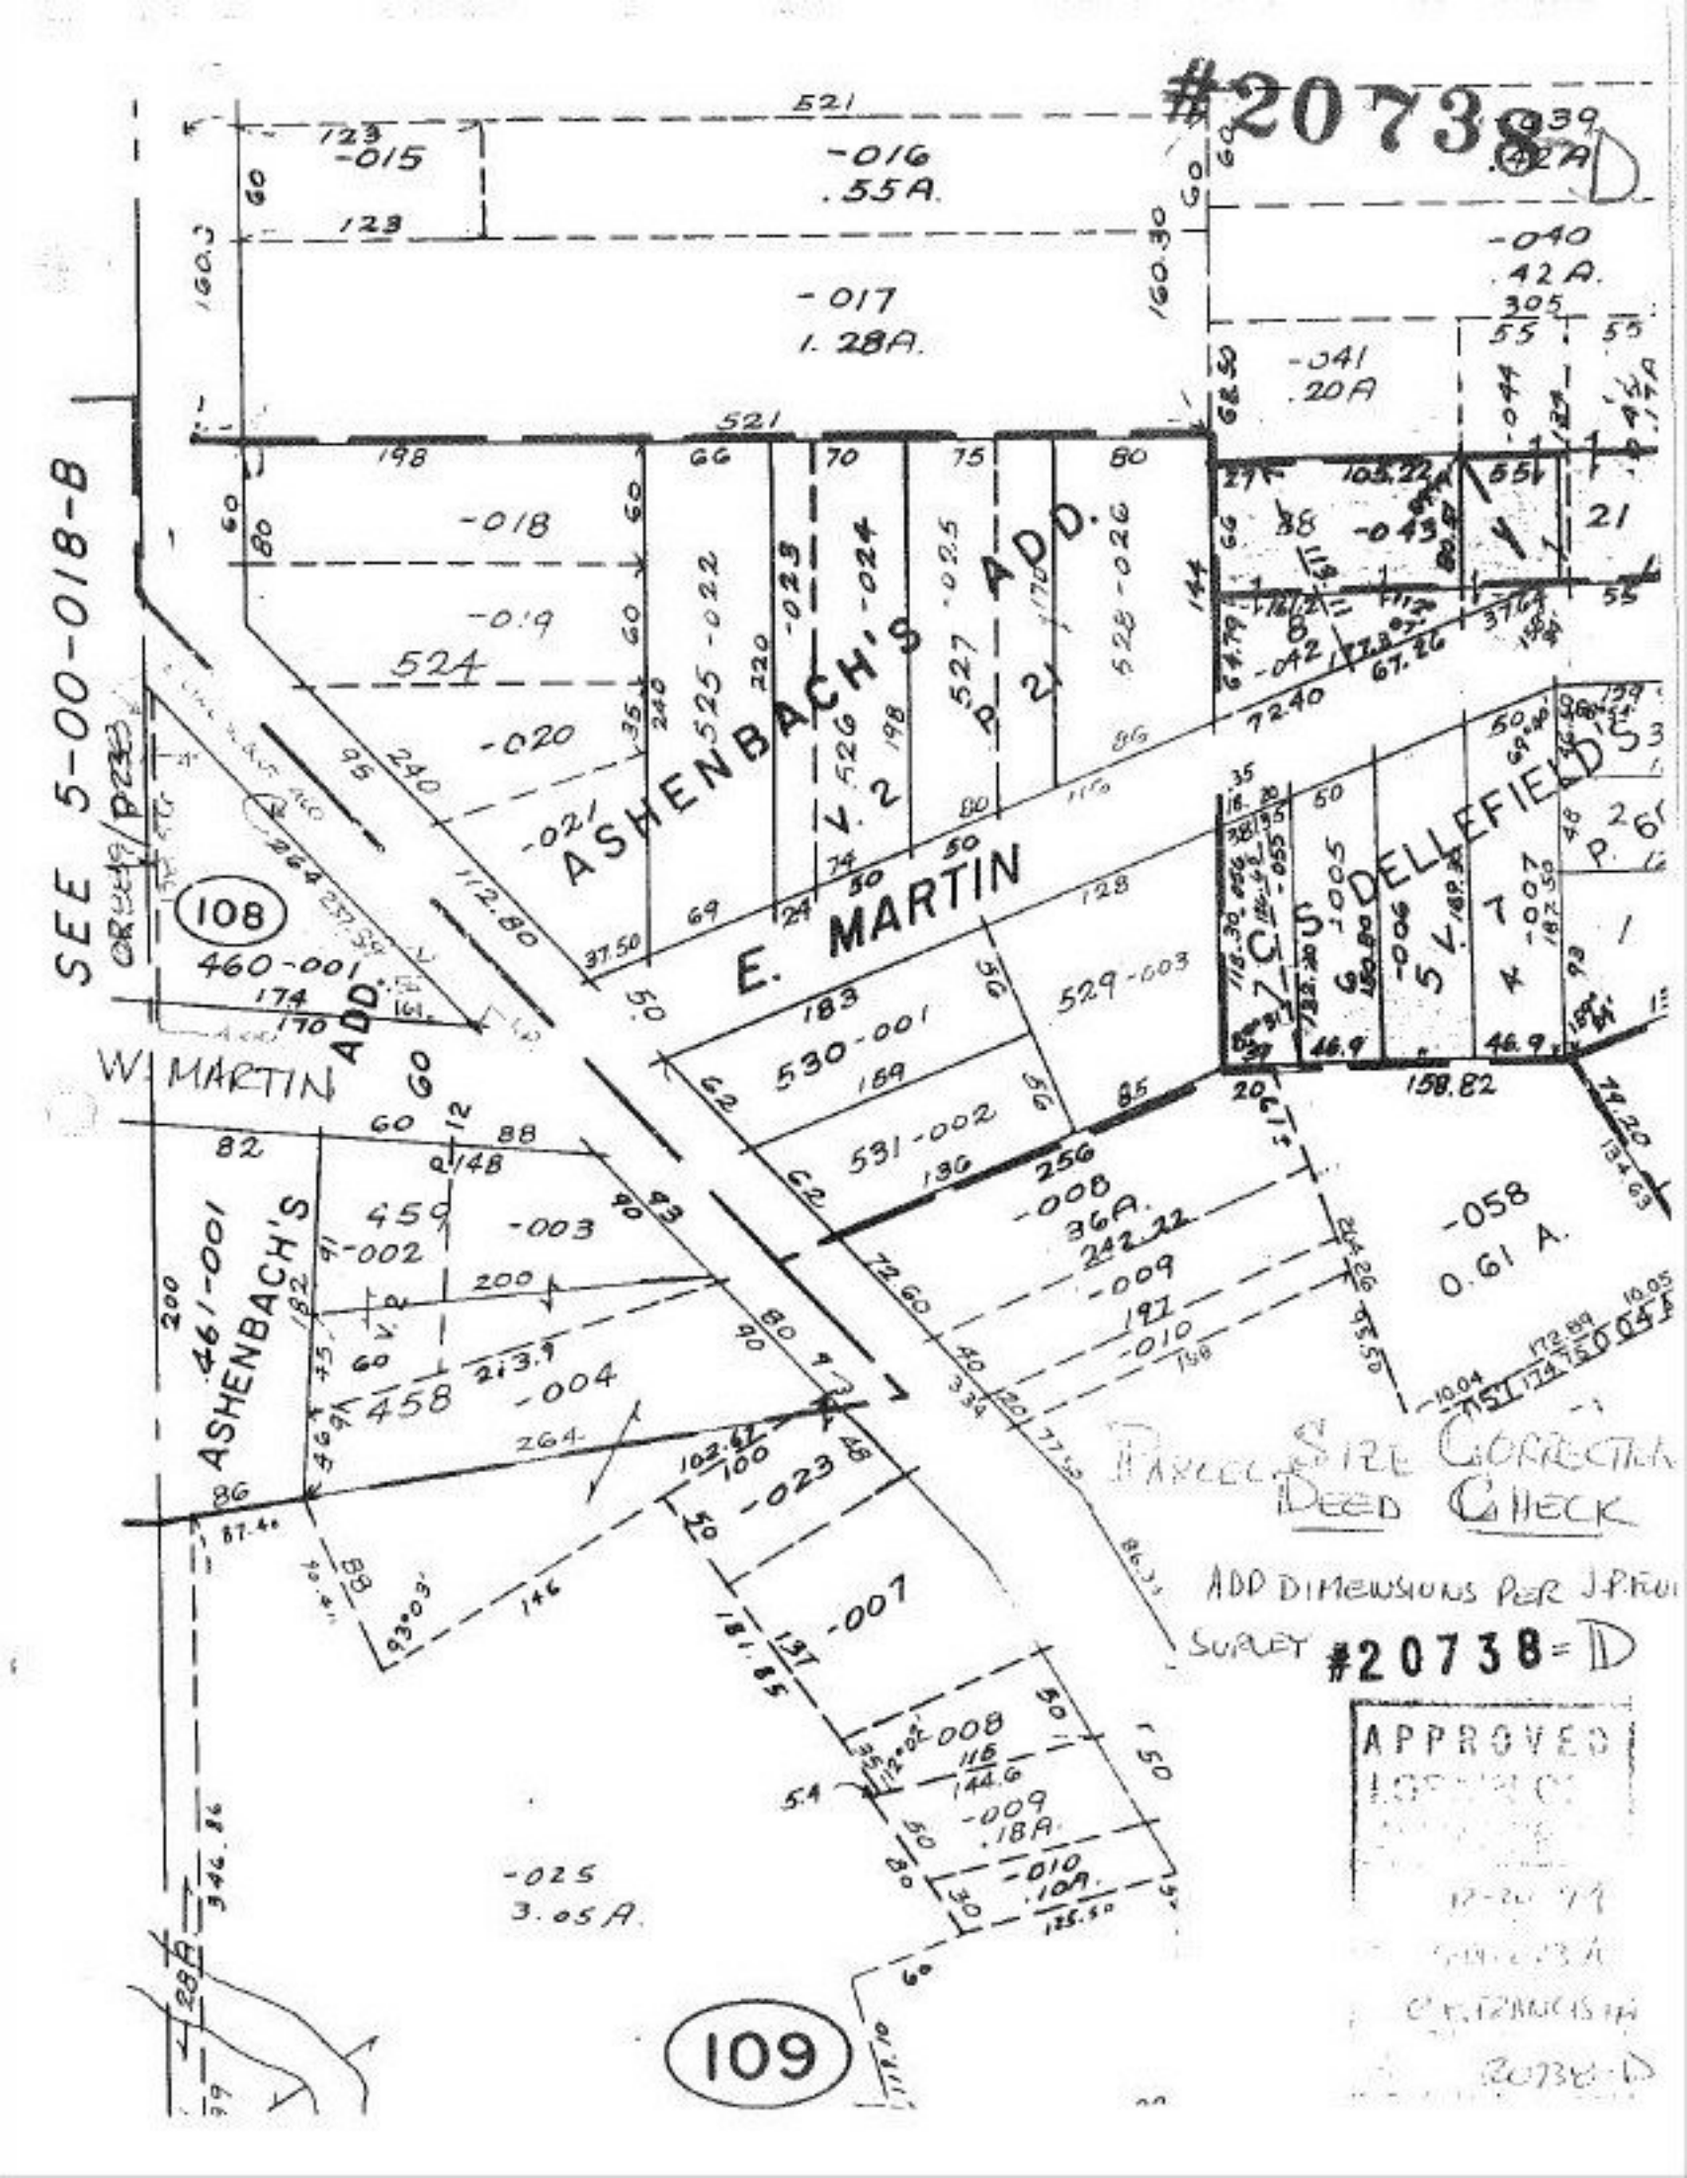
#20738
SEE 5-00-018-B
ASHENBACH'S ADD.
E. MARTIN
W. MARTIN ADD.
ASHENBACH'S
DELLEFIELD'S
-015
-016
.55A.
-017
1.28A.
-040
.42A.
-041
.20A
-018
-019
-020
-021
-022
-023
-024
-025
3.05A.
-026
-042
-043
-044
-045
-055
-006
-007
-058
0.61 A.
-008
36A.
-009
.18A.
-010
.109A.
459
-003
458
-004
460-001
461-001
529-003
530-001
531-002
524
108
109
PARCEL SIZE CORRECTION
DEED CHECK
ADD DIMENSIONS PER J.P. FOU
SURVEY #20738-D
APPROVED
12-20-77
#20738-D