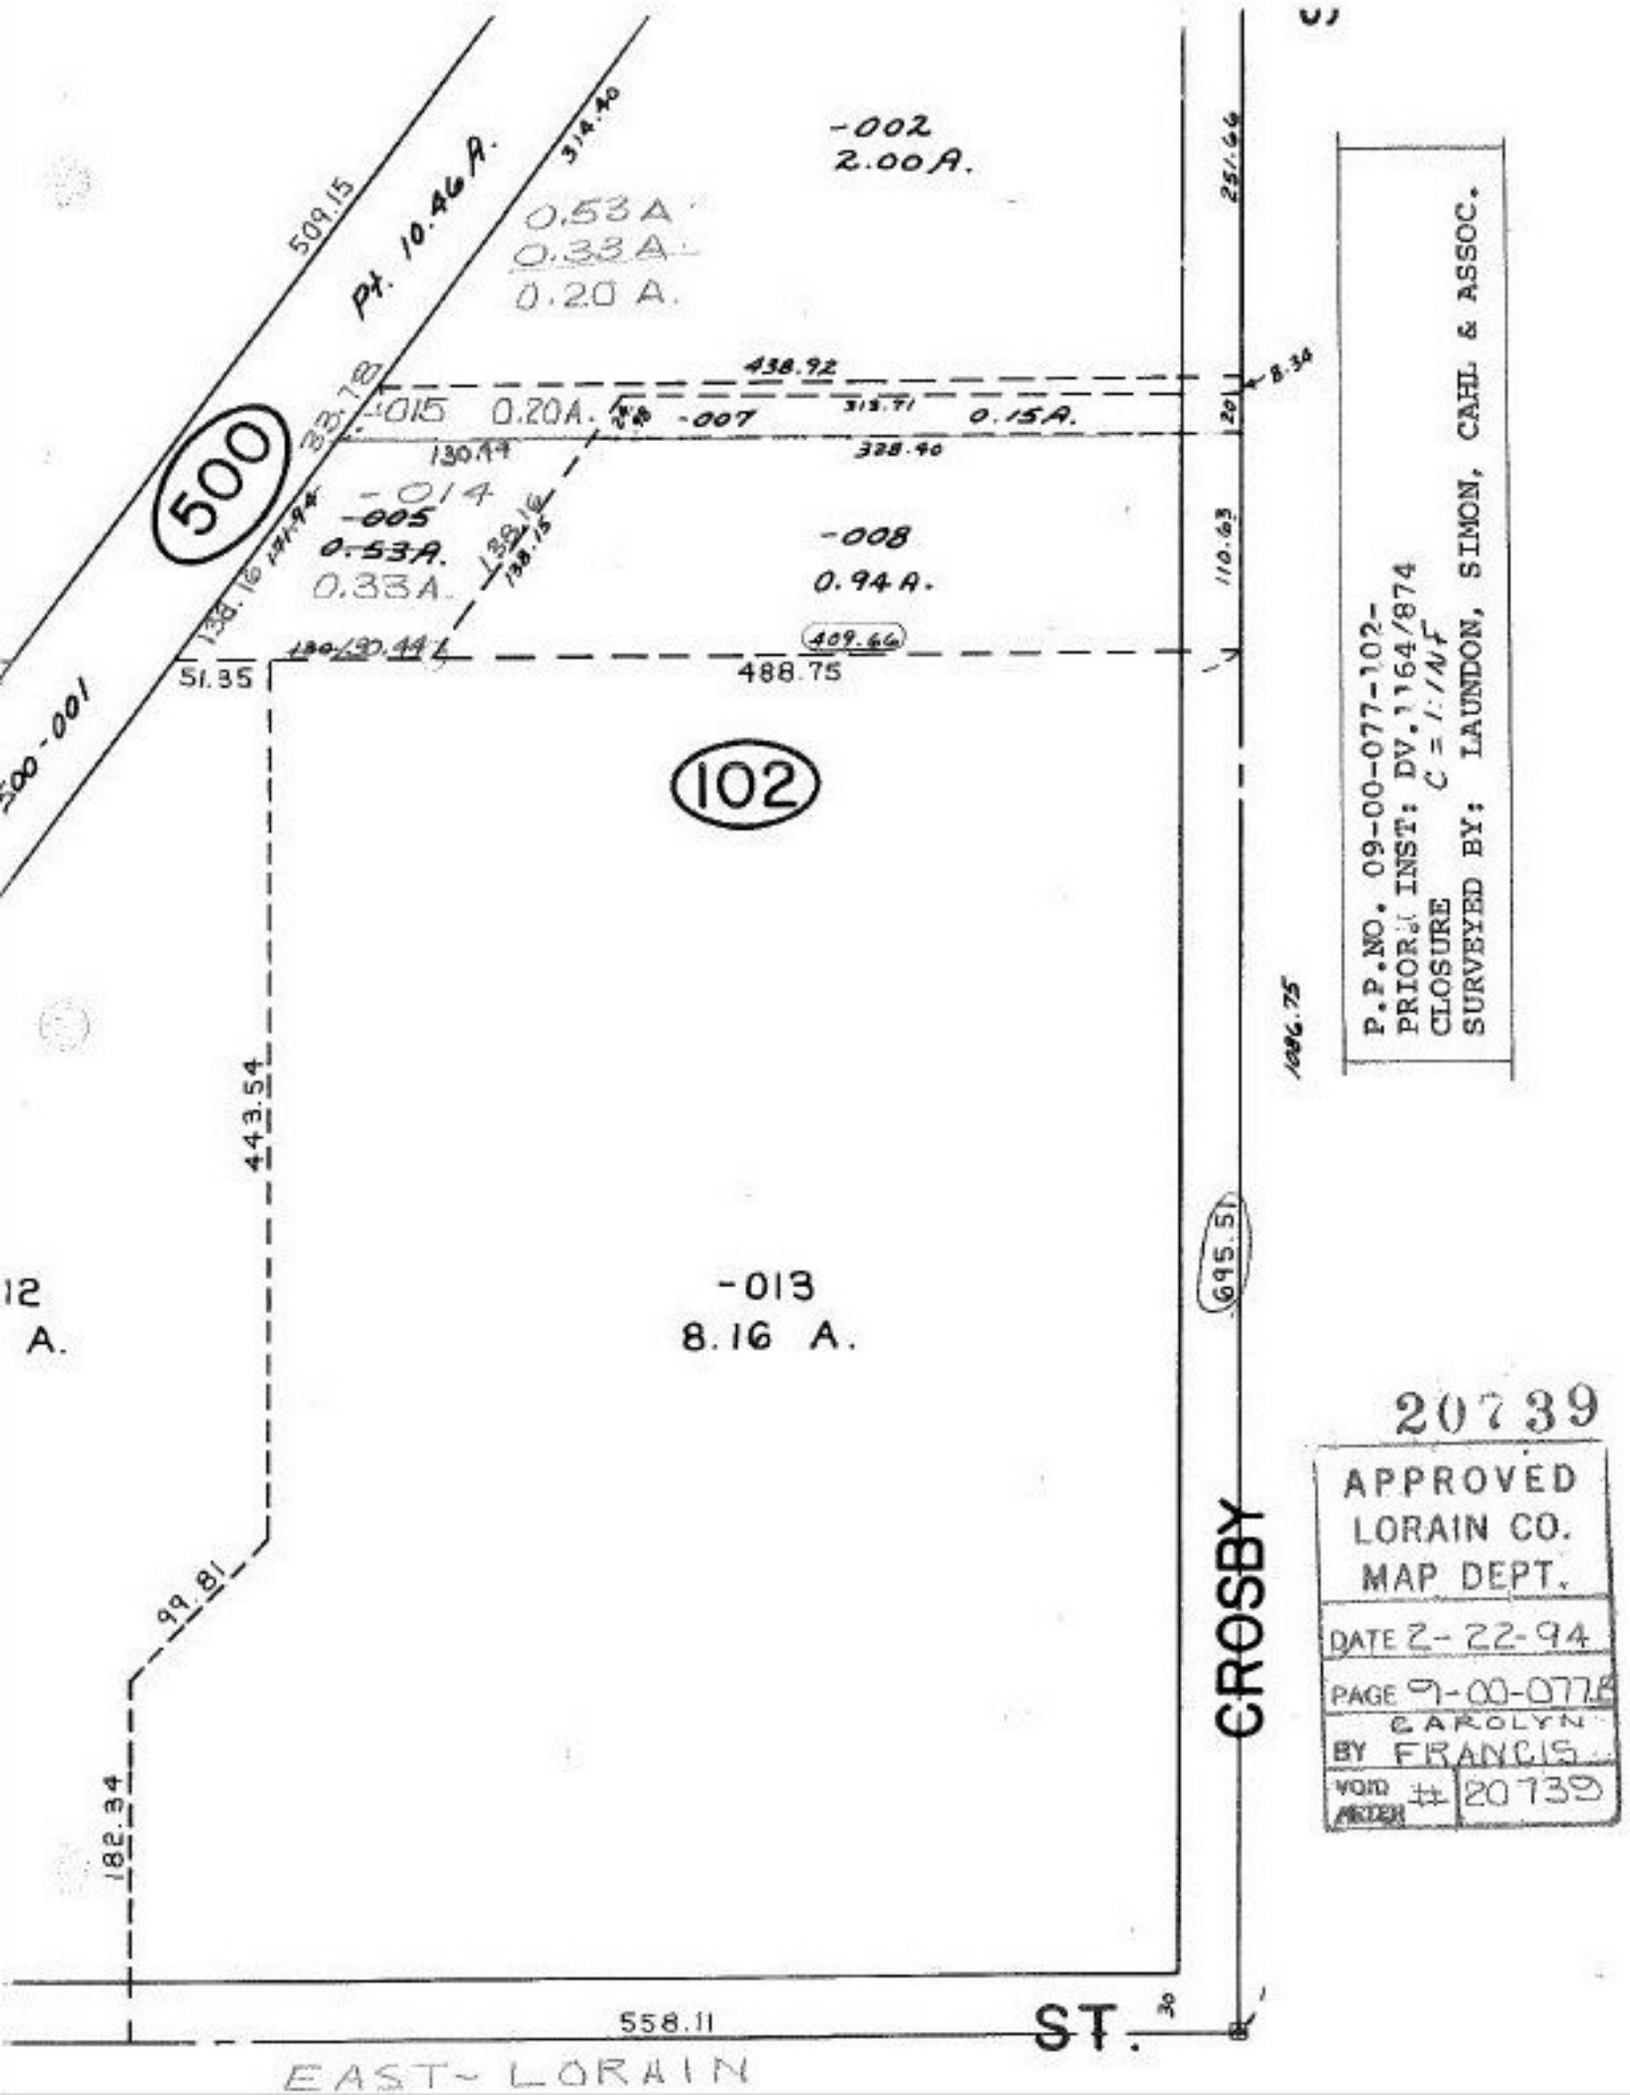
-002
2.00A.
0.53A.
0.33A.
0.20A.
Pt. 10.46A.
509.15
314.40
251.66
438.92
-015 0.20A.
-007
313.71
0.15A.
328.40
130.79
-014
-005
0.53A.
0.33A.
-008
0.94A.
409.64
488.75
51.35
500
500-001
102
-013
8.16 A.
443.54
695.51
1086.75
110.63
99.81
182.34
558.11
CROSBY ST.
EAST-LORAIN
P.P.NO. 09-00-077-102-
PRIOR INST: DV.1164/874
CLOSURE
SURVEYED BY: LAUNDON, SIMON, CAHL & ASSOC.
20739
APPROVED
LORAIN CO.
MAP DEPT.
DATE 2-22-94
PAGE 9-00-077.B
BY CAROLYN FRANCIS
VOID AFTER # 20739