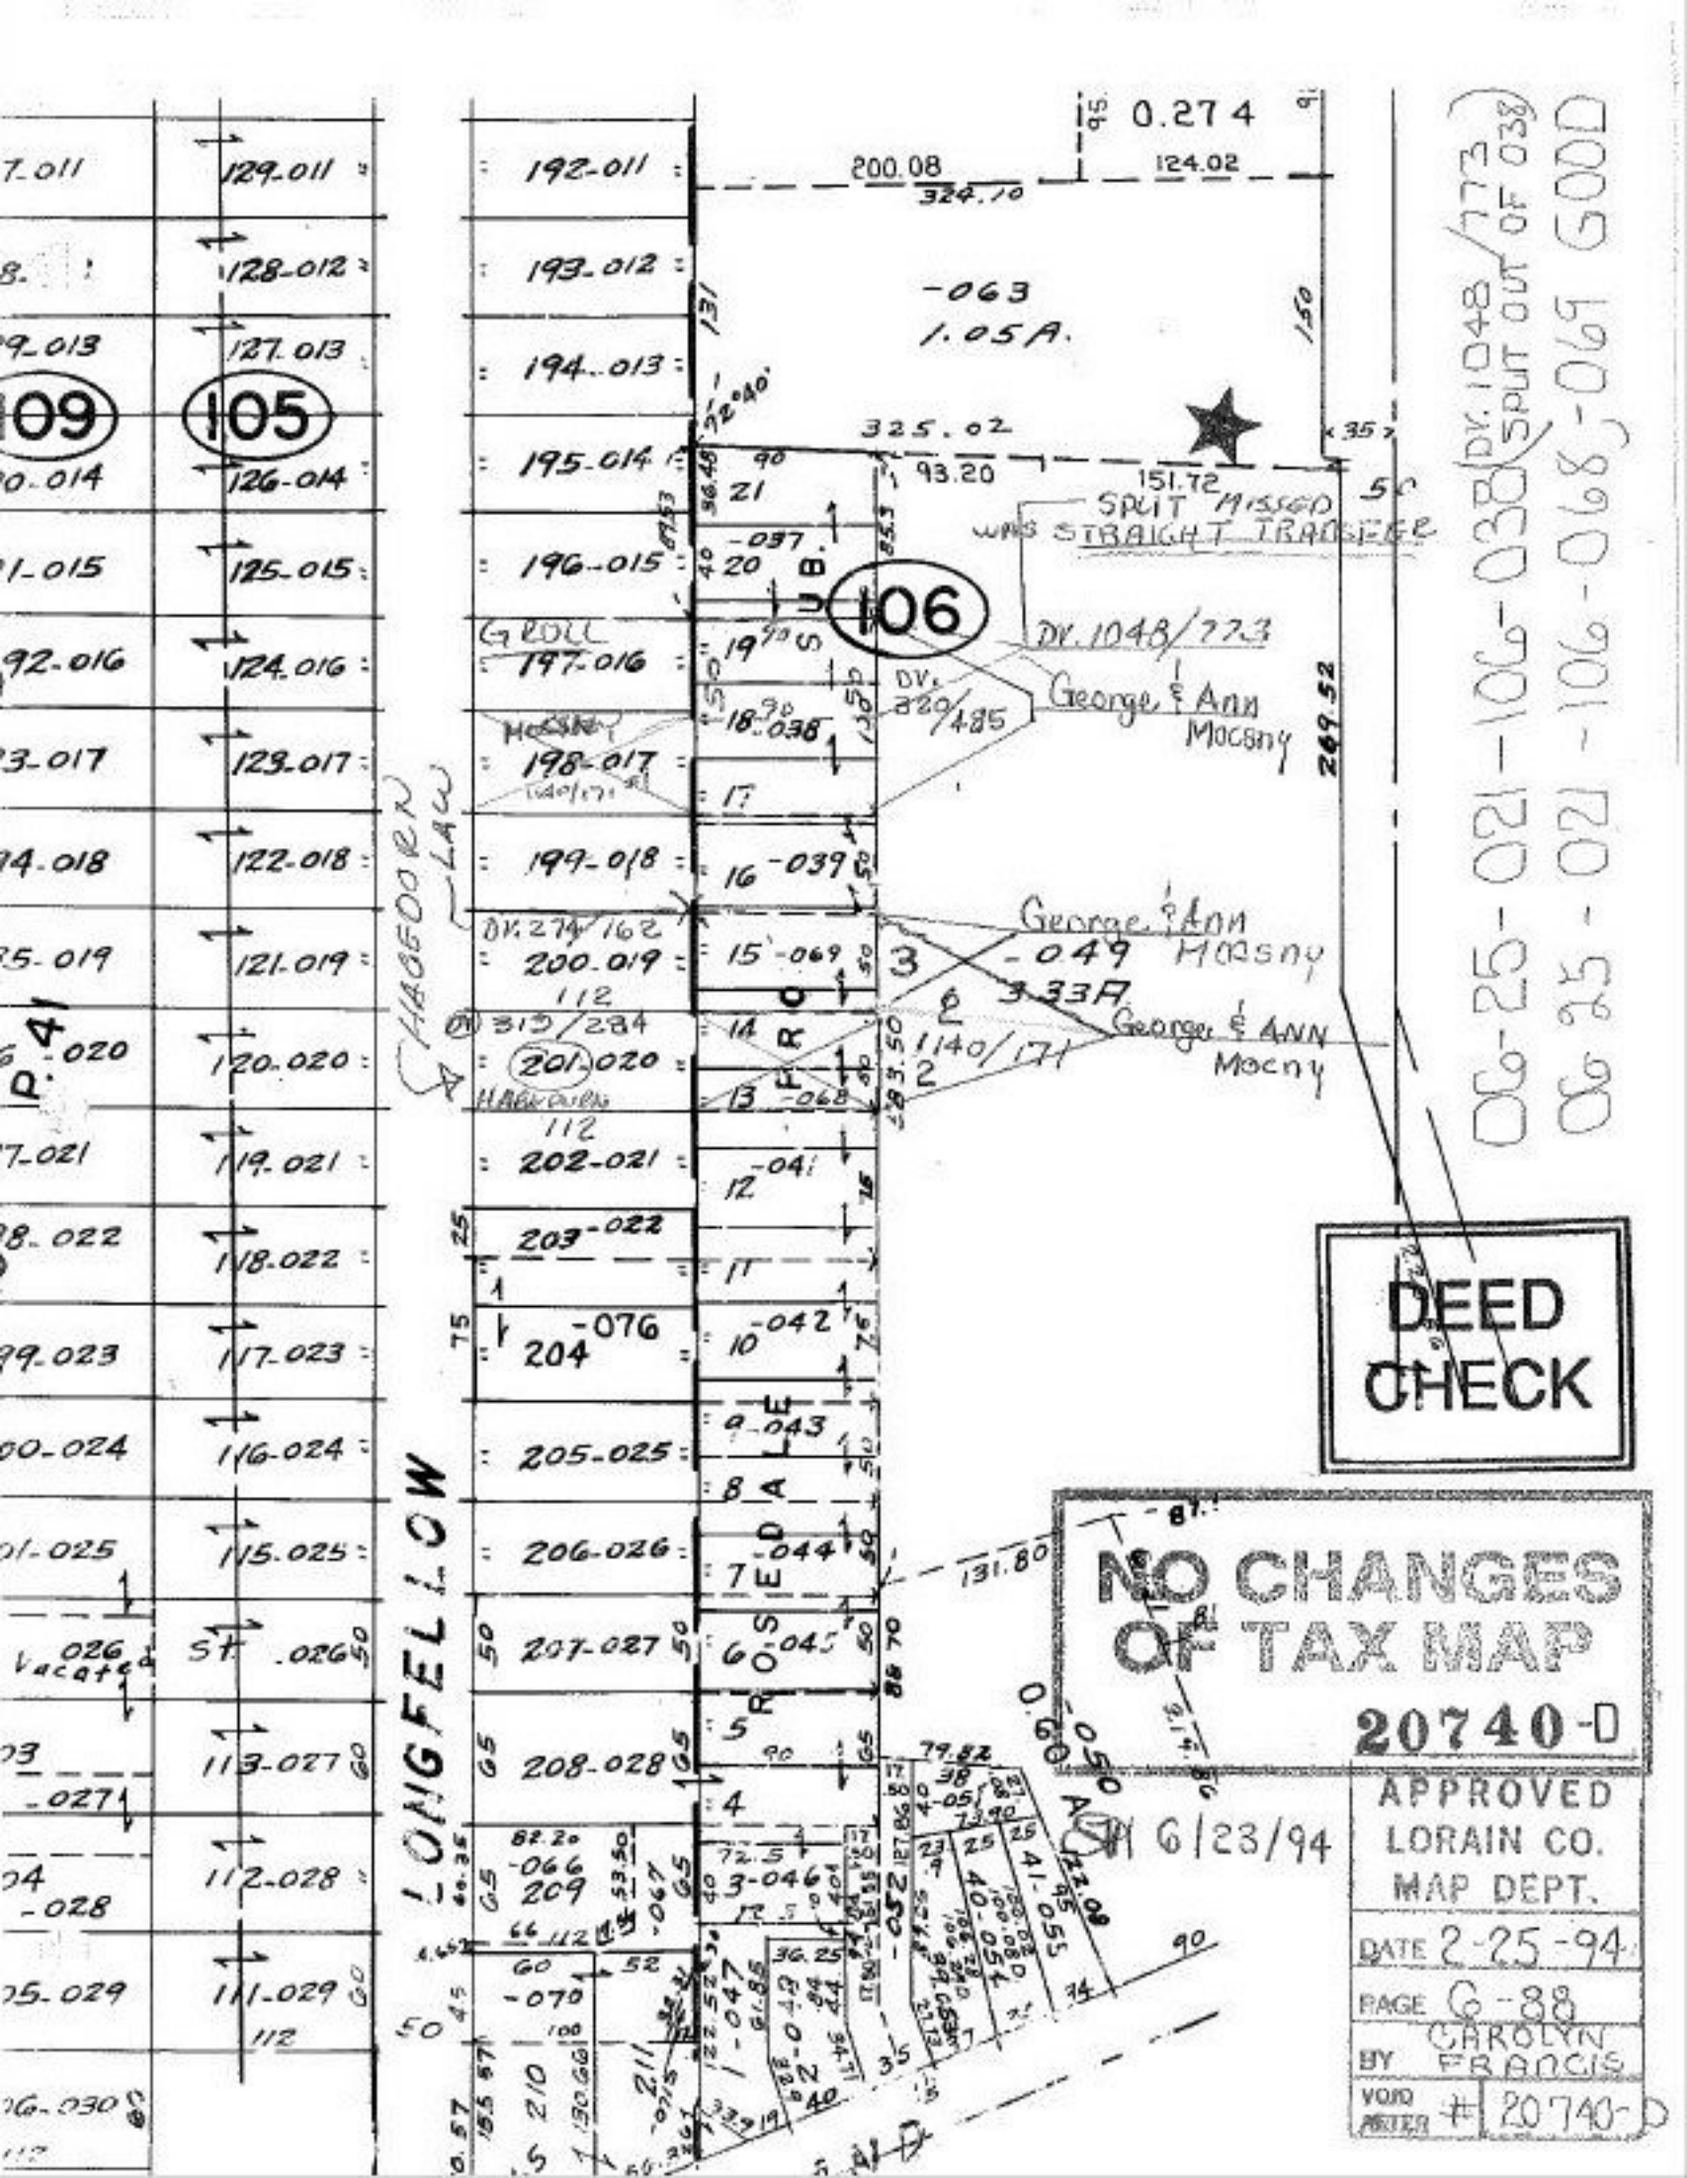
0.274
200.08
124.02
324.10
-063
1.05A.
325.02
93.20
151.72
SPLIT MISSED
WAS STRAIGHT TRANSFER
DV. 1048/773
George & Ann
Macsny
DV. 820/485
DV. 1140/171
DV. 274/162
DV. 315/284
DEED
CHECK
NO CHANGES
OF TAX MAP
20740-D
APPROVED
LORAIN CO.
MAP DEPT.
DATE 2-25-94
PAGE 6-88
BY CAROLYN FRANCIS
VOID AFTER # 20740-D
6/23/94
LONGFELLOW
HAGGOOREN LANE
109
105
106
DC-25-021-106-038 (DV. 1048/773 SPLIT OUT OF 038)
DC-25-021-106-068, 069 GOOD