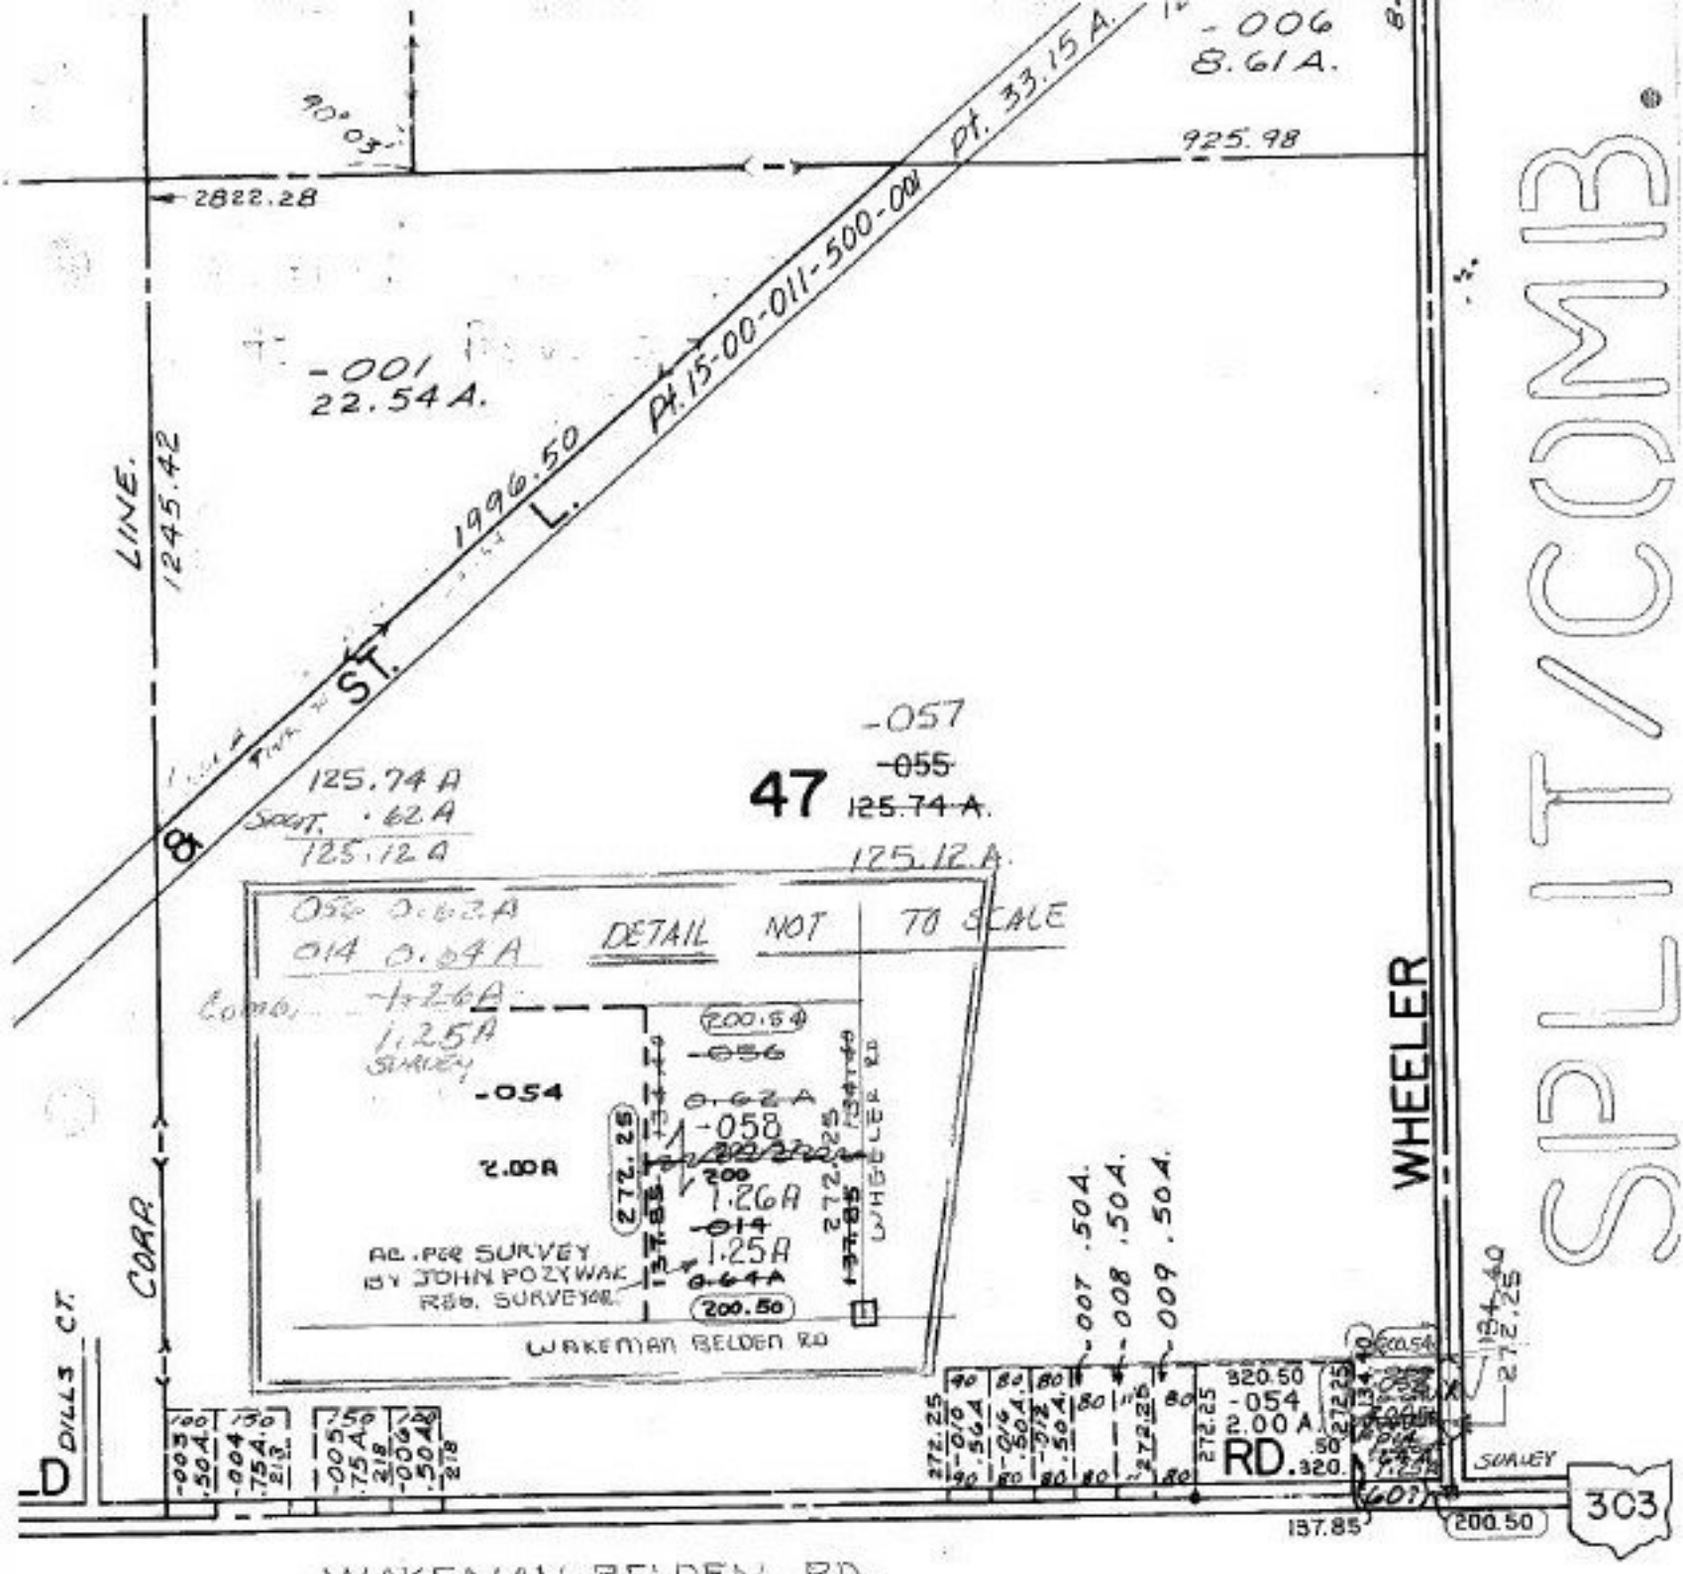

WAKEMAN-BELDEN RD.

P.P.NO.	15-00-047-000-
PRIOR INST:	
CLOSURE:	0.62 ac. C=1:860,882
	1.25 ac. C=1:899,669
SURVEYED BY:	JOHN POZYWAK
	REG. SURVEYOR

AUG 2 1994

20743

APPROVED
LORAIN CO.
MAP DEPT.

DATE 2-23-94

PAGE 15-C

BY CAROLYN FRANCIS

VOID AFTER # 20743