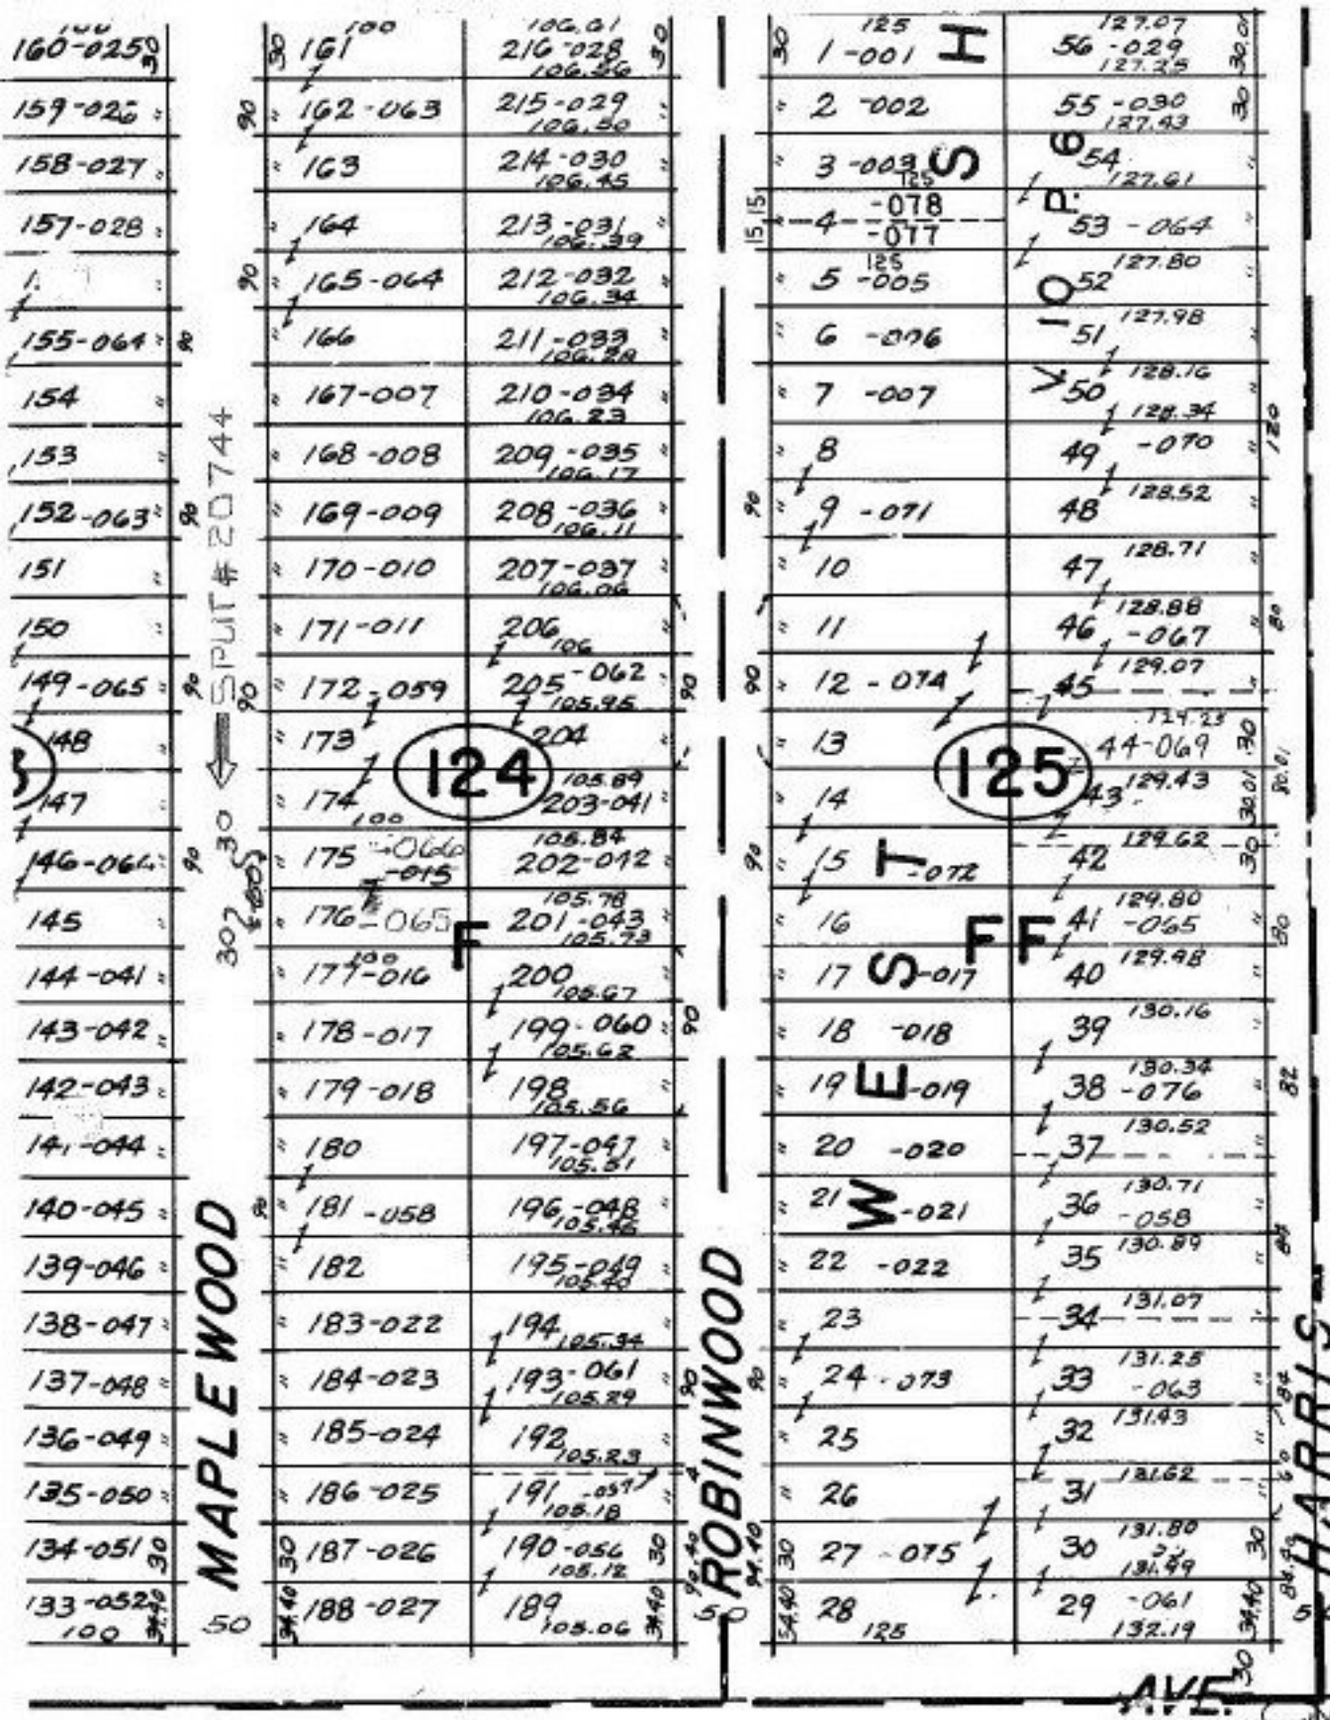

-027-B

P.P.NO. 03-00-038-124-
PRIOR INST: O.R. 843/329
CLOSURE: C=1:INF.

5/16/94
20744

APPROVED
LORAIN CO.
MAP DEPT.
DATE 2-25-94
PAGE 3-00-038-B
BY CAROLYN FRANCIS
VOID AFTER # 20744