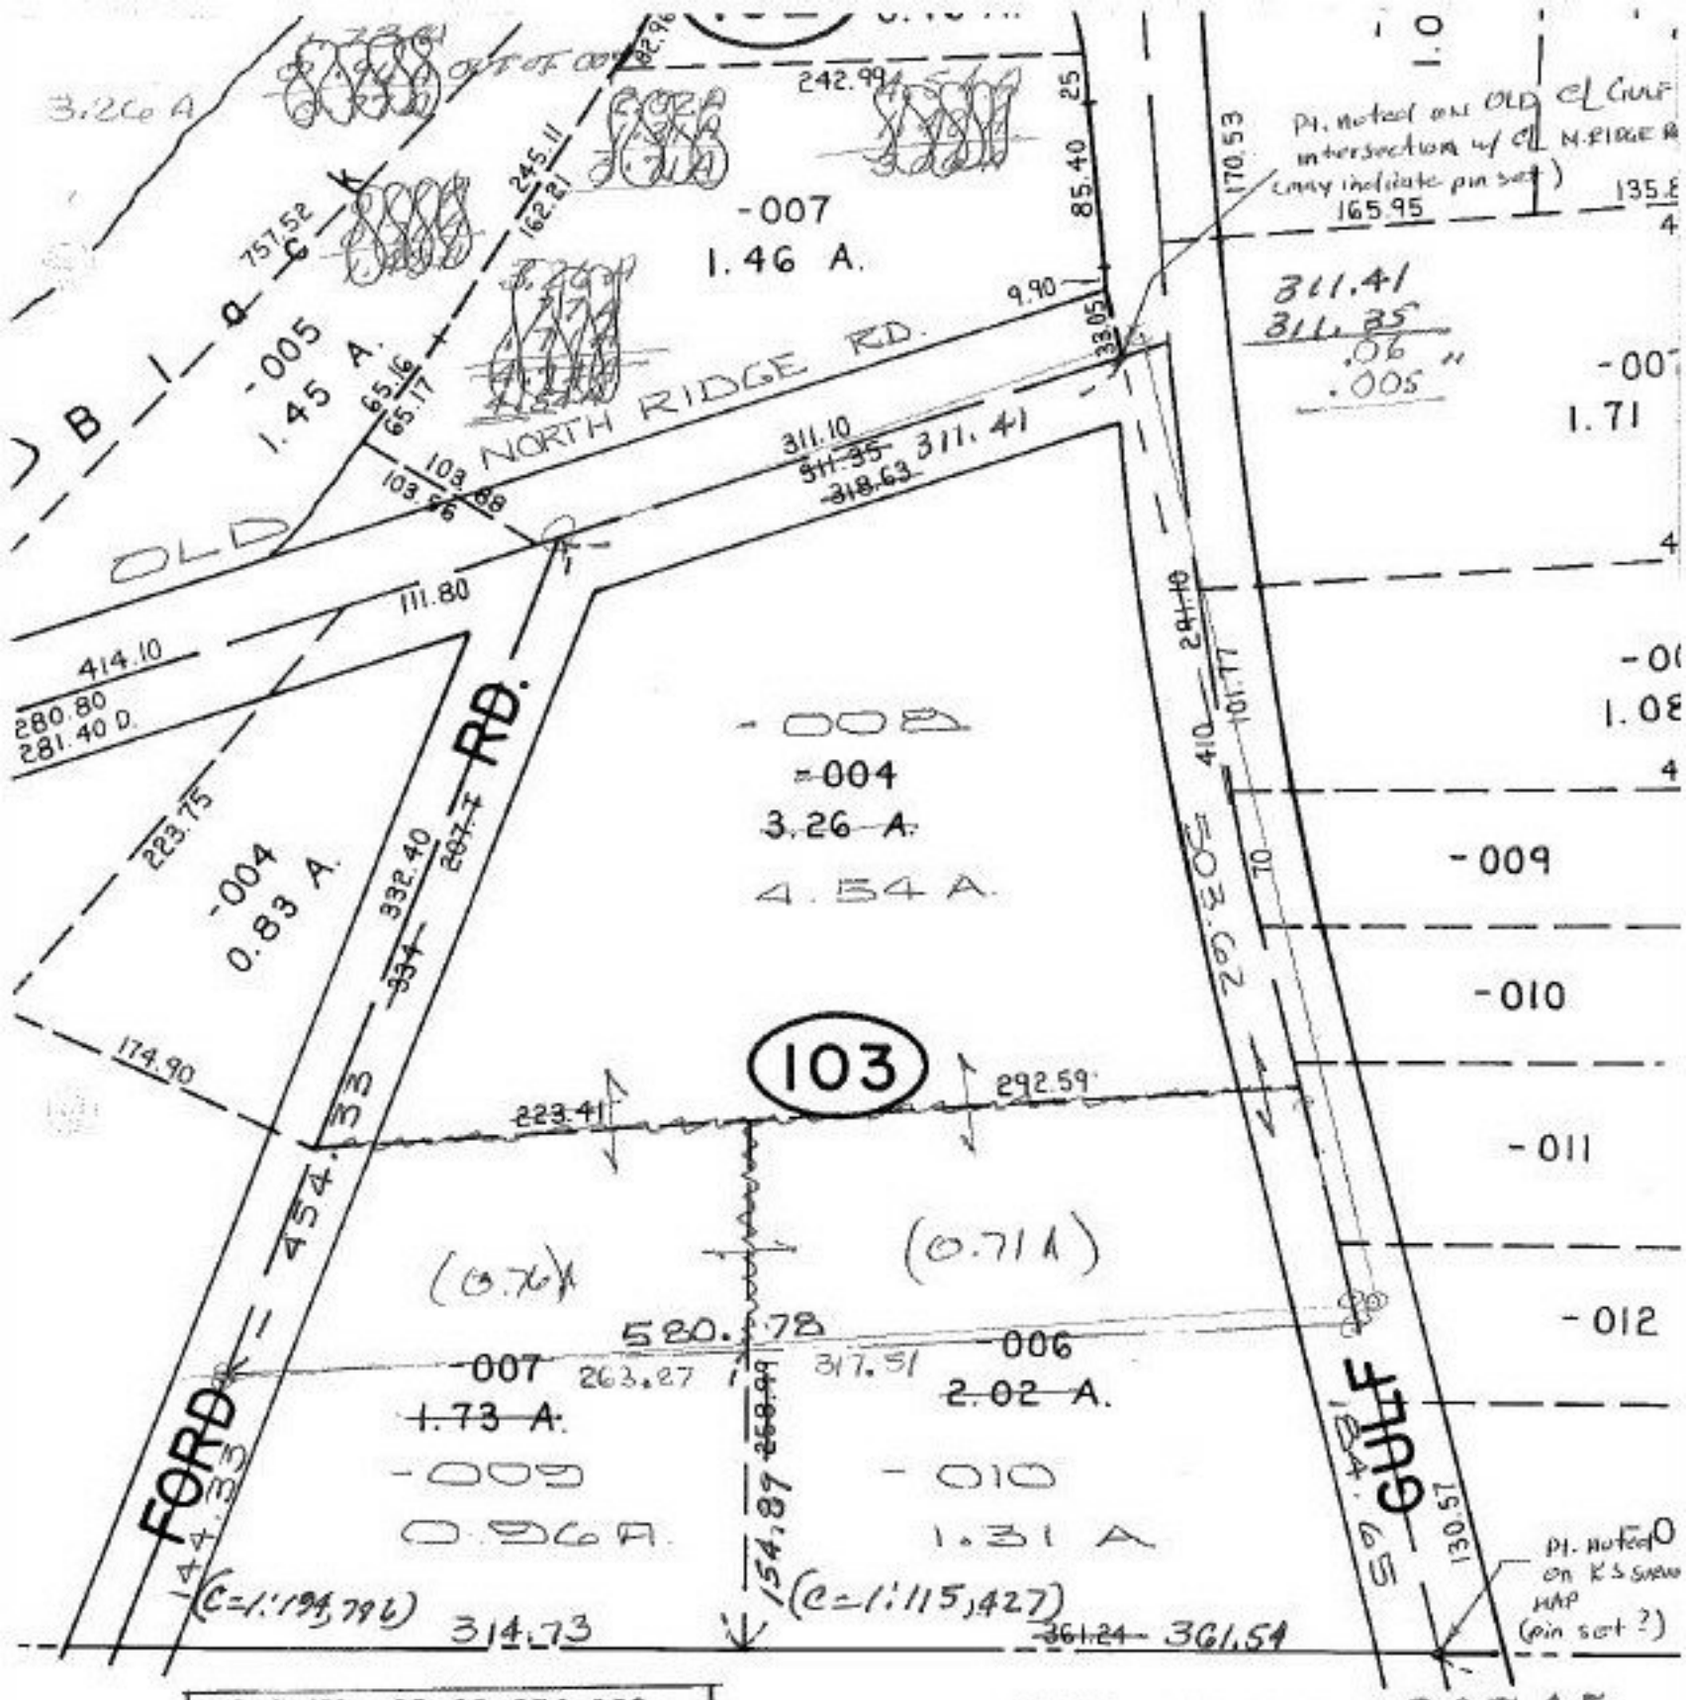

P.P.NO. 03-00-074-103-
PRIOR INST: DV. 970/547
O.R.313/524
CLOSURE: C=1:441,373
SURVEYED BY: KSA

* ALL PINS INDICATED ON EQ SURVEY MAP ARE NOT CLEAR AS TO FOUND/SET/OTHER

SEE 6-13

5/16/94

20745

APPROVED
LORAIN CO.
MAP DEPT.
DATE 2-28-94
PAGE 3-00-073-A
CAROLYN
BY FRANCIS
VOID AFTER # 20745