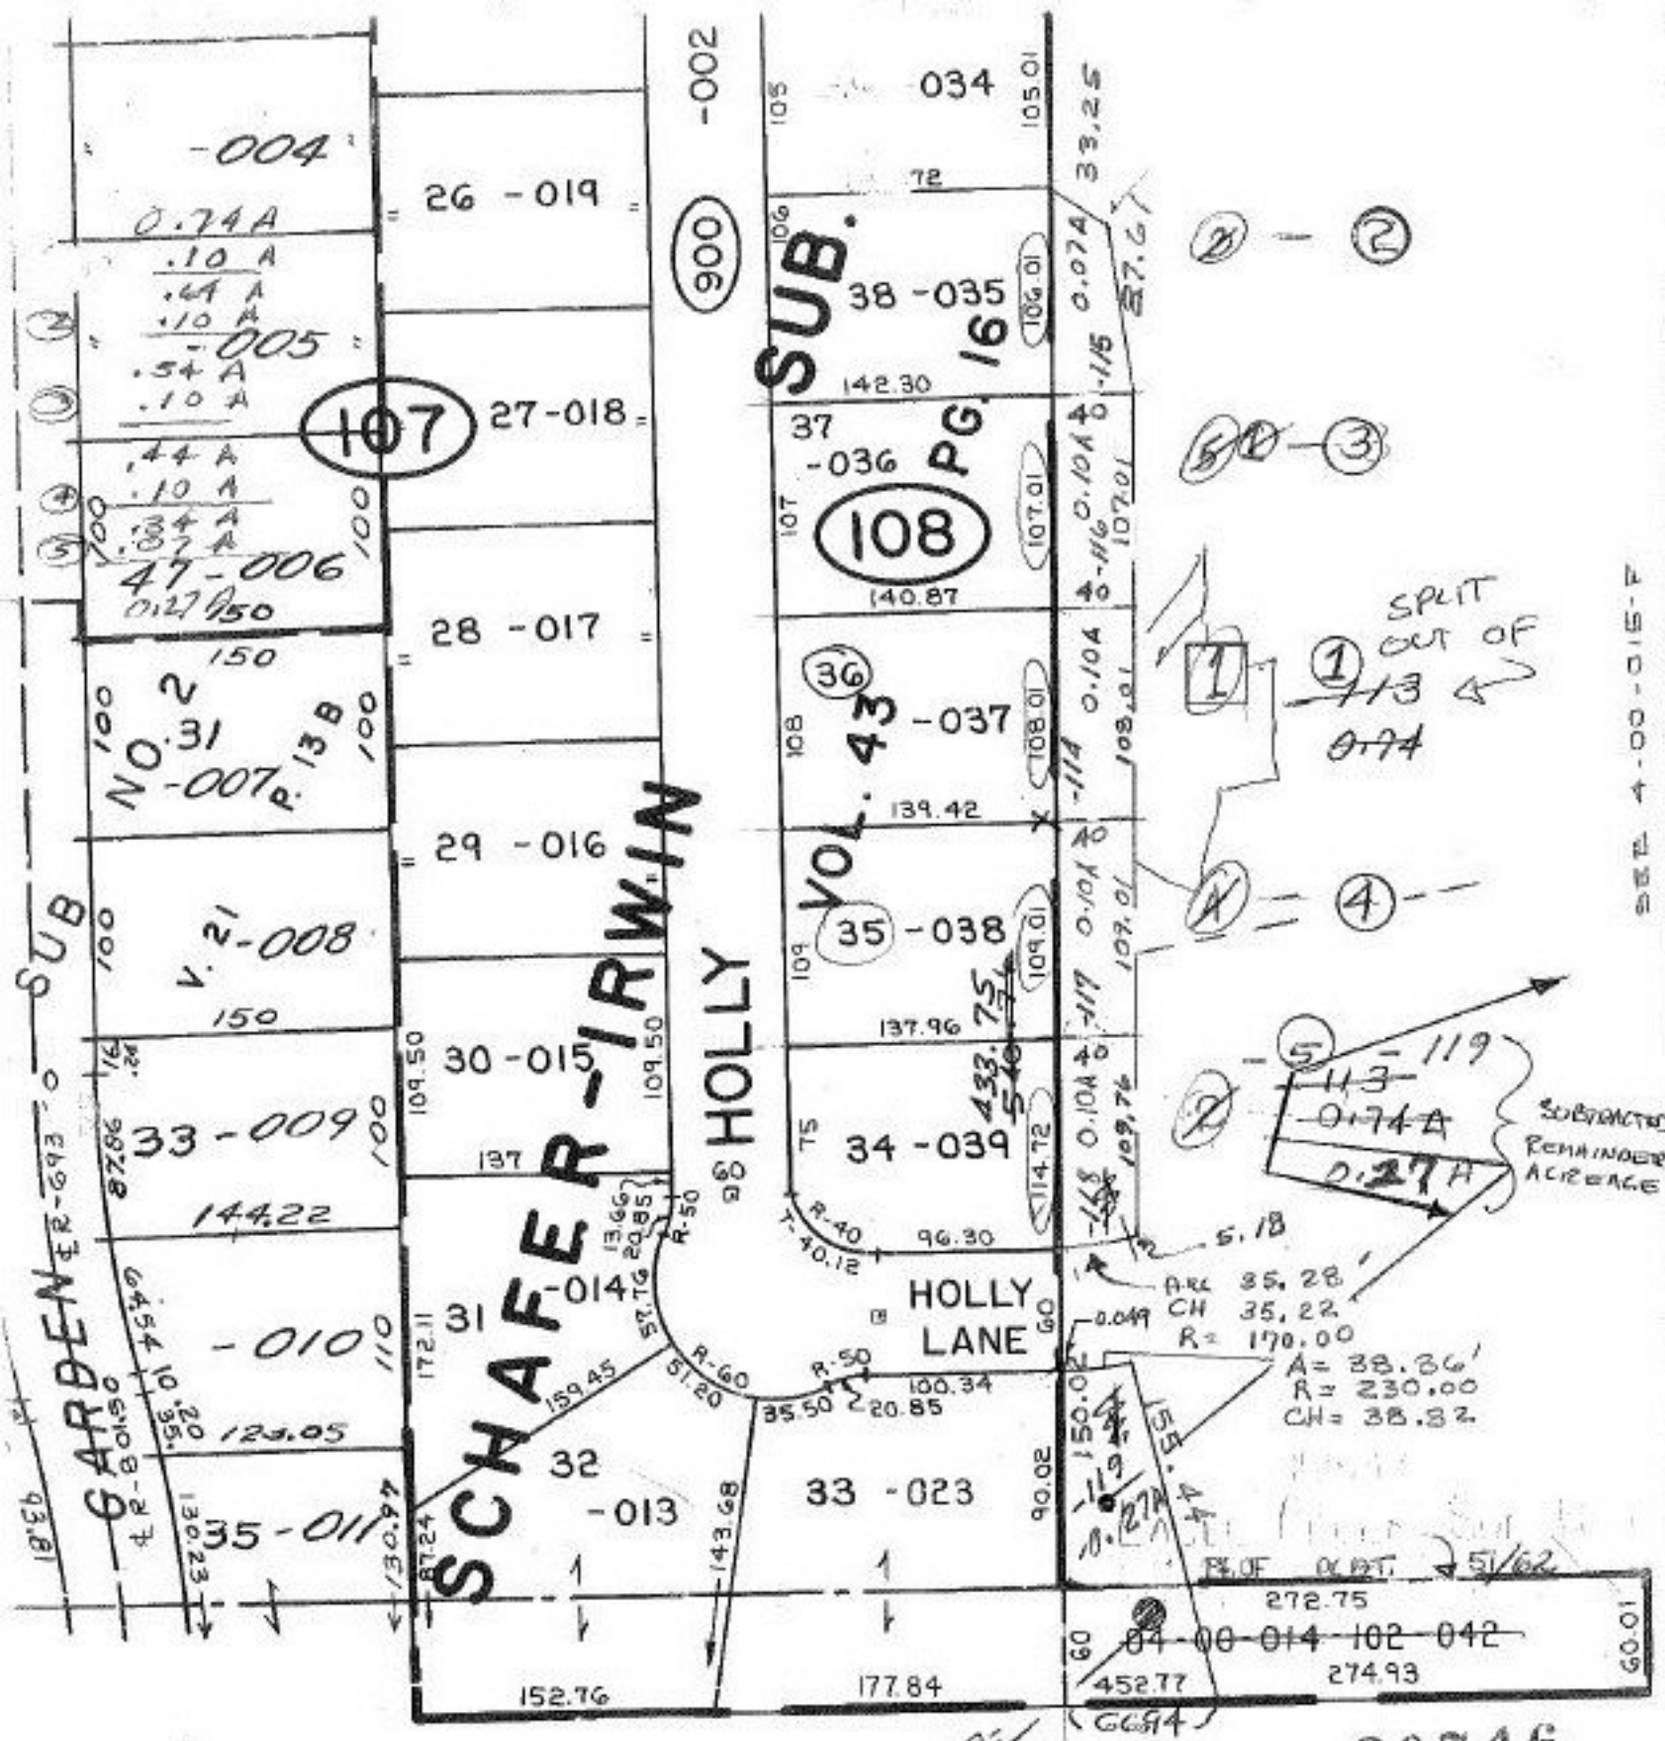
SUB.
SCHAFER-IRWIN
HOLLY
HOLLY LANE
SUB
GARBEN
-004
0.74A
.10 A
.44 A
.10 A
-005
.54 A
.10 A
.44 A
.10 A
.34 A
.87 A
47-006
0.27
150
NO. 2
NO. 31
-007
P. 13B
V. 21
-008
150
33-009
144.22
-010
125.05
35-011
130.23
130.97
87.24
143.68
177.84
152.76
26-019
27-018
28-017
29-016
30-015
109.50
137
34-039
96.30
R-40
R-50
R-60
51.20
159.45
100.34
20.85
35.50
31
-014
32
-013
33-023
90.02
150.0
272.75
274.93
452.77
(GGR4)
60.01
105
106
107
108
109
034
038
037
036
035
105.01
106.01
107.01
108.01
109.01
142.30
140.87
139.42
137.96
33.25
27.67
0.024
0.104
0.116
0.114
0.104
0.104
0.119
0.148
0.104
109.74
114.72
75
433
540
A=38.86'
R=230.00
CH=38.82
R=170.00
CH=35.22
ARC 35.28'
0.049
5.18
SPLIT OUT OF 113
0.74
SUBTRACTED REMAINDER ACREAGE
0.27A
SEE 4-00-015-F
SEE 4-00-014-A
P.P.NO. 04-00-015-109-
PRIOR INST: O.R.717/634
CLOSURE: 0.10 ac. 1,2,4 C=1:INF.
0.07 ac. 2 C=1:43,781
0.10 ac. 5 C=1:31,788
SURVEYED BY: HENRY G. REITZ ENG. CO.
04-00-014-102-043
6/22/94
20746
APPROVED
LORAIN CO.
MAP DEPT.
DATE 2-28-94
PAGE 4-00-015-E
BY CAROLYN FRANCIS
VOID AFTER # 20746