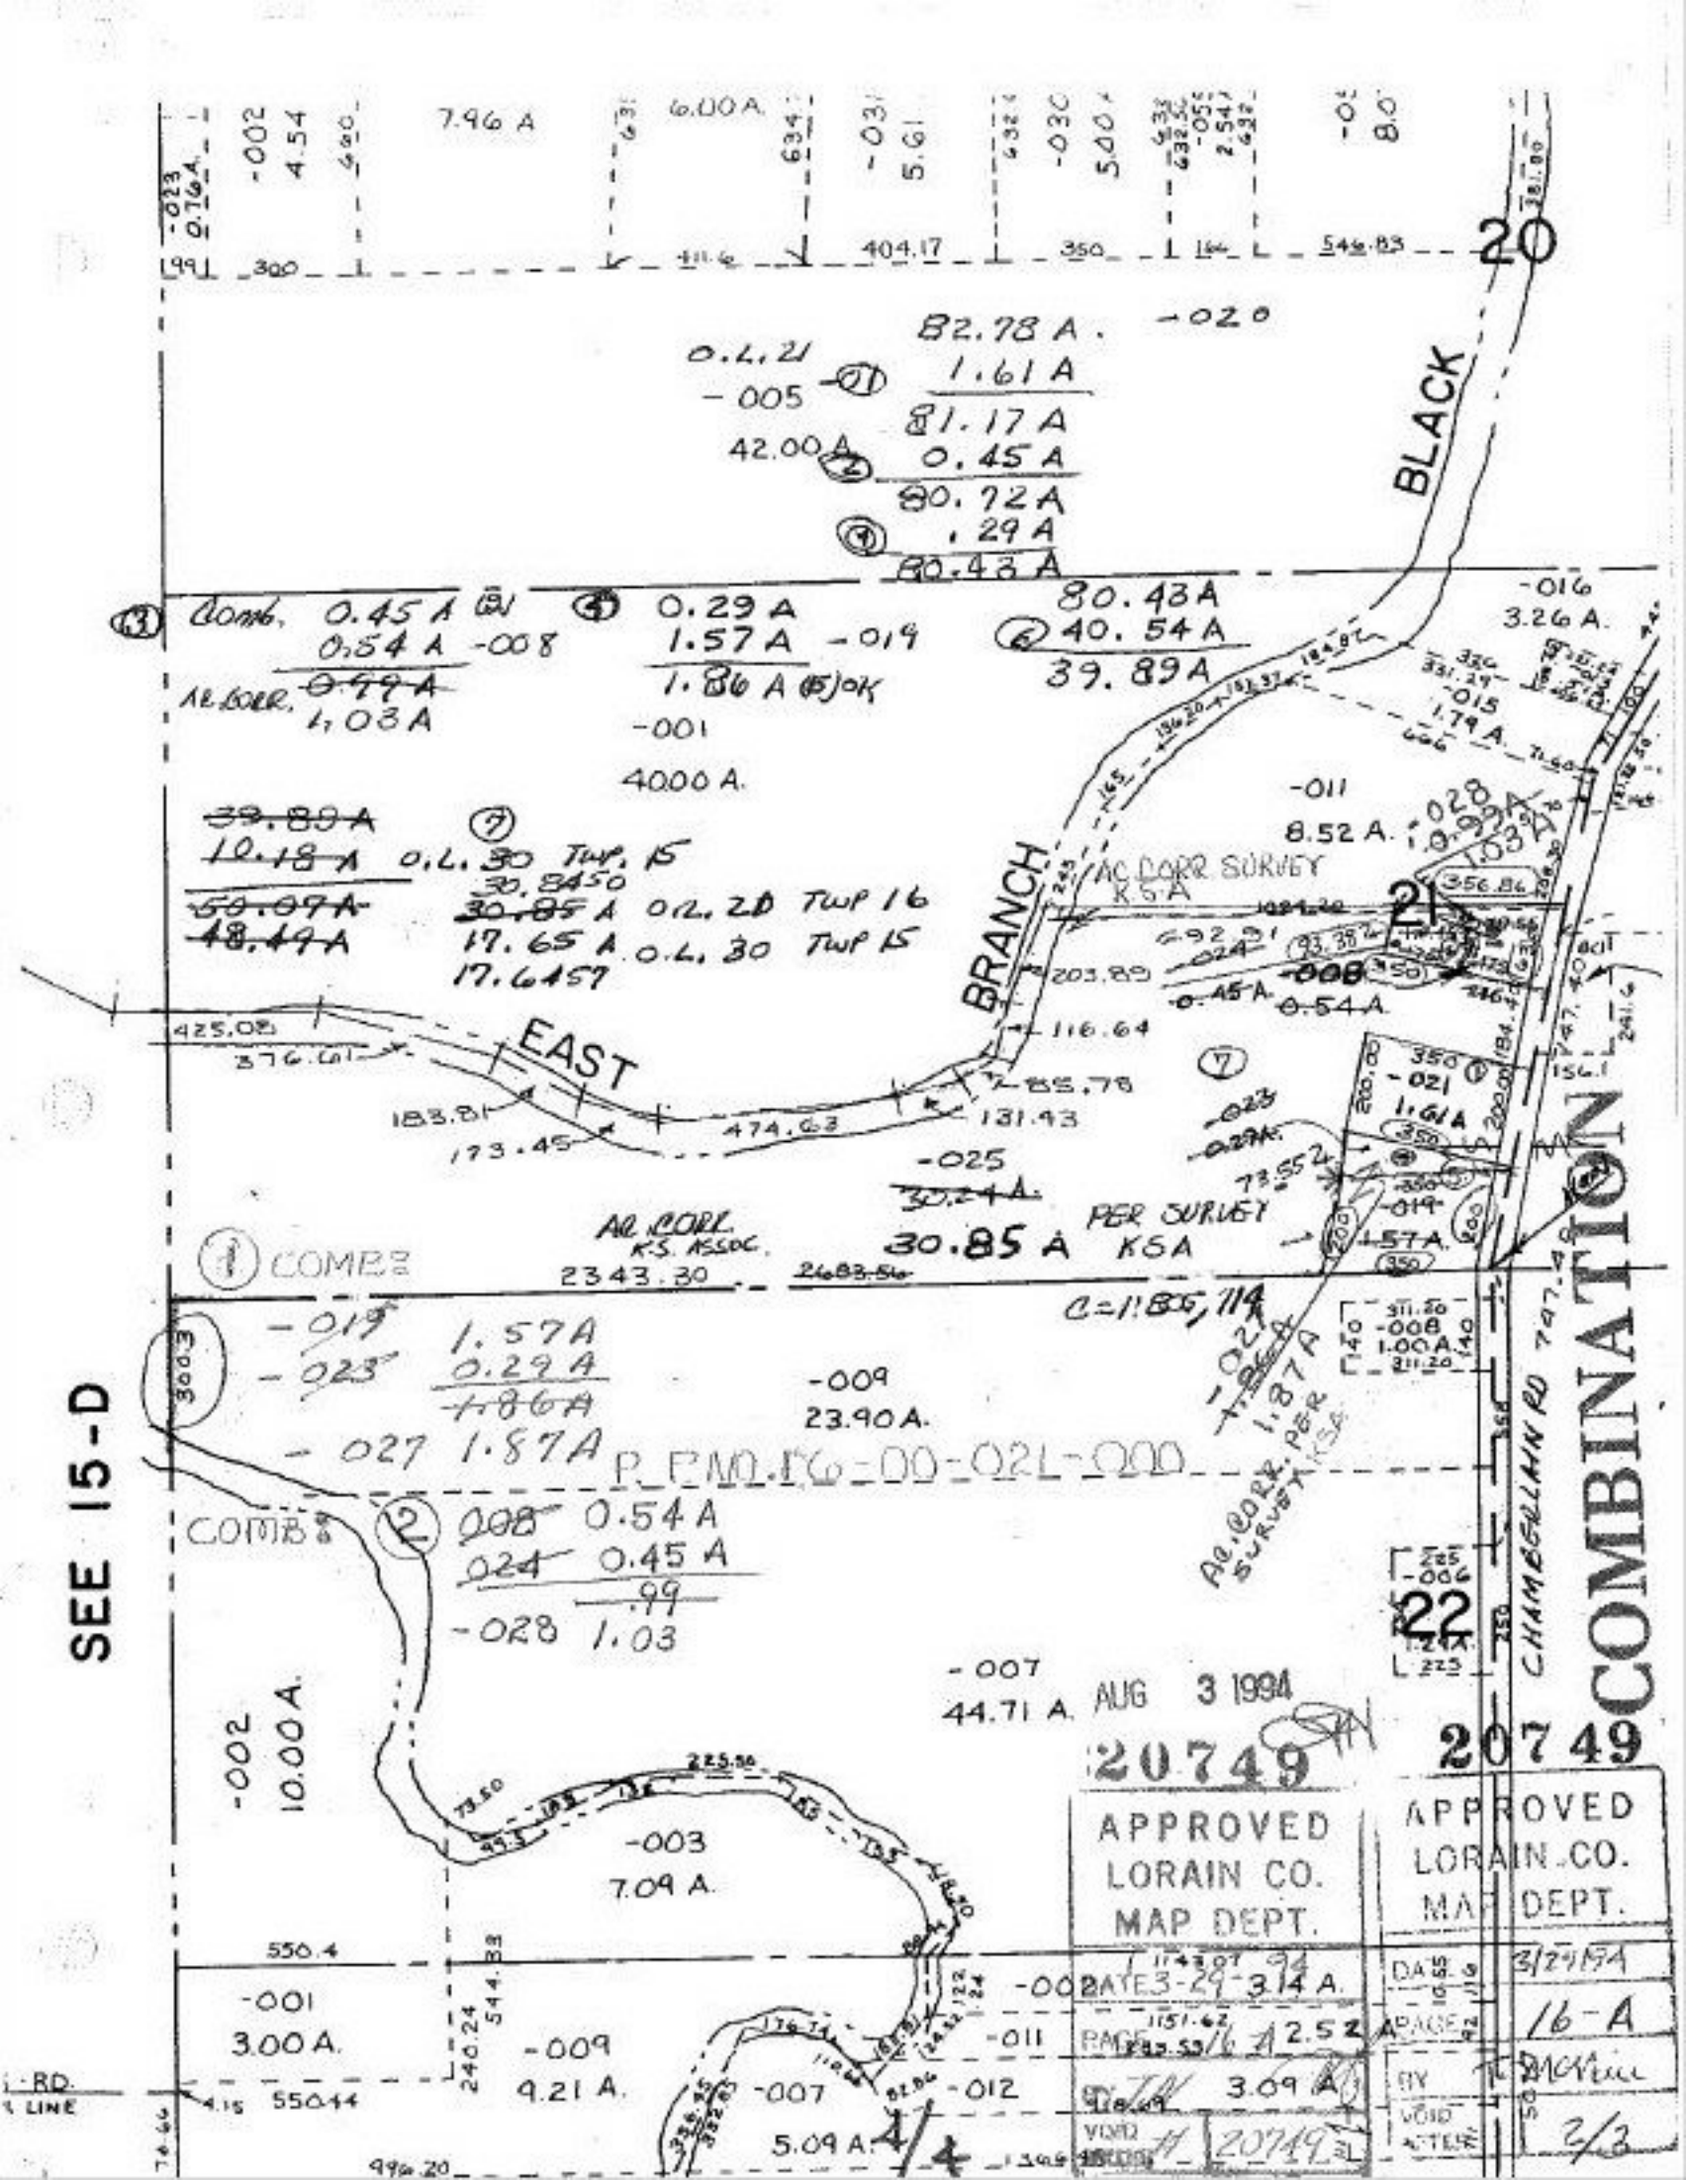

SEE 15-D
COMBINATION
BLACK
BRANCH
EAST
CHAMBERLAIN RD
20
21
22
82.78 A.
1.61 A
81.17 A
0.45 A
80.72 A
.29 A
80.43 A
0.45 A
0.54 A
1.03 A
0.29 A
1.57 A
1.86 A
80.43 A
40.54 A
39.89 A
40.00 A.
8.52 A.
AC CORR SURVEY K.S.A
30.85 A
PER SURVEY KSA
AC CORR. K.S. ASSOC.
2343.30
1.57 A
0.29 A
1.86 A
1.87 A
23.90 A.
P. PAO. 16-00-021-000
0.54 A
0.45 A
1.03
44.71 A.
10.00 A.
7.09 A.
3.00 A.
9.21 A.
5.09 A.
3.14 A.
2.52 A
3.09 A
20749
APPROVED LORAIN CO. MAP DEPT.
DATE 3-29-94
PAGE 16-A
BY
VOID
20749
APPROVED LORAIN CO. MAP DEPT.
DATE 3/29/94
PAGE 16-A
BY
VOID ATTEST
2/3