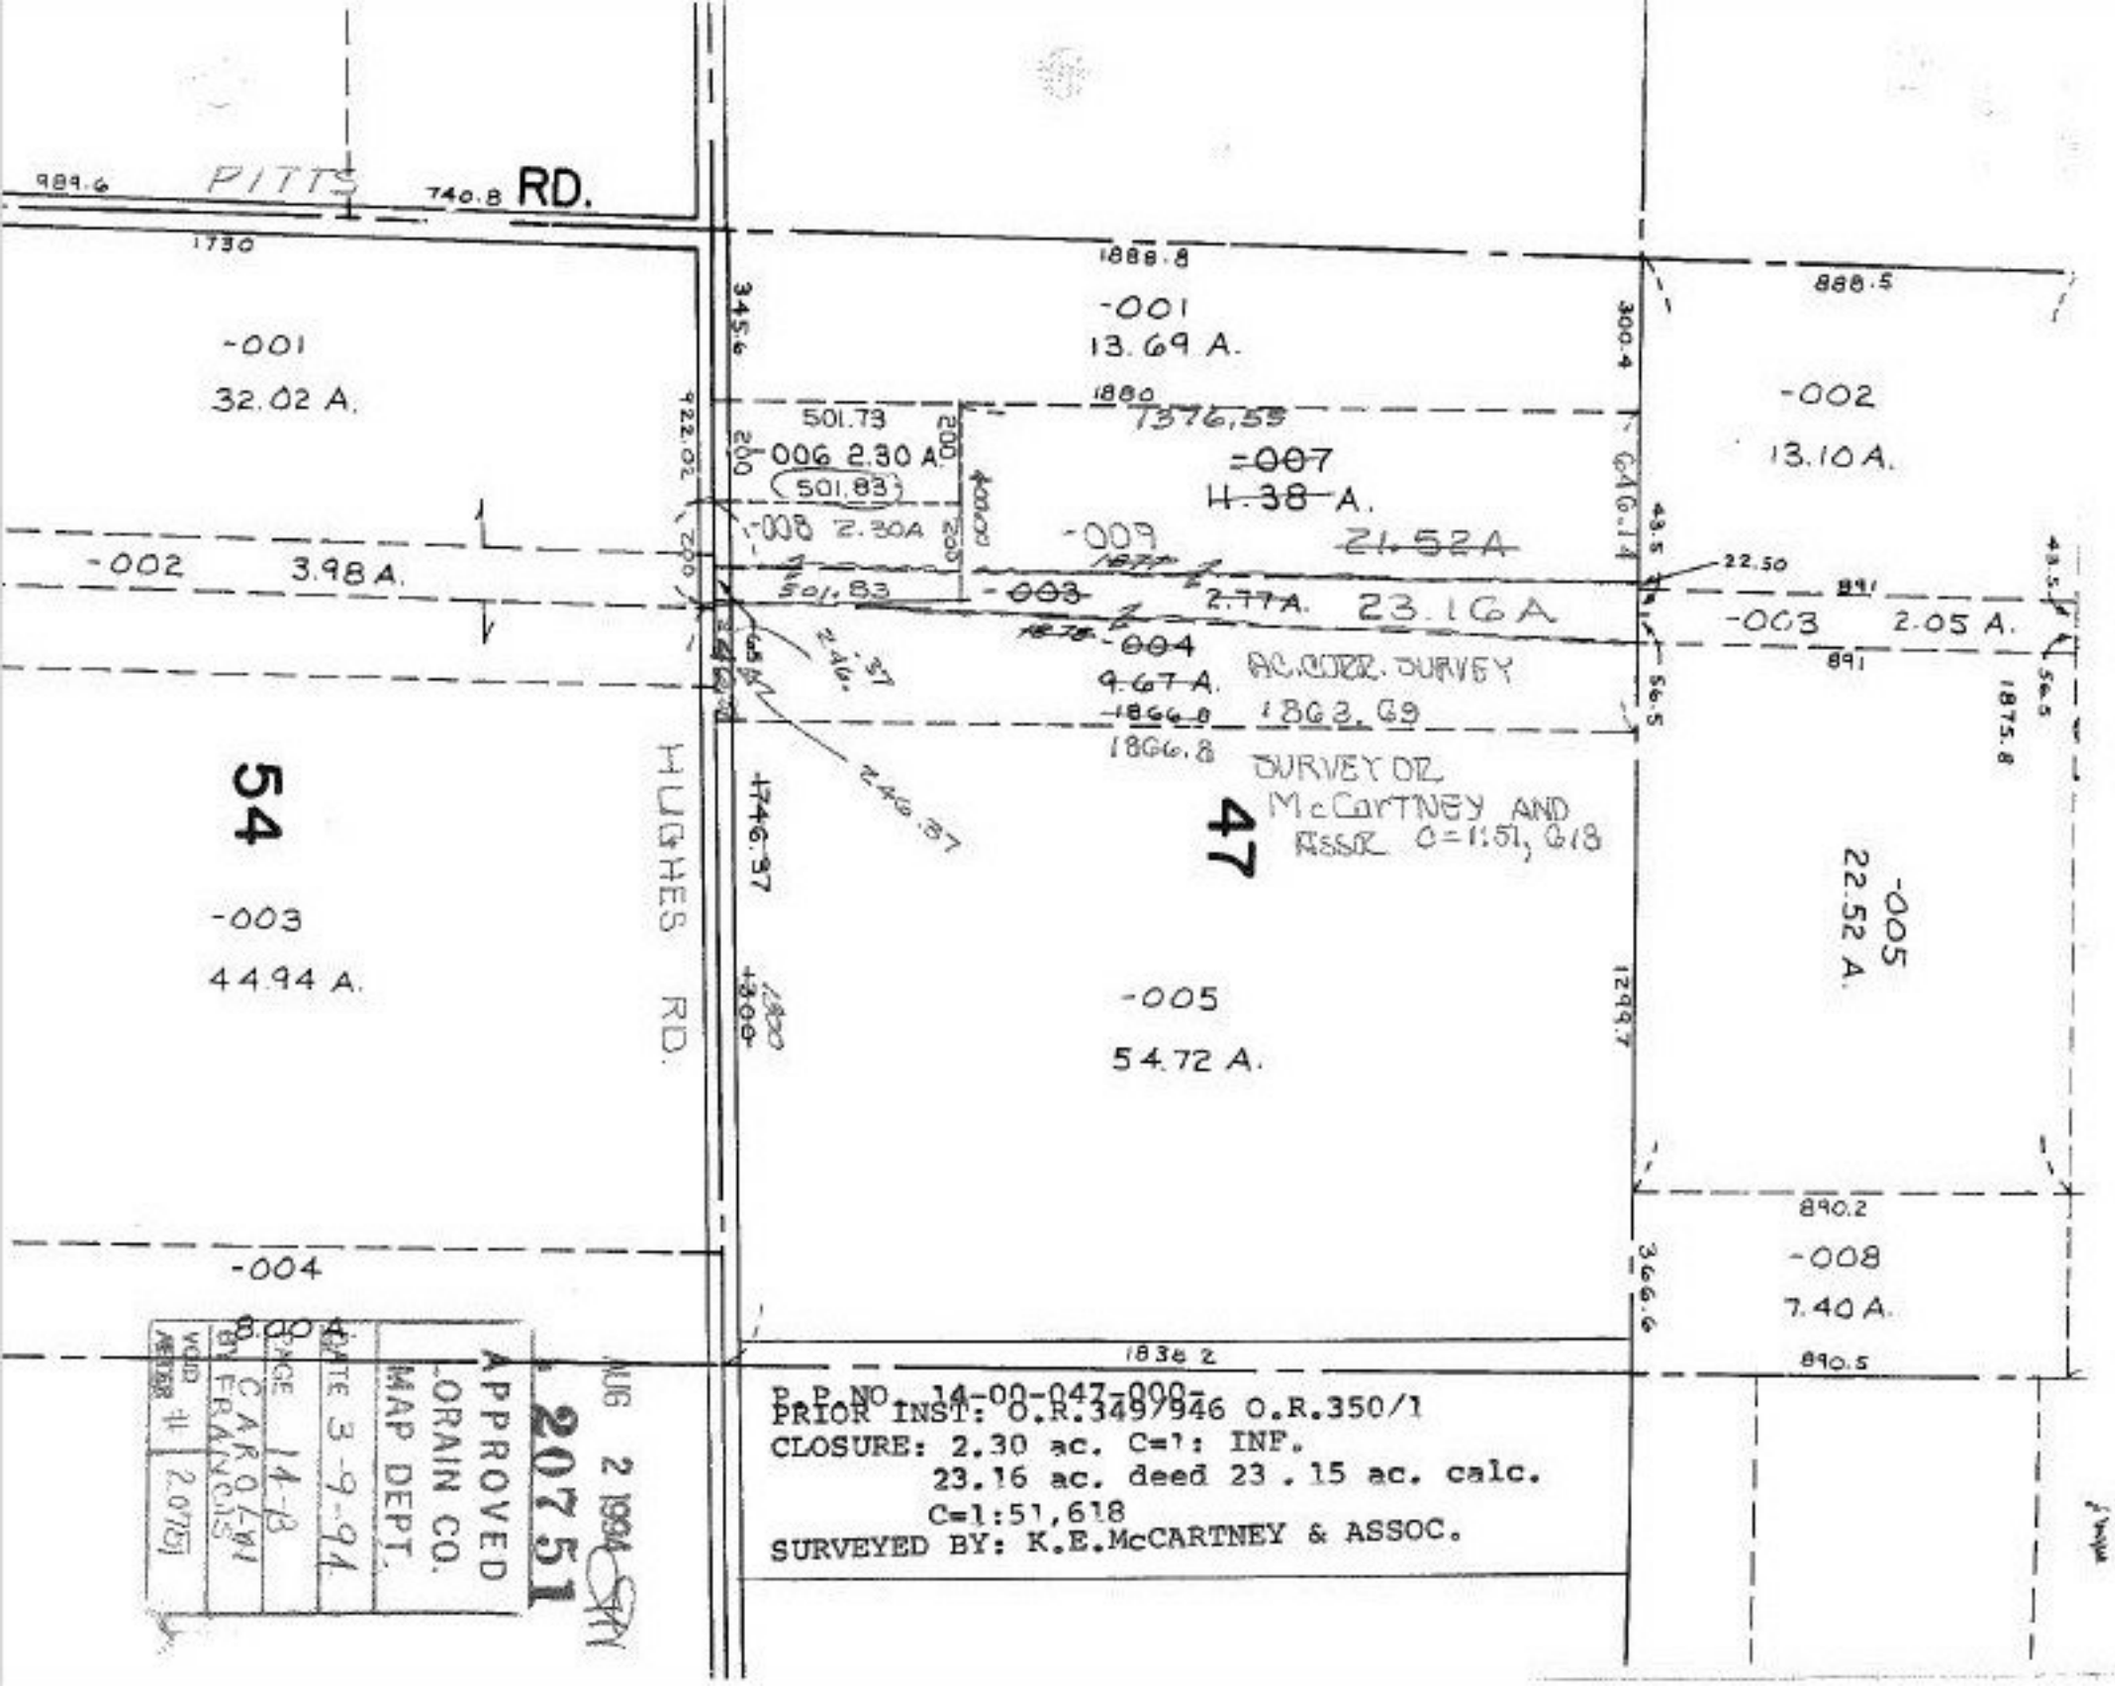
989.6
PITTS
740.8 RD.
1730
1888.8
888.5
-001
13.69 A.
-001
32.02 A.
345.6
300.4
1860
1376.59
501.73
200
006 2.30 A.
501.83
200
922.02
-008 2.30A
200
400.00
-007
11.38 A.
-009
21.52A
-002
13.10A.
646.14
43.5
22.50
-002 3.98 A.
501.83
-003
2.77A.
23.16A
-003 2.05 A.
-004
9.67 A.
AC. CORR. SURVEY
1866.8
1863.69
1866.8
SURVEY OF
McCARTNEY AND
ASSOC. C=1:51,618
54
-003
44.94 A.
HUGHES RD.
47
-005
54.72 A.
-005
22.52 A.
1299.7
890.2
-008
7.40 A.
366.6
890.5
-004
1838.2
P.P. NO. 14-00-047-000-
PRIOR INST: O.R.349/946 O.R.350/1
CLOSURE: 2.30 ac. C=1: INF.
23.16 ac. deed 23.15 ac. calc.
C=1:51,618
SURVEYED BY: K.E.McCARTNEY & ASSOC.
APPROVED
AUG 2 1994
20751
-ORAIN CO.
MAP DEPT.
DATE 3-9-94
PAGE 14-8
BY CAROL-WI FRANCIS
VOID
2.0751