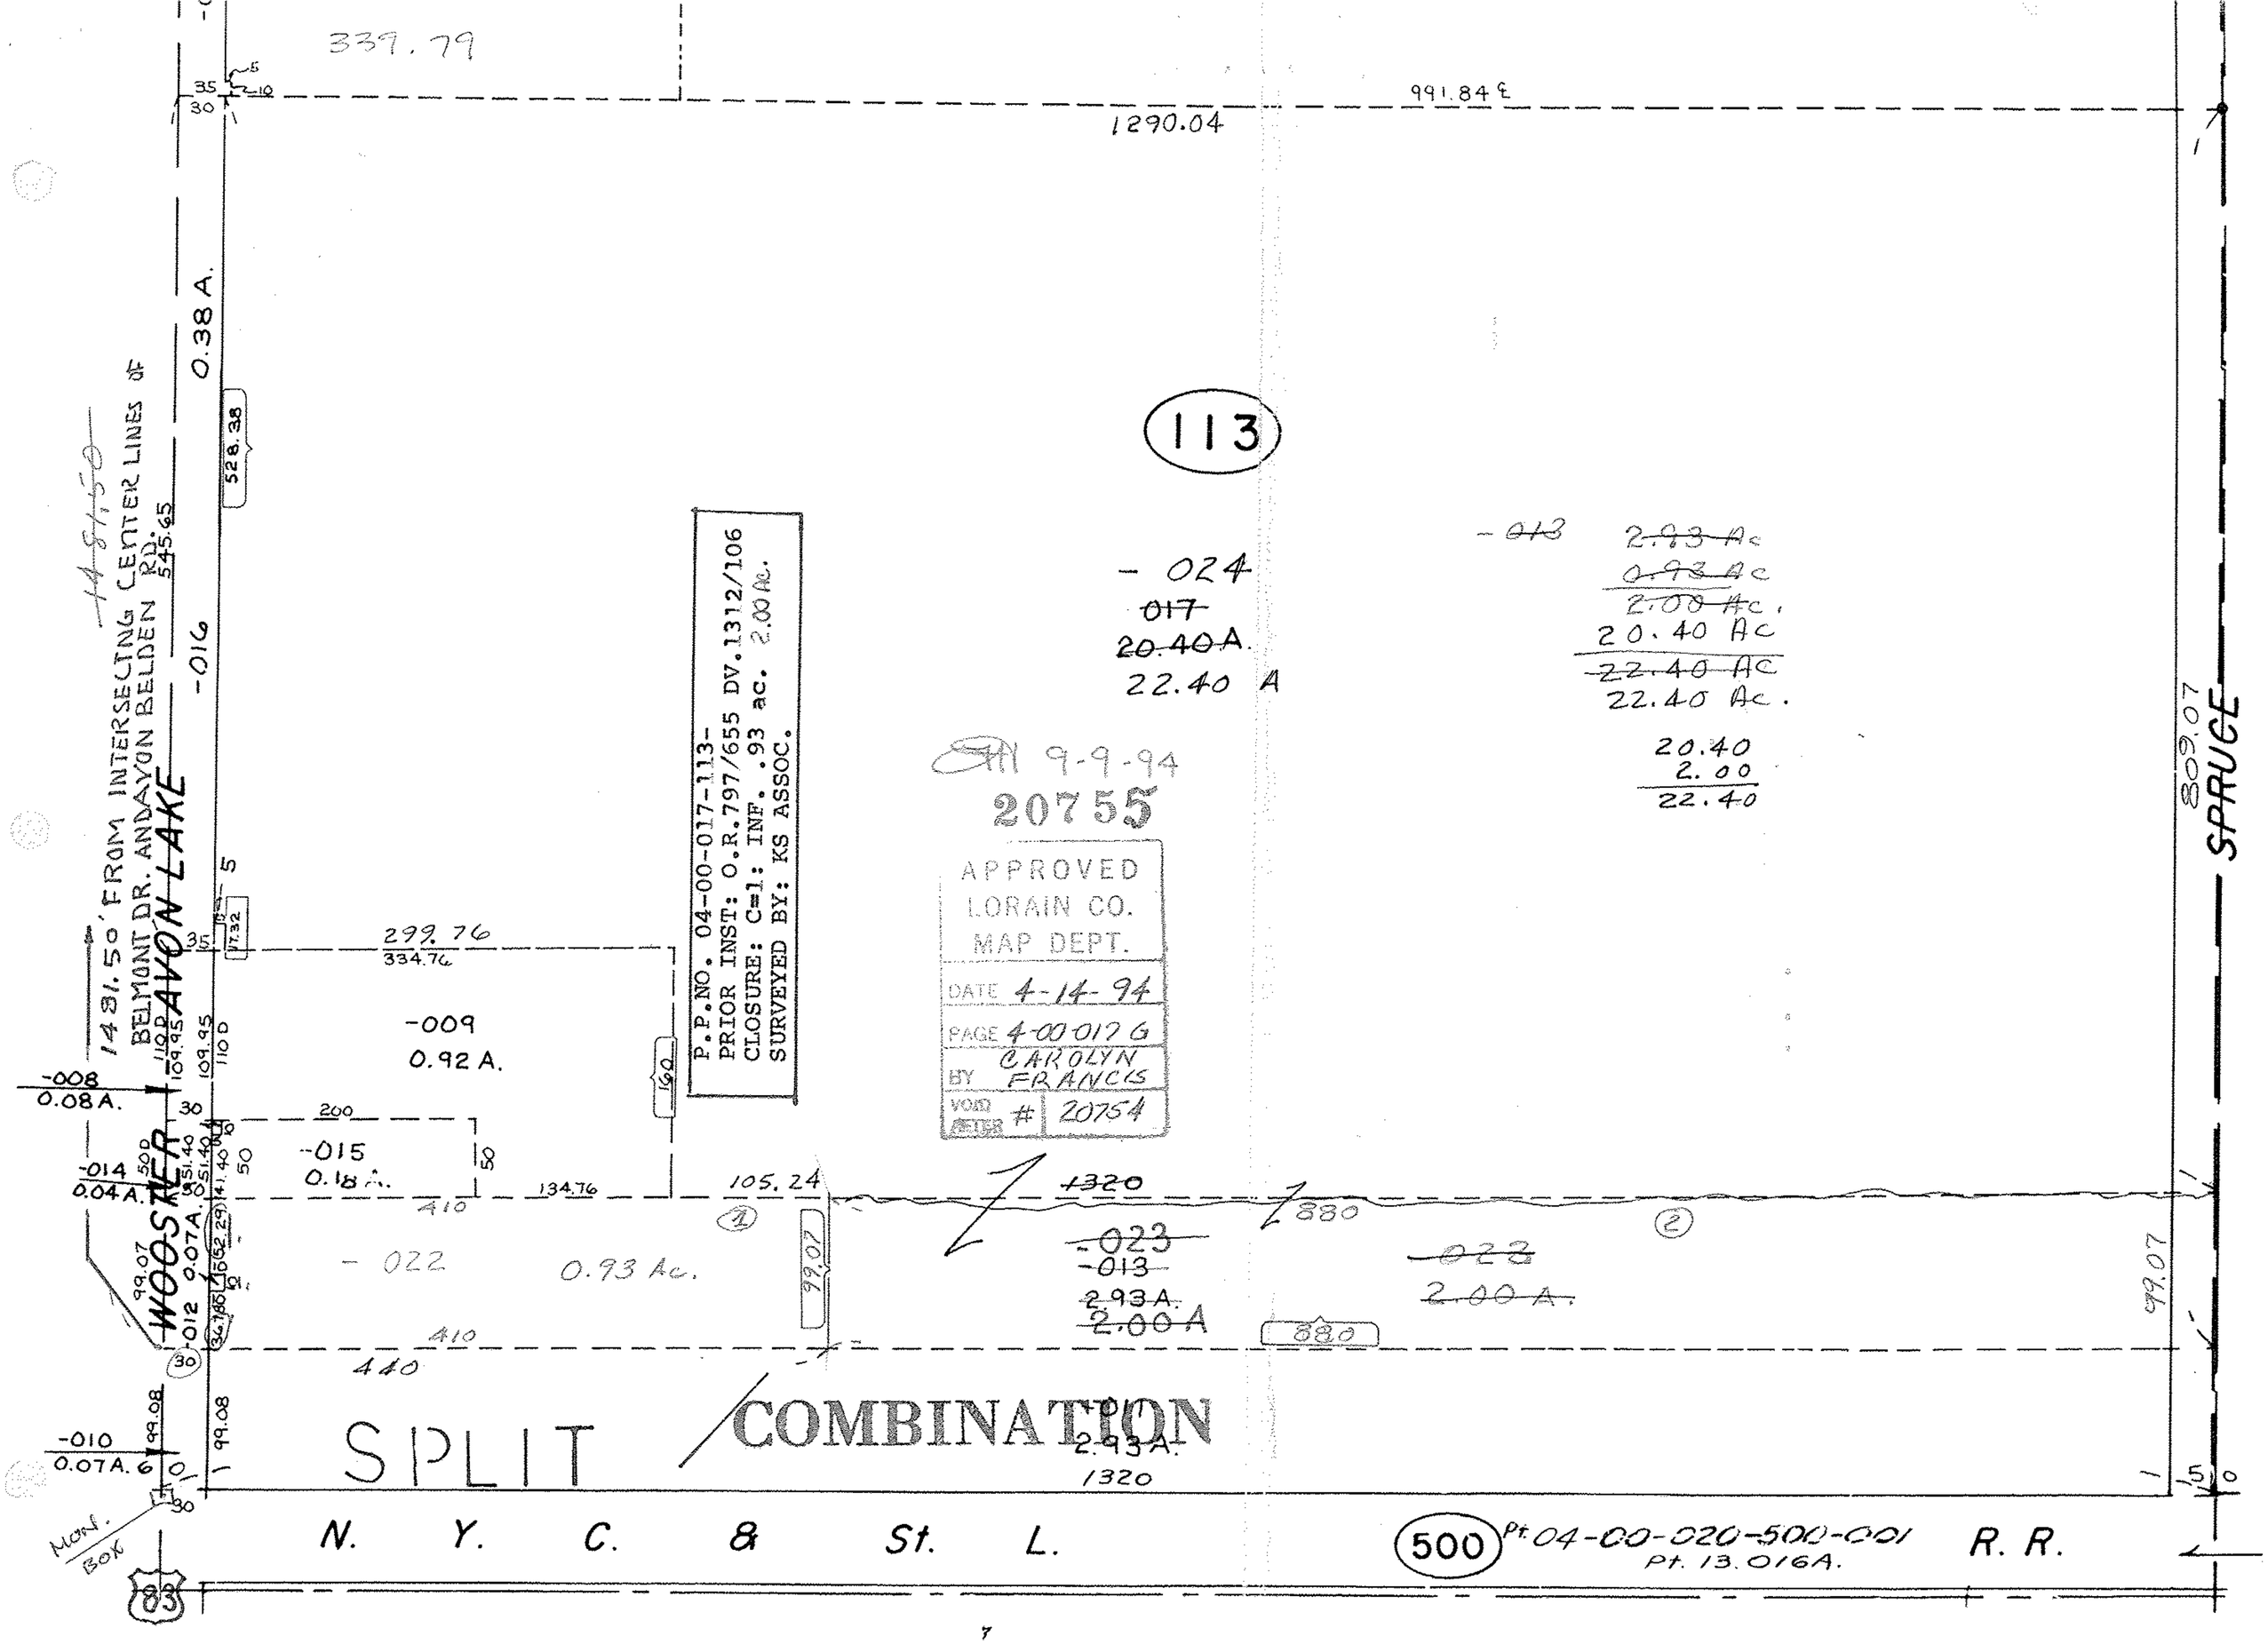
339.79
991.84 ℄
1290.04
113
0.38 A.
528.38
1481.50 FROM INTERSECTING CENTER LINES OF
BELMONT DR. ANDAVON BELDEN RD.
545.65
-016
WOOSTER AVON LAKE
P.P.NO. 04-00-017-113-
PRIOR INST: O.R.797/655 DV.1312/106
CLOSURE: C=1: INF. .93 ac. 2.00 Ac.
SURVEYED BY: KS ASSOC.
-024
~~017~~
~~20.40 A.~~
22.40 A
~~-013~~
~~2.93 Ac~~
~~0.93 Ac~~
~~2.00 Ac.~~
20.40 Ac
~~22.40 Ac~~
22.40 Ac.
20.40
2.00
22.40
9-9-94
20755
APPROVED
LORAIN CO.
MAP DEPT.
DATE 4-14-94
PAGE 4-00-017 G
BY CAROLYN FRANCIS
VOID METER # 20754
299.76
334.76
-009
0.92 A.
-008
0.08 A.
-015
0.18 A.
-014
0.04 A.
134.76
105.24
~~1320~~
880
-022
0.93 Ac.
~~-023~~
~~-013~~
~~2.93 A.~~
~~2.00 A~~
~~-022~~
~~2.00 A.~~
880
410
440
-012
0.07 A.
-010
0.07 A.
SPLIT
COMBINATION
~~-011~~
2.93 A.
1320
809.07
SPRUCE
N. Y. C. & St. L.
500 Pt. 04-00-020-500-001
Pt. 13.016A.
R. R.
Mon. Box
83