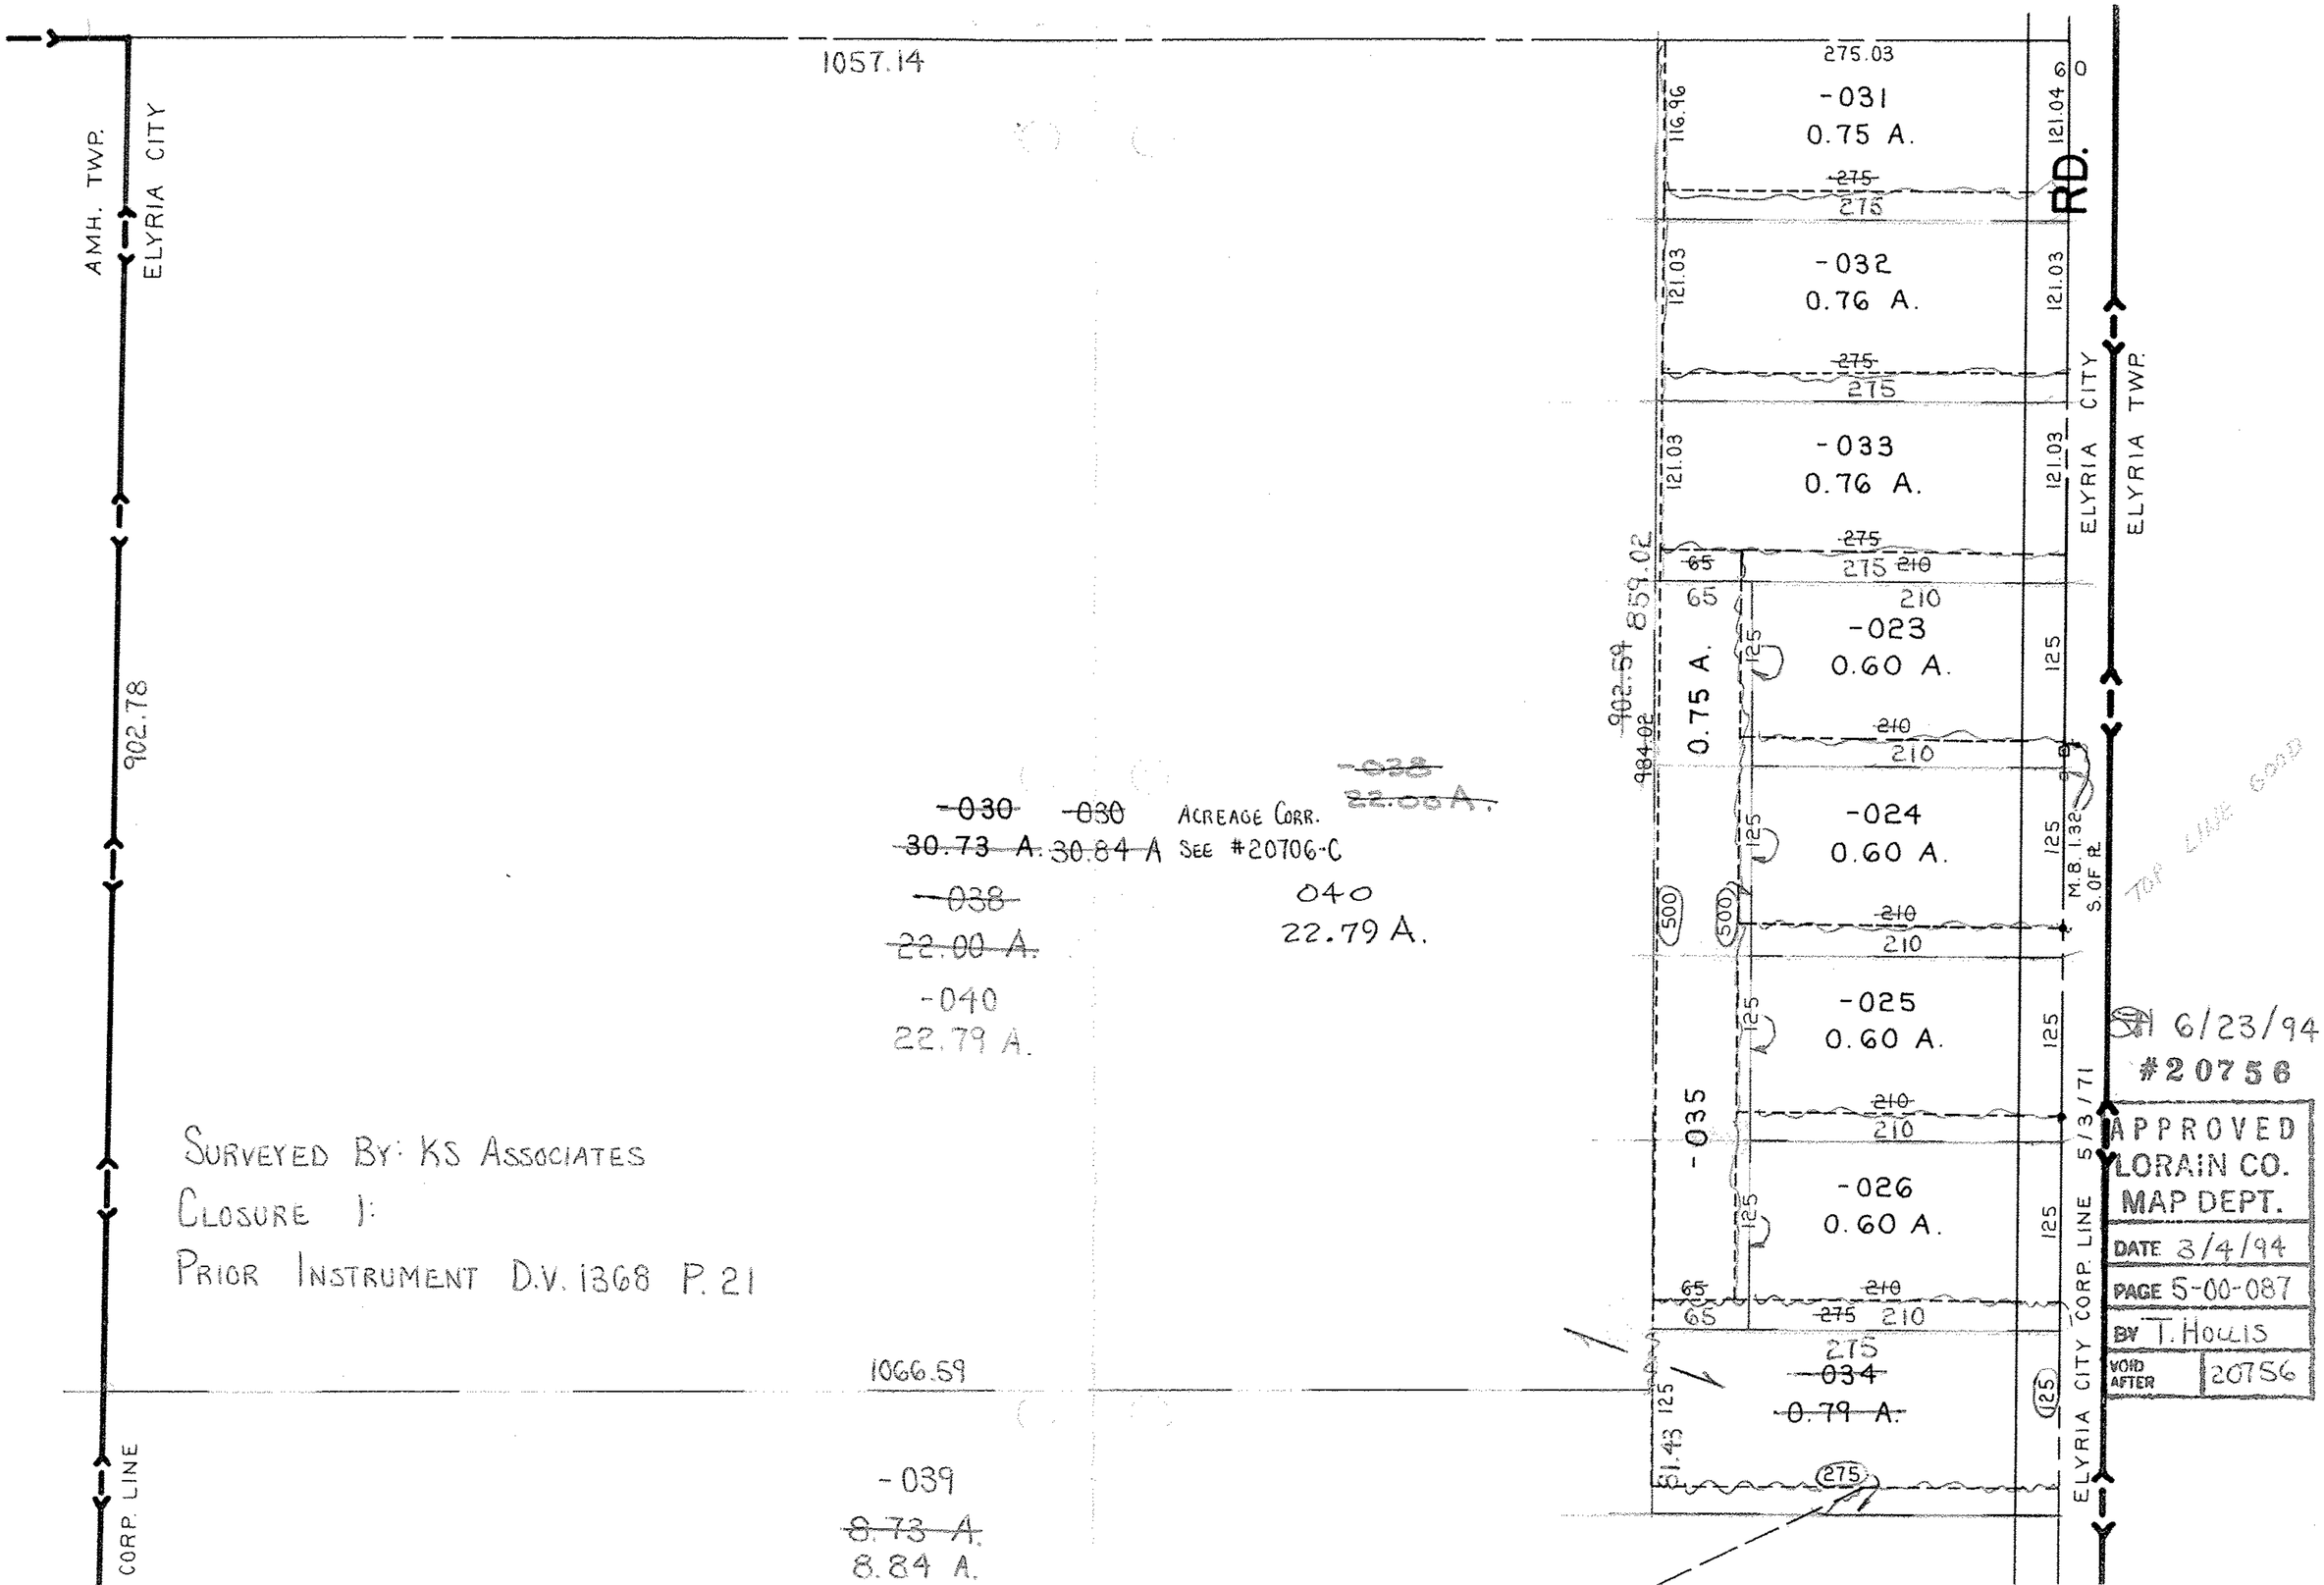
1057.14
AMH. TWP.
ELYRIA CITY
902.78
275.03
-031
0.75 A.
116.96
121.04
60
RD.
-032
0.76 A.
121.03
-033
0.76 A.
ELYRIA CITY
ELYRIA TWP.
859.02
902.59
984.02
0.75 A.
-023
0.60 A.
125
-024
0.60 A.
M.B. 1.32
S.OF R.
500
-025
0.60 A.
-035
-026
0.60 A.
65
210
275
-034
0.79 A.
81.43
ELYRIA CITY CORP. LINE 5/3/71
-030 -030 ACREAGE CORR.
30.73 A. 30.84 A SEE #20706-C
-038
22.00 A.
-040
22.79 A.
040
22.79 A.
SURVEYED BY: KS ASSOCIATES
CLOSURE 1:
PRIOR INSTRUMENT D.V. 1368 P. 21
1066.59
-039
8.73 A.
8.84 A.
CORP. LINE
TOP LINE
6/23/94
#20756
APPROVED
LORAIN CO.
MAP DEPT.
DATE 3/4/94
PAGE 5-00-087
BY T. HOLLIS
VOID AFTER 20756