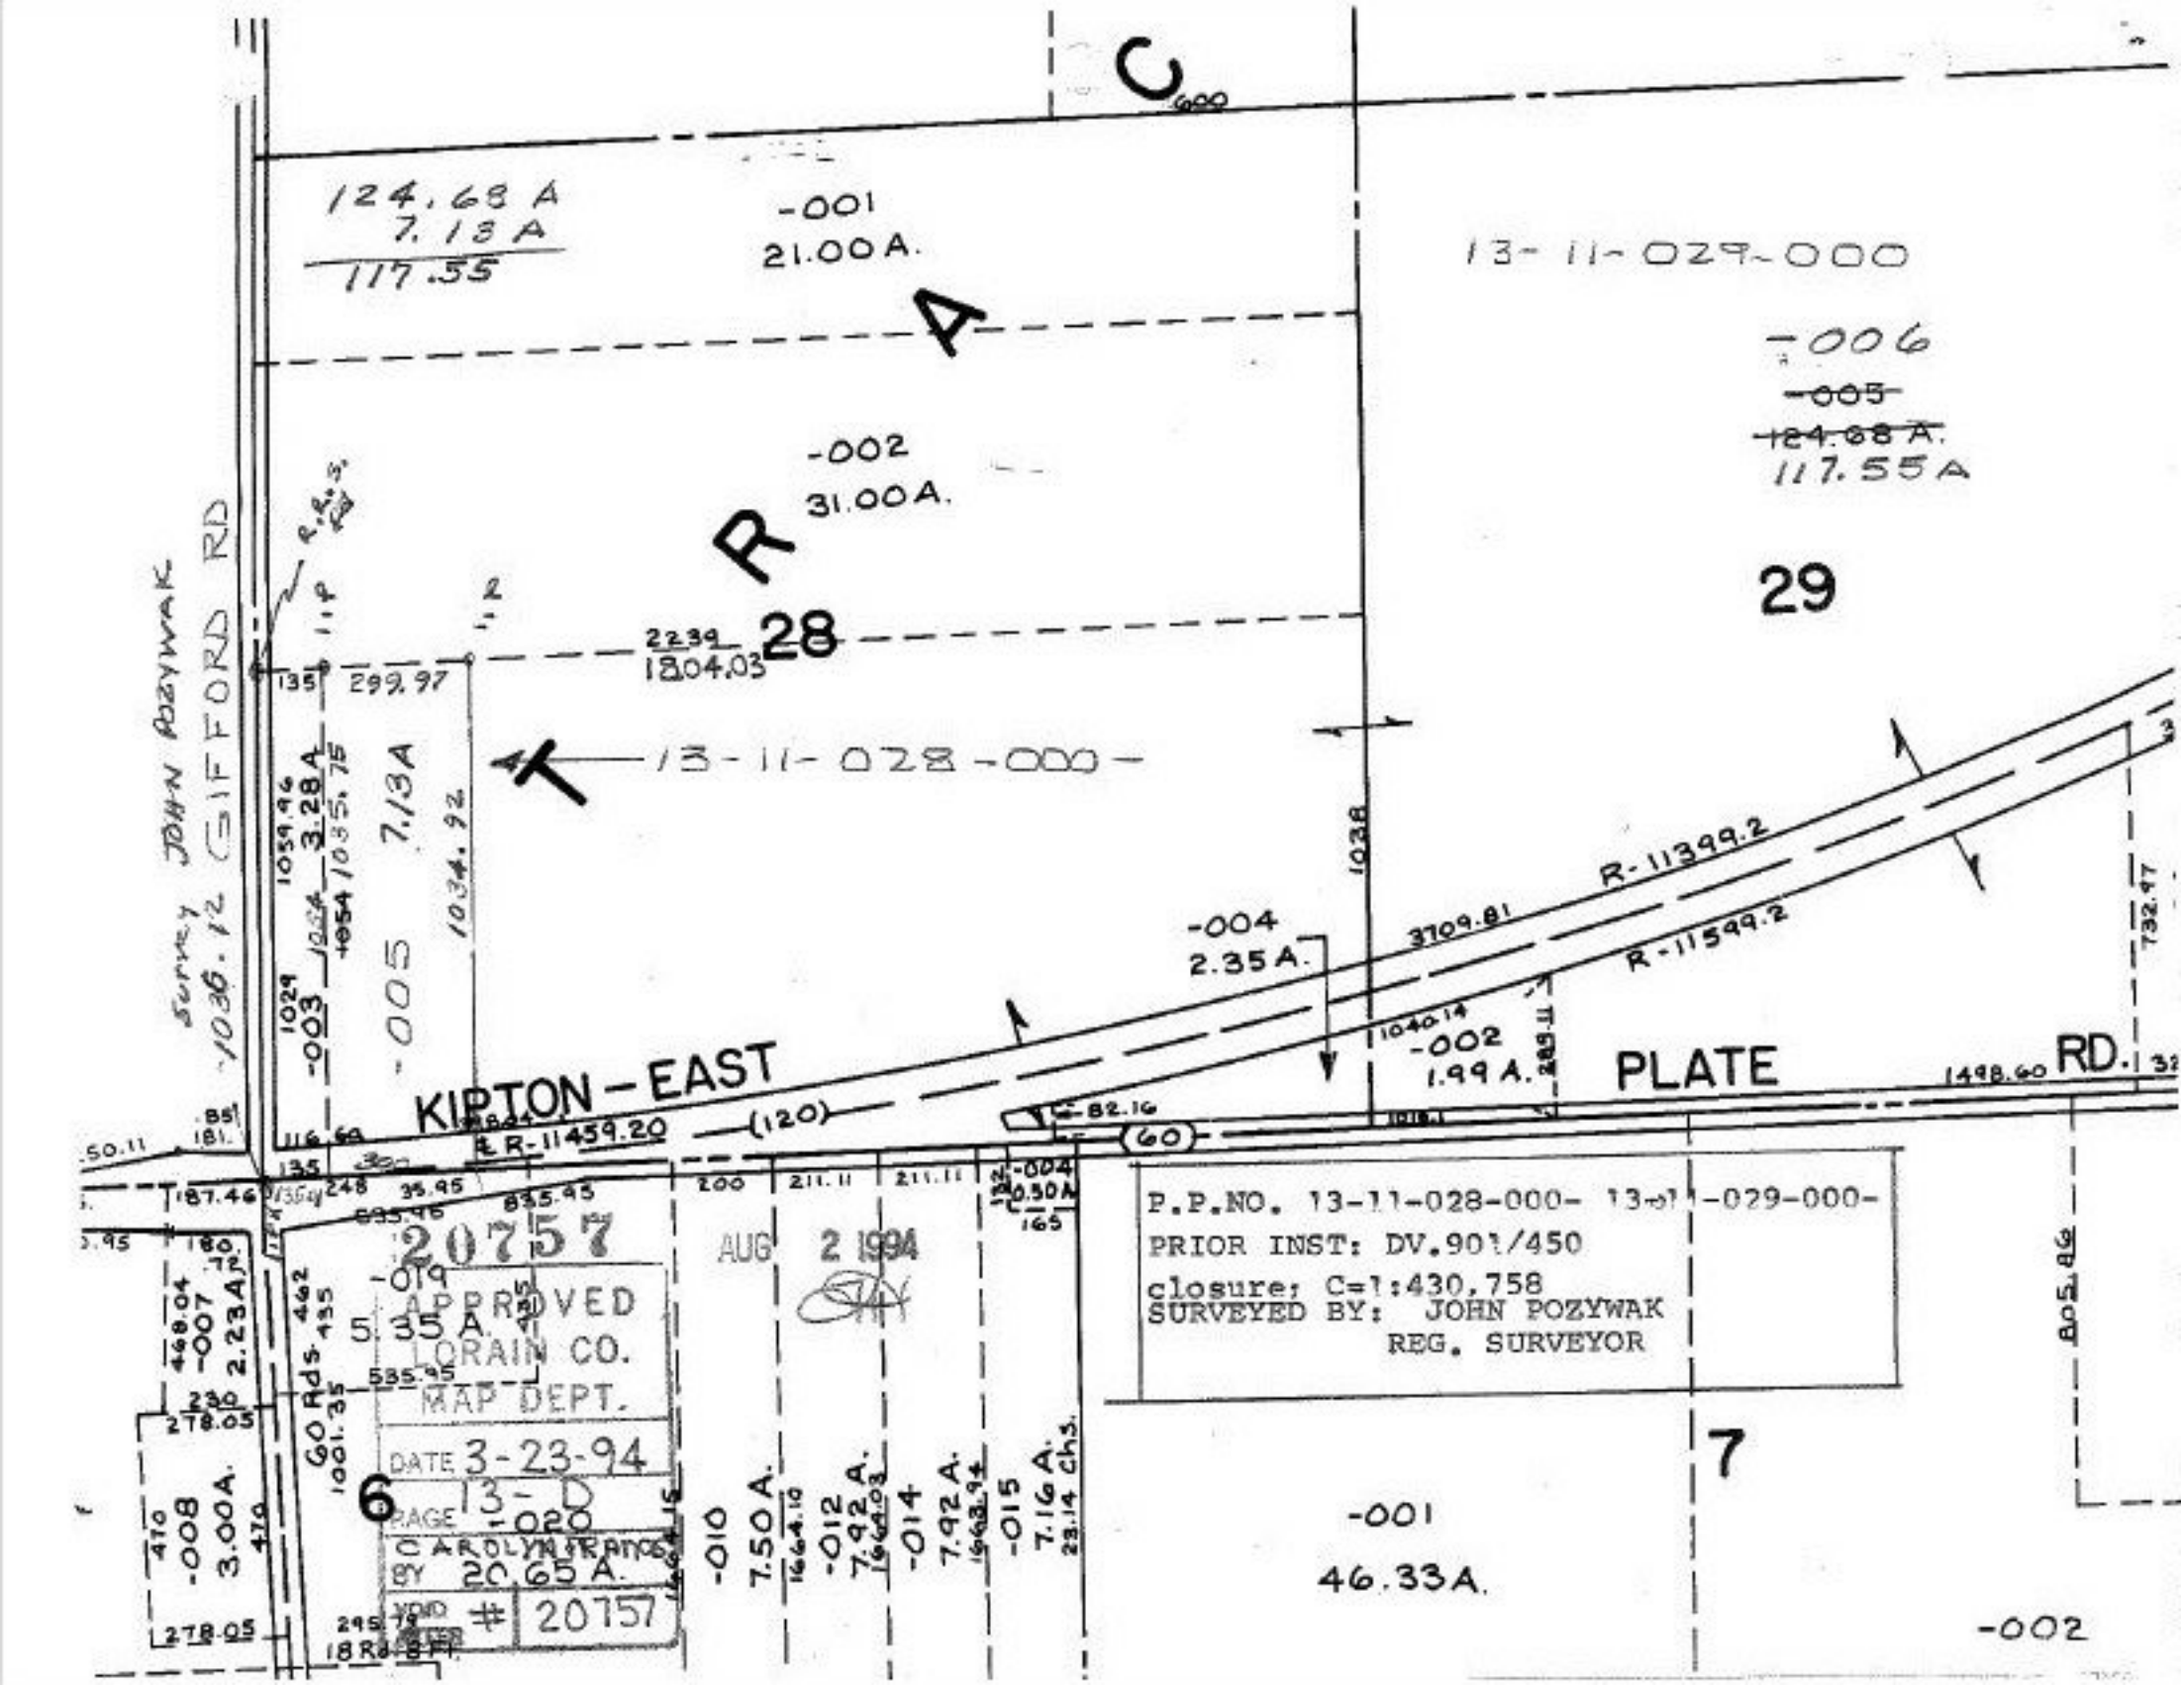

124.68 A
7.13 A
117.55
-001
21.00 A.
13-11-029-000
-006
~~-005~~
~~124.68 A.~~
117.55 A
-002
31.00 A.
29
28
2239
1804.03
13-11-028-000
Survey JOHN POZYWAK
1036.12 GIFFORD RD
299.97
3.28 A
1035.75
7.13 A
1034.92
-005
-003
1029
1038
R-11399.2
R-11599.2
3709.81
-004
2.35 A.
-002
1.99 A.
1040.14
KIPTON-EAST
PLATE
RD.
1498.60
732.97
R-11459.20
(120)
(60)
82.16
-004
0.50 A
165
200
211.11
211.11
835.95
835.95
187.46
-019
5.35 A
535.95
-007
2.23 A
468.04
60 Rds.
1001.35
230
278.05
-008
3.00 A.
6
-010
7.50 A.
-012
7.92 A.
-014
7.92 A.
-015
7.16 A.
23.14 Chs.
-001
46.33 A.
7
805.86
-002
P.P.NO. 13-11-028-000- 13-11-029-000-
PRIOR INST: DV.901/450
closure: C=1:430,758
SURVEYED BY: JOHN POZYWAK
REG. SURVEYOR
20757
AUG 2 1994
APPROVED
LORAIN CO.
MAP DEPT.
DATE 3-23-94
13-D
PAGE -020
CAROLYN FRANCE
BY 20.65 A.
VOID # 20757