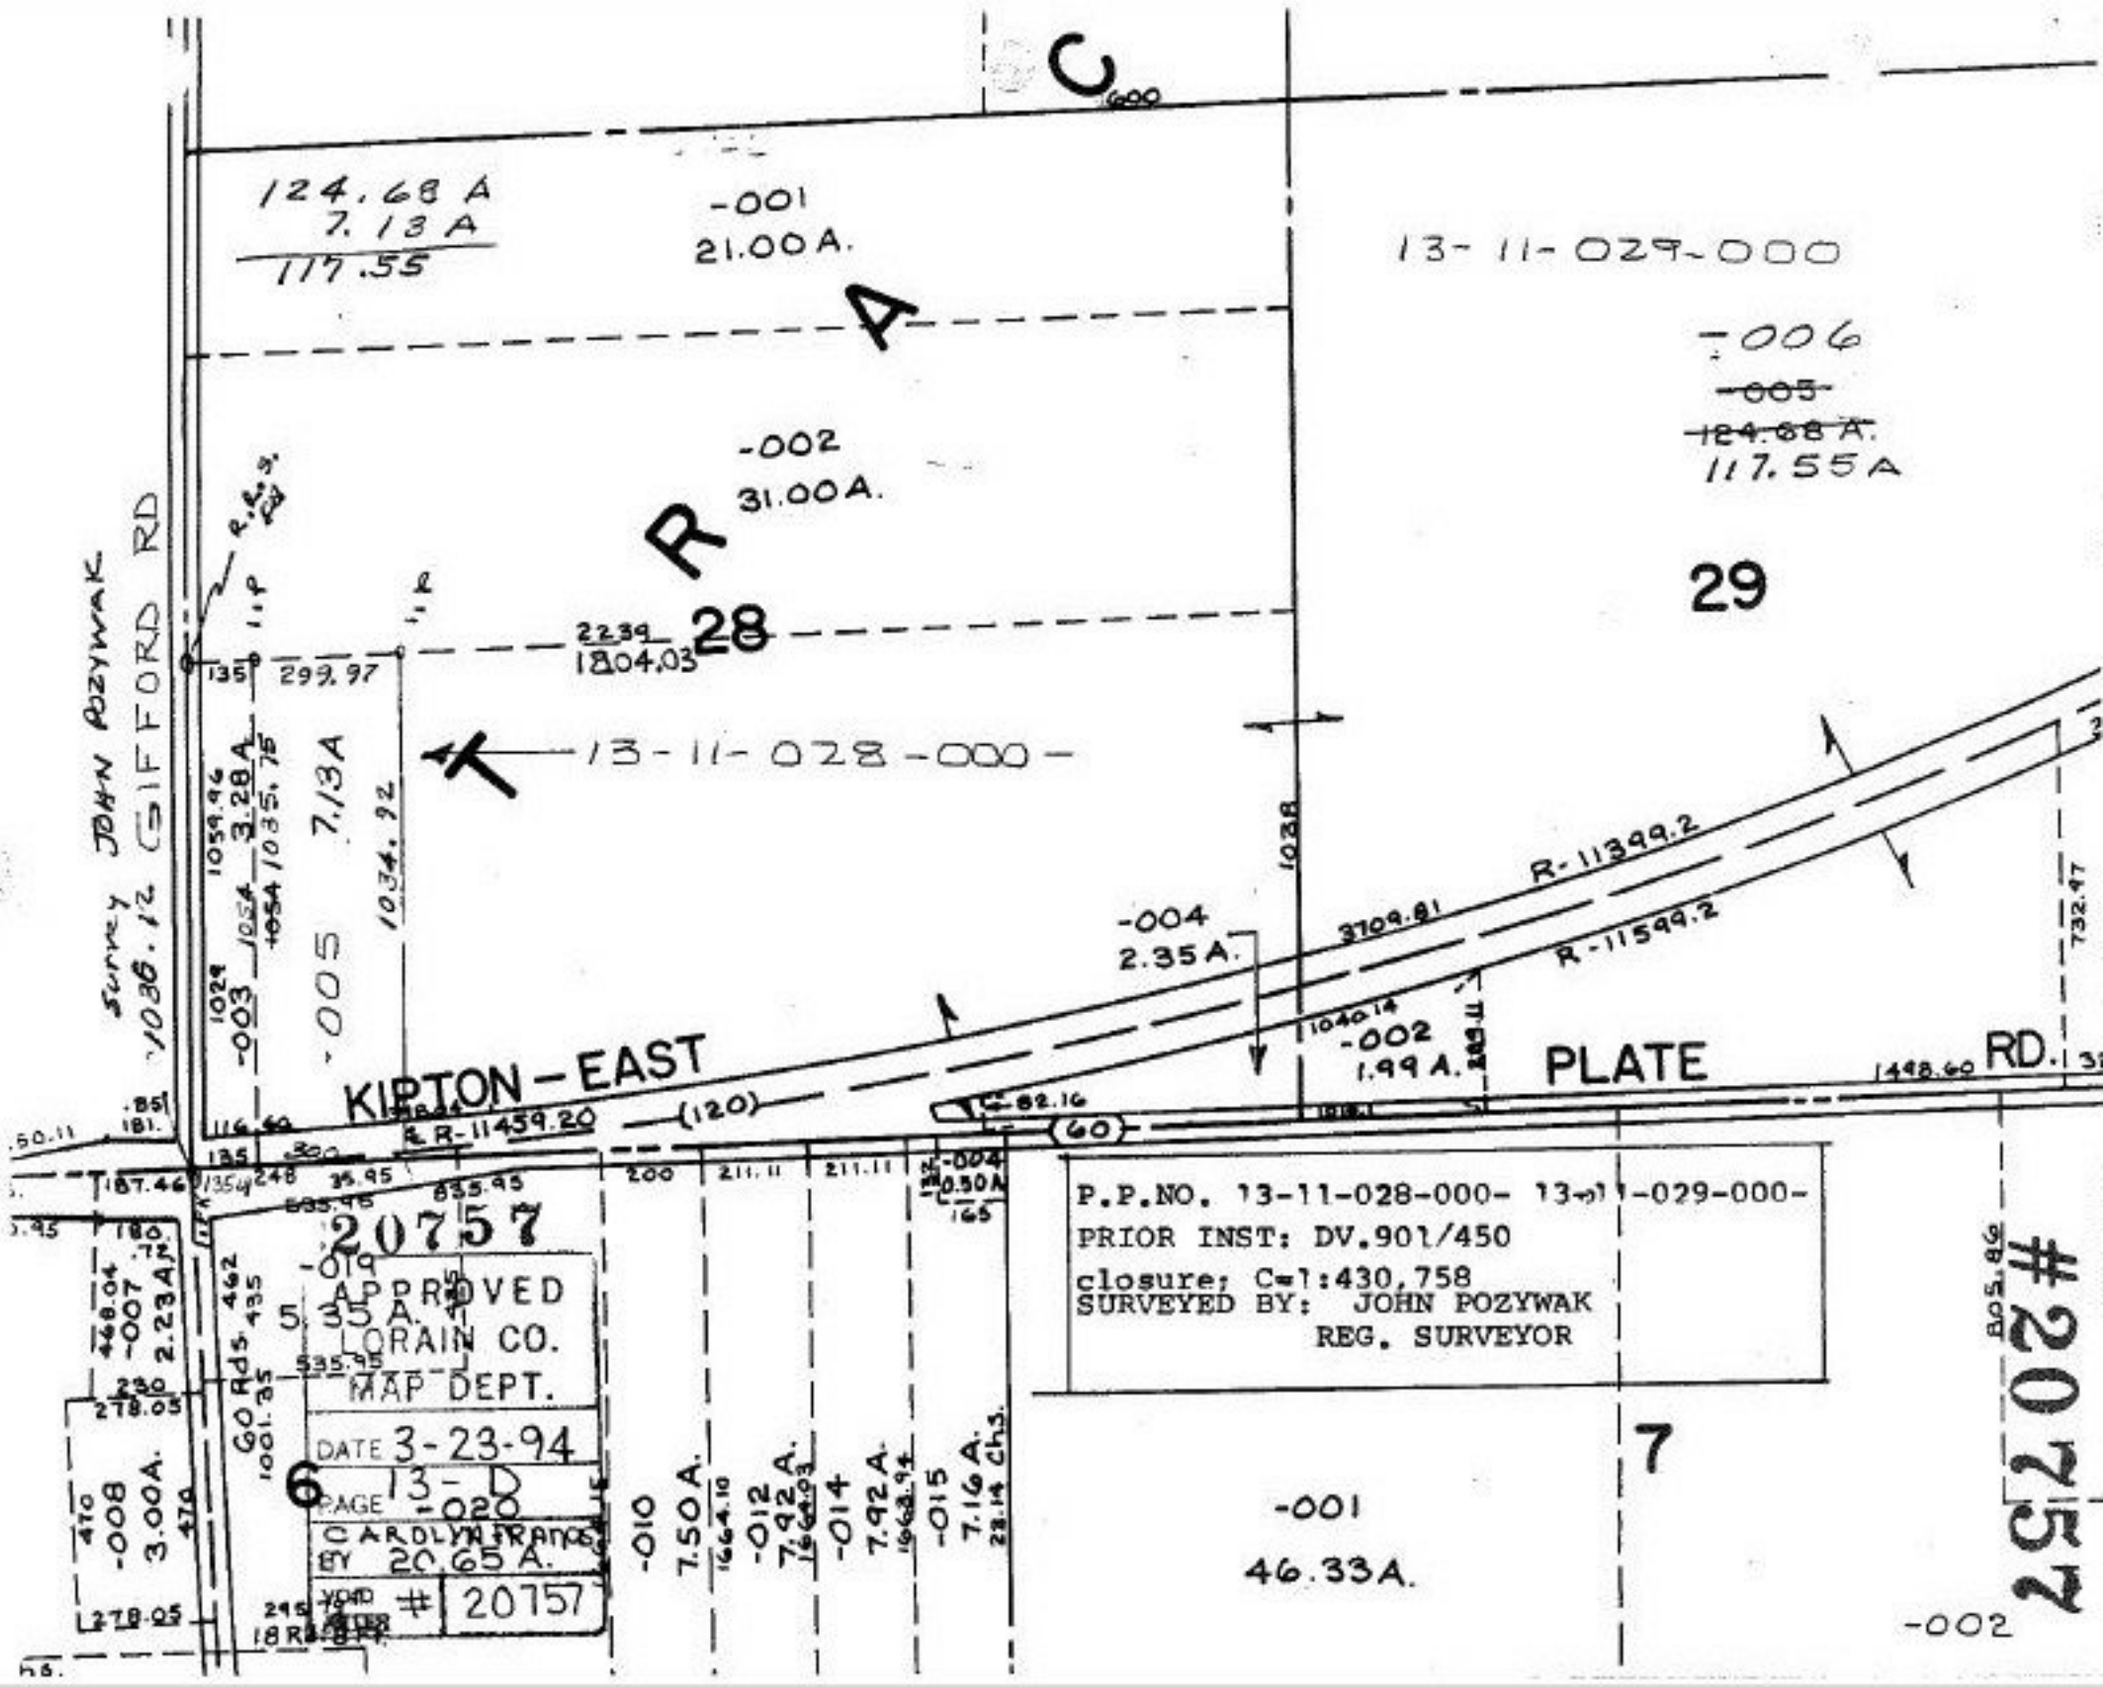
C
124.68 A
7.13 A
117.55
-001
21.00A.
13-11-029-000
-006
-005
124.68 A.
117.55A
A
-002
31.00A.
R
29
28
2239
1804.03
13-11-028-000-
JOHN POZYWAK
Survey
1036.12
GIFFORD RD
299.97
1059.96
3.28 A.
1035.75
7.13A
1034.92
-005
-003
1029
1054
1054
-004
2.35A.
3709.81
R-11399.2
R-11549.2
1038
1040.14
-002
1.99 A.
KIPTON-EAST
PLATE
RD.
1448.60
732.47
R-11459.20
(120)
(60)
82.16
187.46
835.95
835.95
200
211.11
211.11
-004
0.50A
165
20757
-009
5
APPROVED
LORAIN CO.
MAP DEPT.
DATE 3-23-94
PAGE 13-D
-020
CARDLYN FRANCIS
BY 20.65 A.
YOUR # 20757
6
60 Rds
462
435
535.95
-008
3.00A.
-007
2.23A.
-010
7.50A.
-012
7.92A.
-014
7.92A.
-015
7.16A.
23.14 Chs.
P.P.NO. 13-11-028-000- 13-11-029-000-
PRIOR INST: DV.901/450
closure; C=1:430,758
SURVEYED BY: JOHN POZYWAK
REG. SURVEYOR
7
-001
46.33A.
-002
805.86
