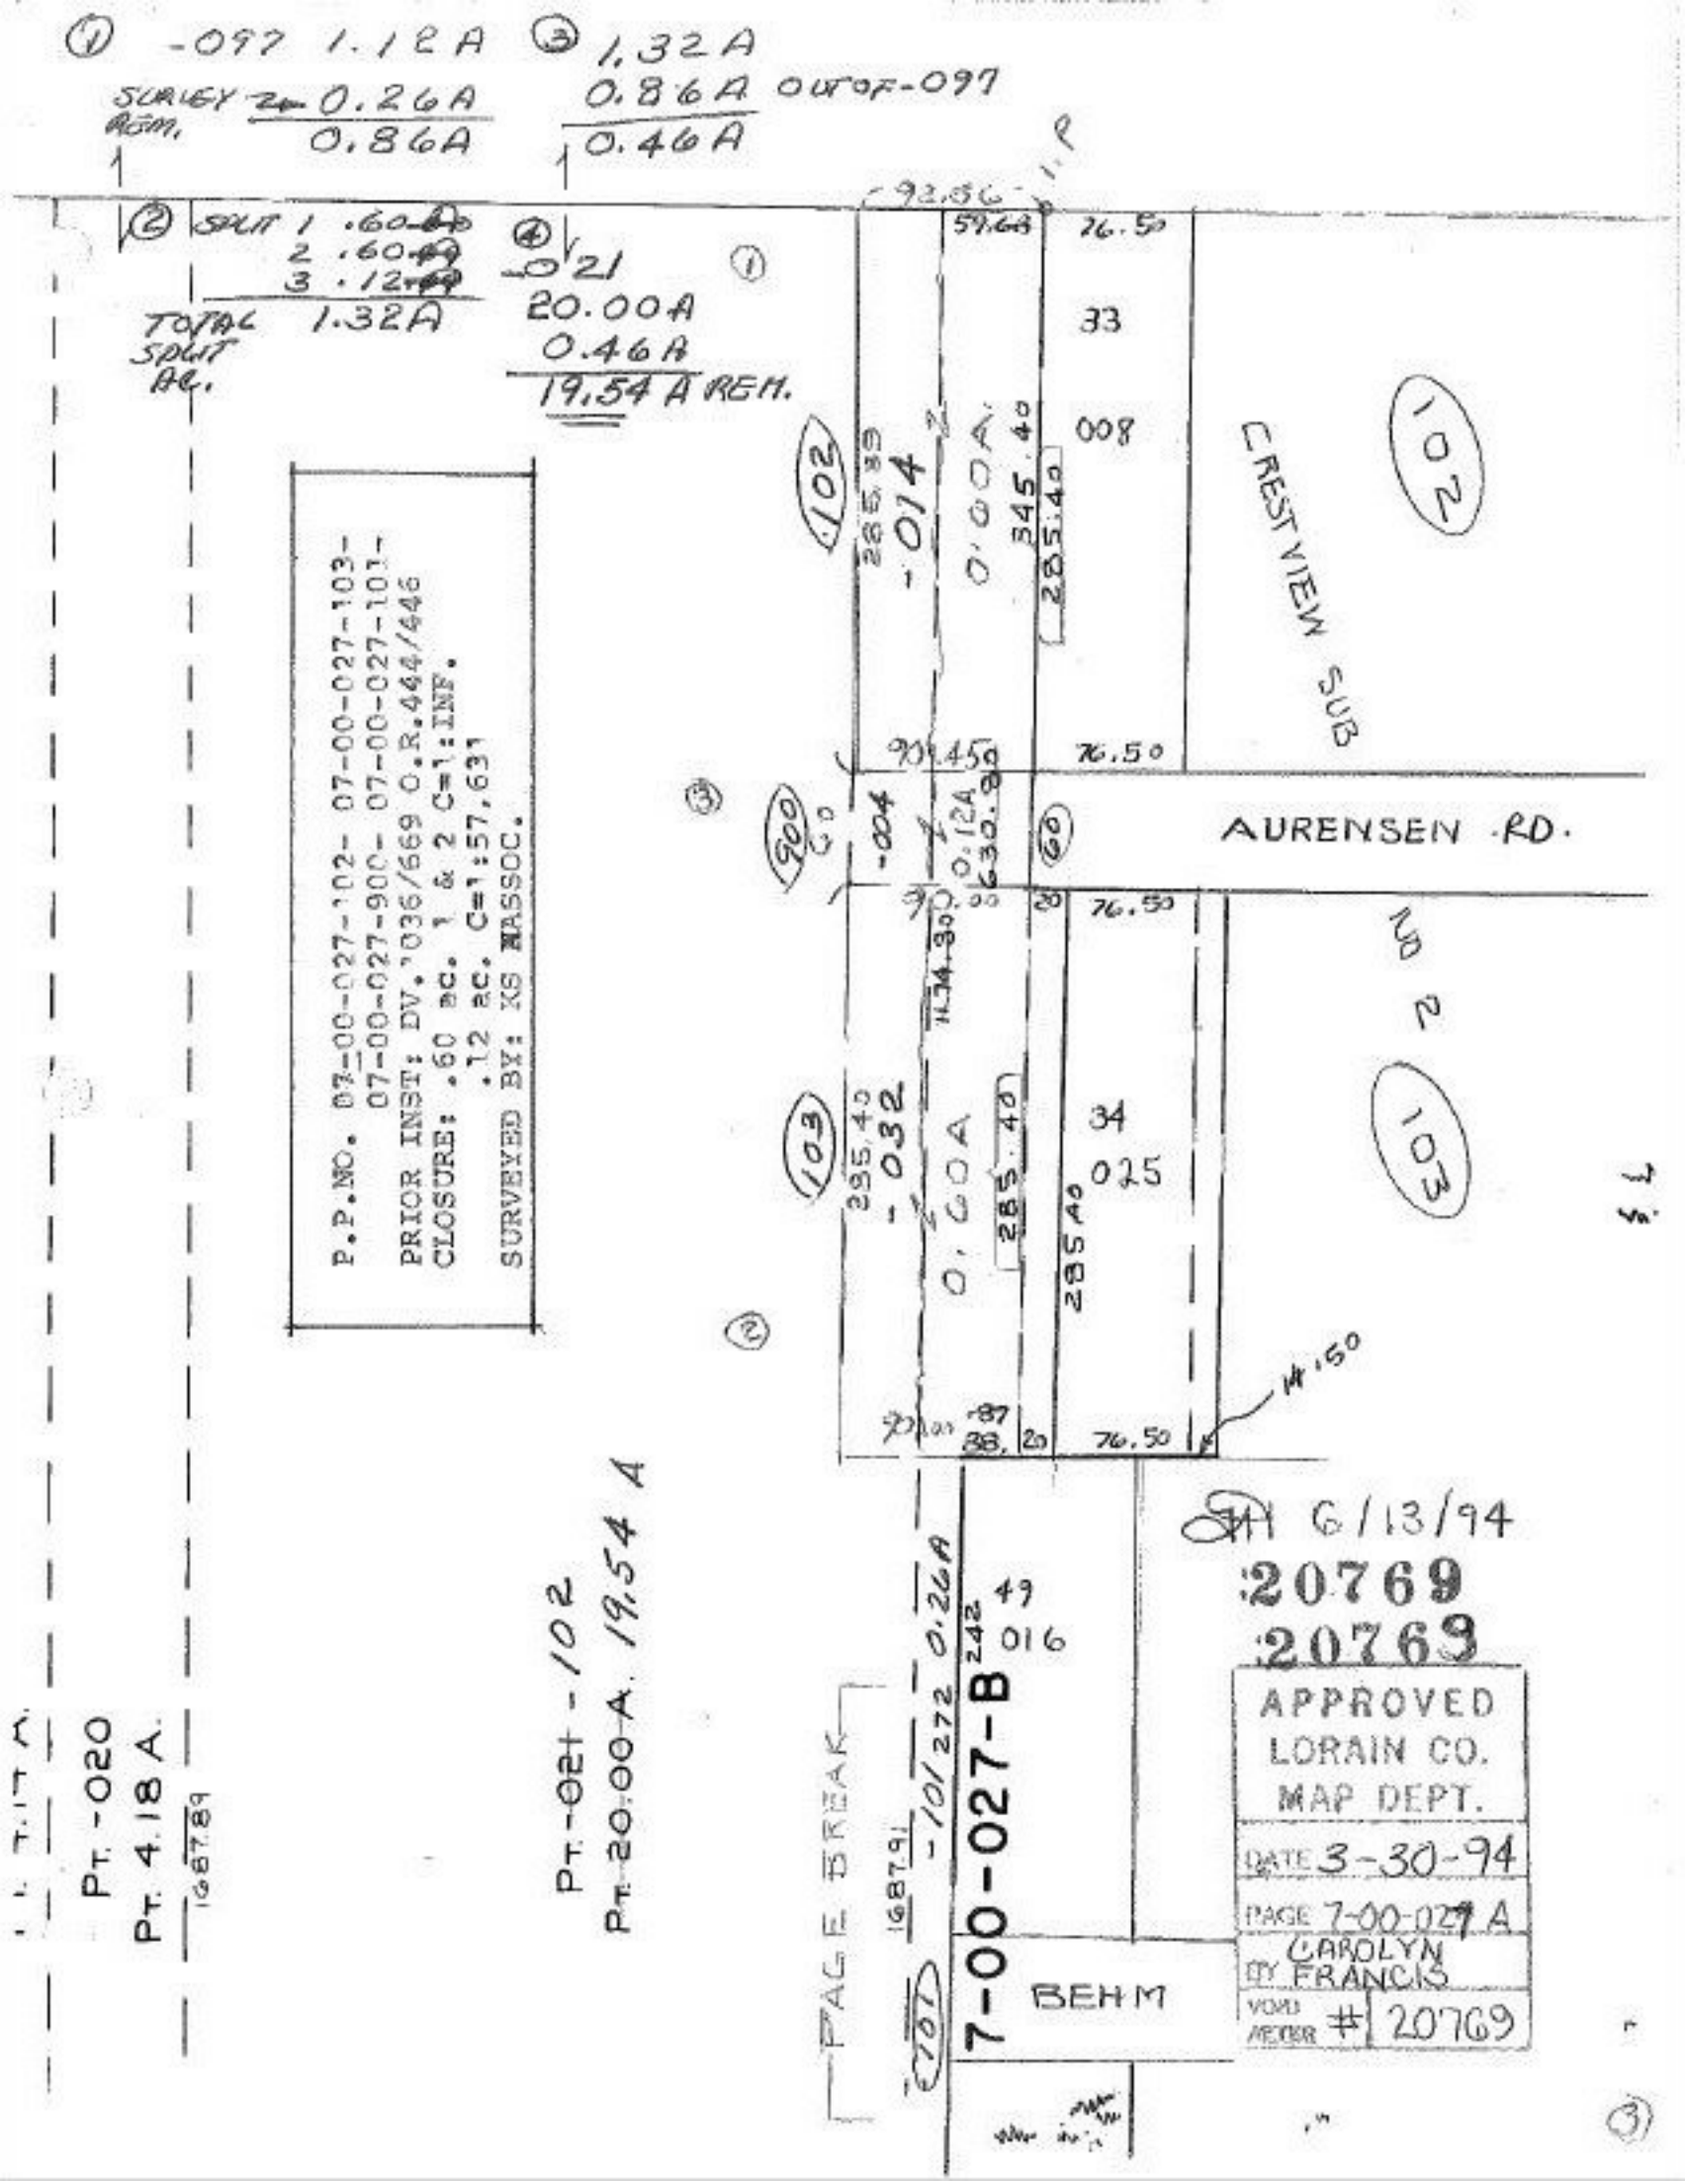

① -097 1.12A
SURVEY REM. 0.26A
0.86A
③ 1.32A
0.86A OUT OF -097
0.46A
② SPLIT 1 .60
2 .60
3 .12
TOTAL SPLIT AC. 1.32A
④ -021
20.00A
0.46A
19.54 A REM.
P.P.NO. 07-00-027-102- 07-00-027-103-
07-00-027-900- 07-00-027-101-
PRIOR INST: DV.1036/669 O.R.444/446
CLOSURE: .60 ac. 1 & 2 C=1:INF.
.12 ac. C=1:57,631
SURVEYED BY: KS MASSOC.
CREST VIEW SUB
AURENSEN RD.
PT. -020
PT. 4.18 A.
PT. -021 - 102
PT. 20.00 A. 19.54 A
PAGE BREAK
7-00-027-B
BEHM
6/13/94
20769
20769
APPROVED
LORAIN CO.
MAP DEPT.
DATE 3-30-94
PAGE 7-00-027 A
BY CAROLYN FRANCIS
VOID METER # 20769