#20773

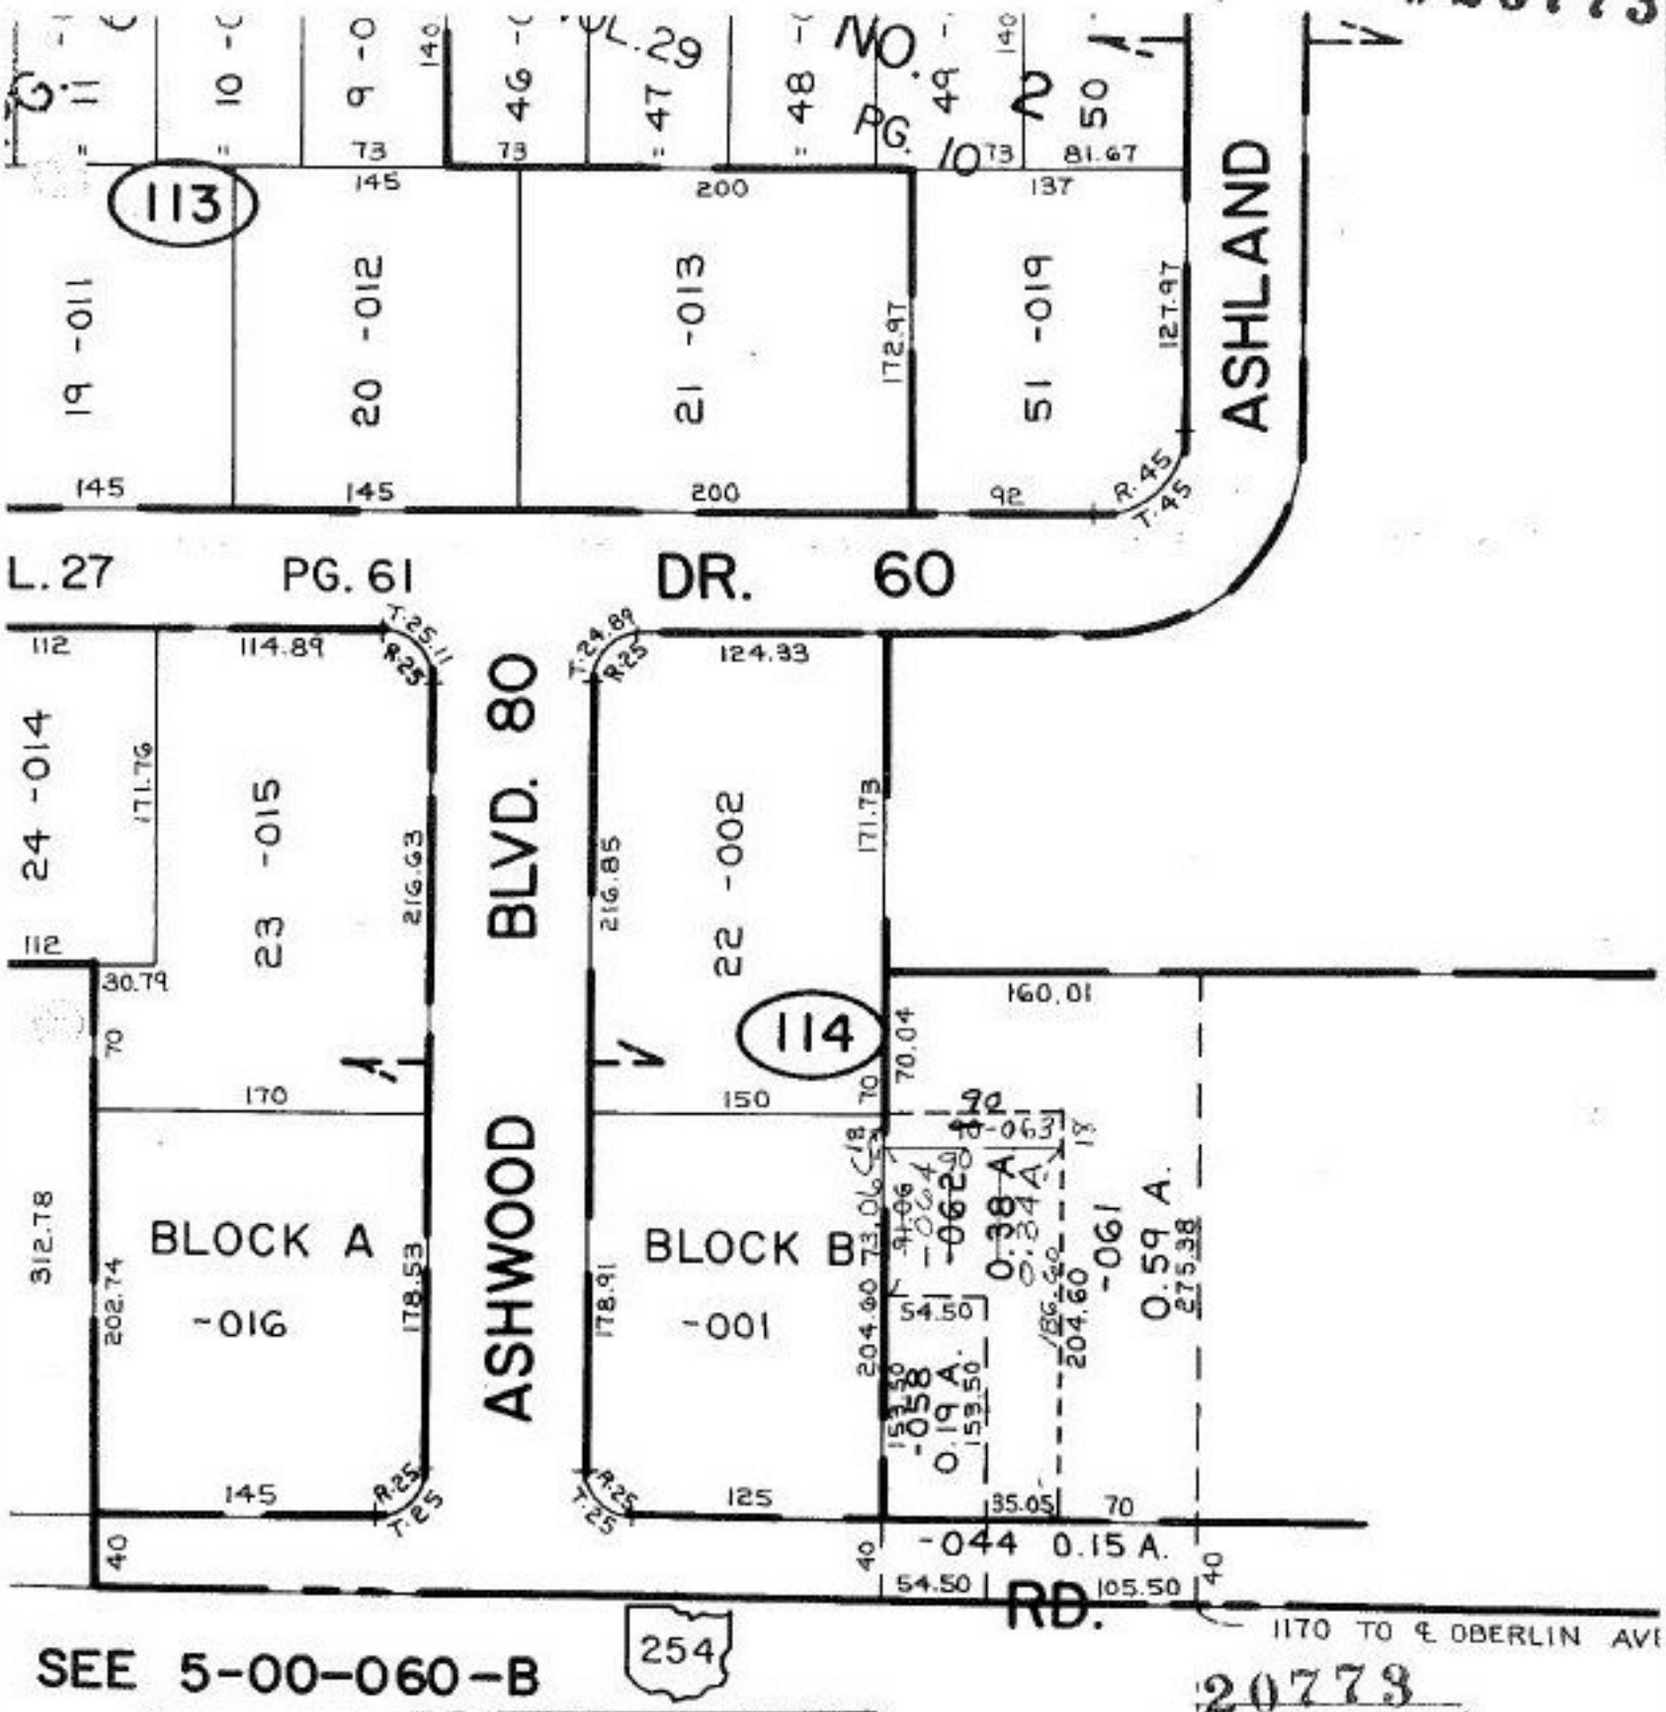

SEE 5-00-060-B

P.P.NO. 02-02-005-114-
PRIOR INST: 1410/9
CLOSURE: C=1: INF.
SURVEYED BY: RICHARD ROSEBECK
REG. SURVEYOR

20773
APPROVED
LORAIN CO.
MAP DEPT.
DATE 3-21-94
PAGE 2-02-0
BY
VOID
ADDED