9.84 A
0.29 A
9.55 A
.29 A
9.26A

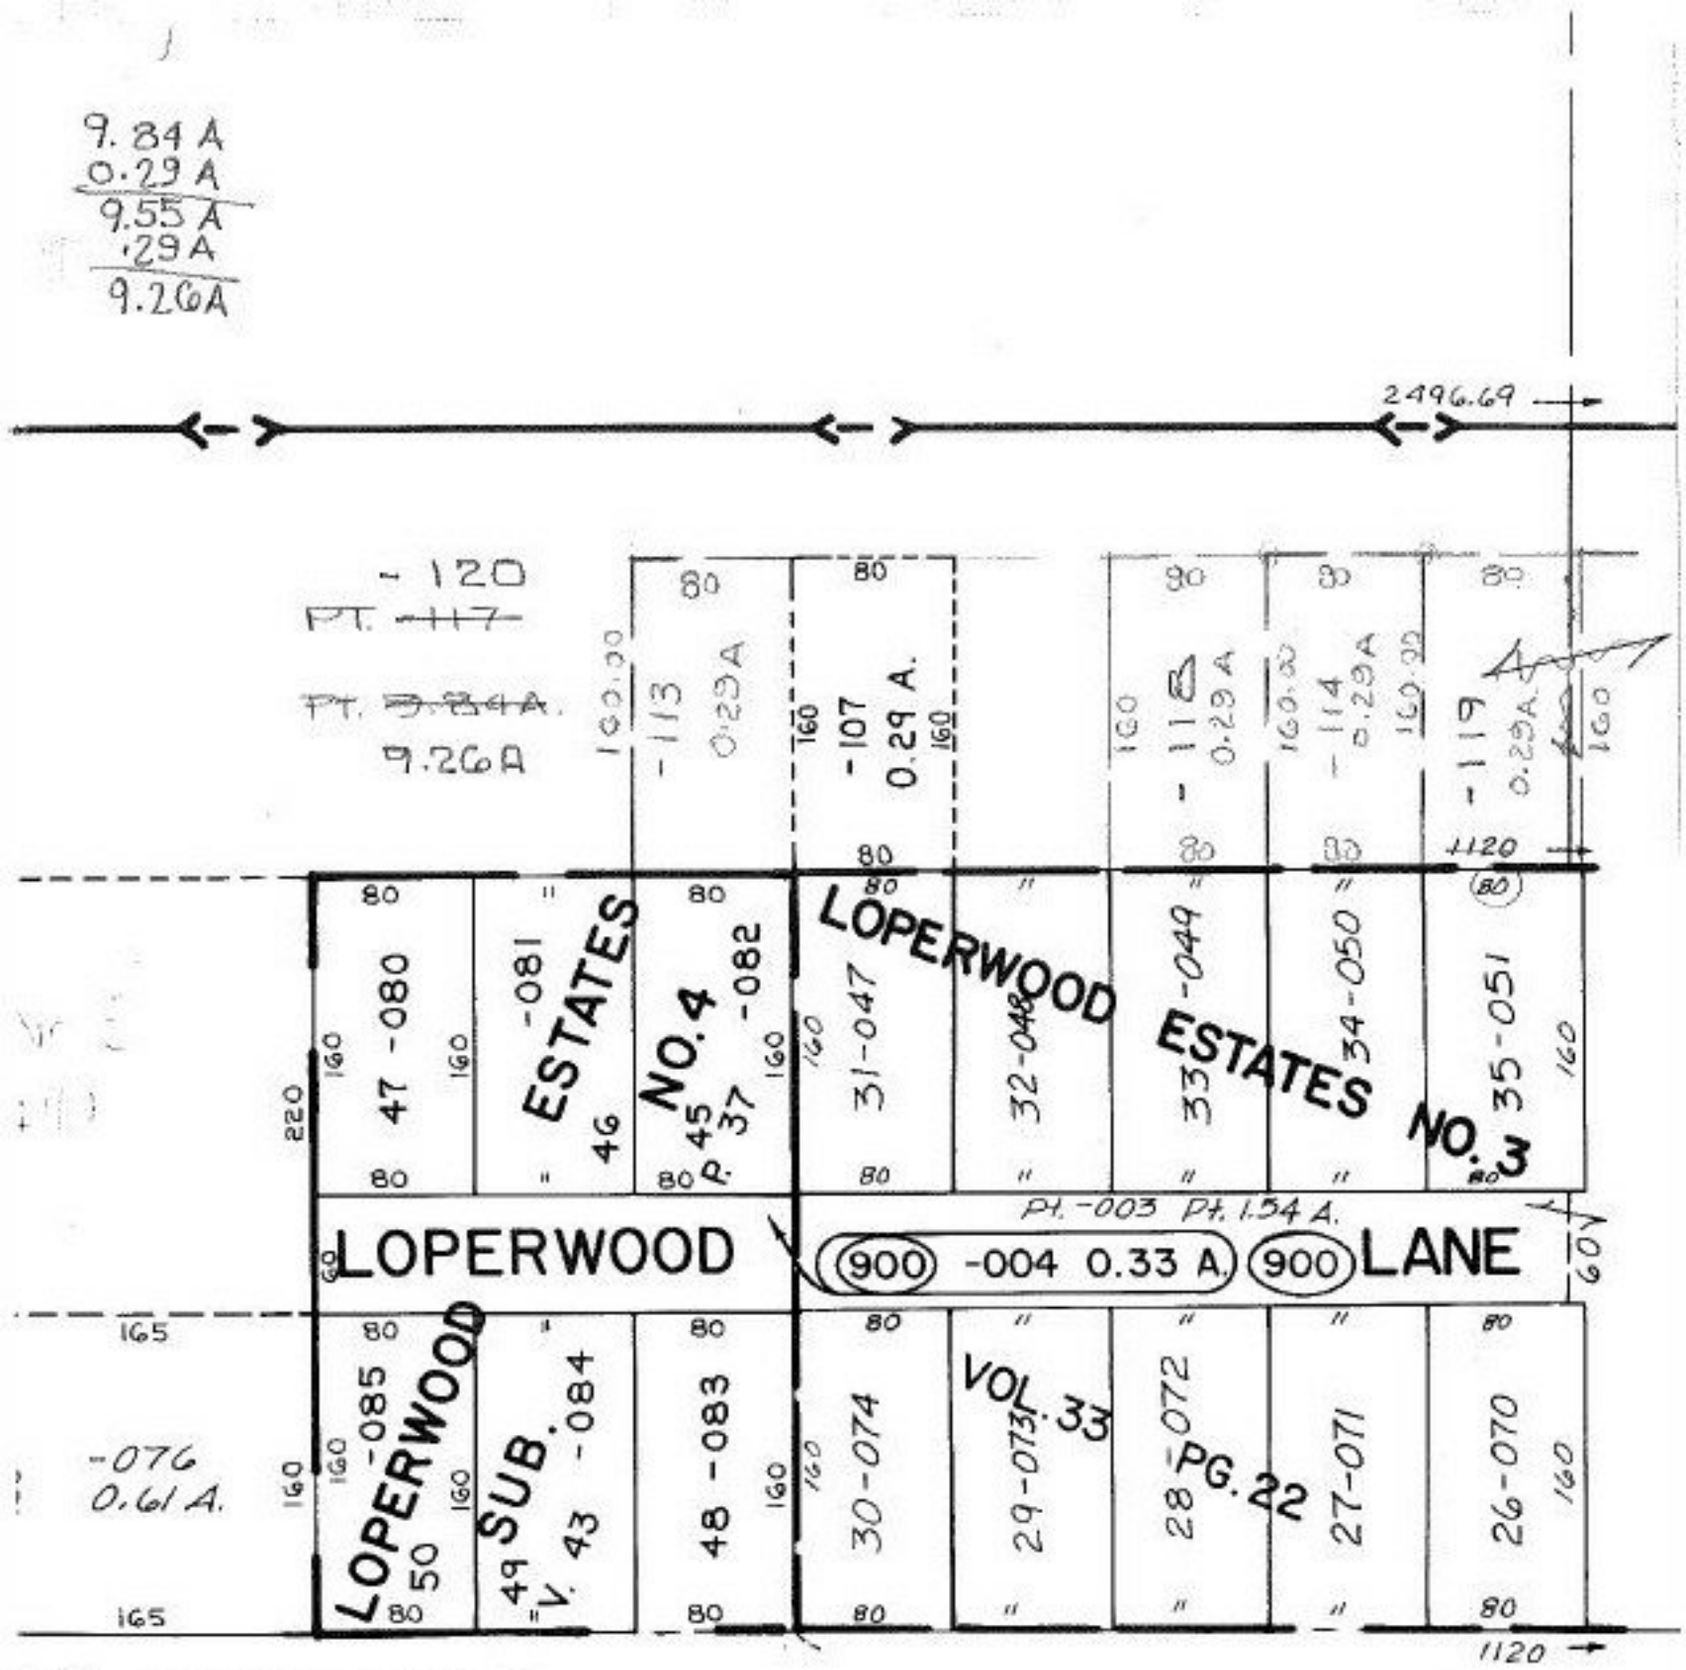

SEE 15-00-045-A

P.P.NO. 15-00-036-000-
PRIOR INST: DV. 1177/742
CLOSURE: 0.29 ac. C=1:INF.
~~SCALE~~
MAP BY: KS ASSOC.

AUG 2 1994
20777
APPROVED
LORAIN CO.
MAP DEPT.
DATE 3-22-94
PAGE 15-00-036A
BY CAROLYN FRANCIS
VOL. # 20777

1/2