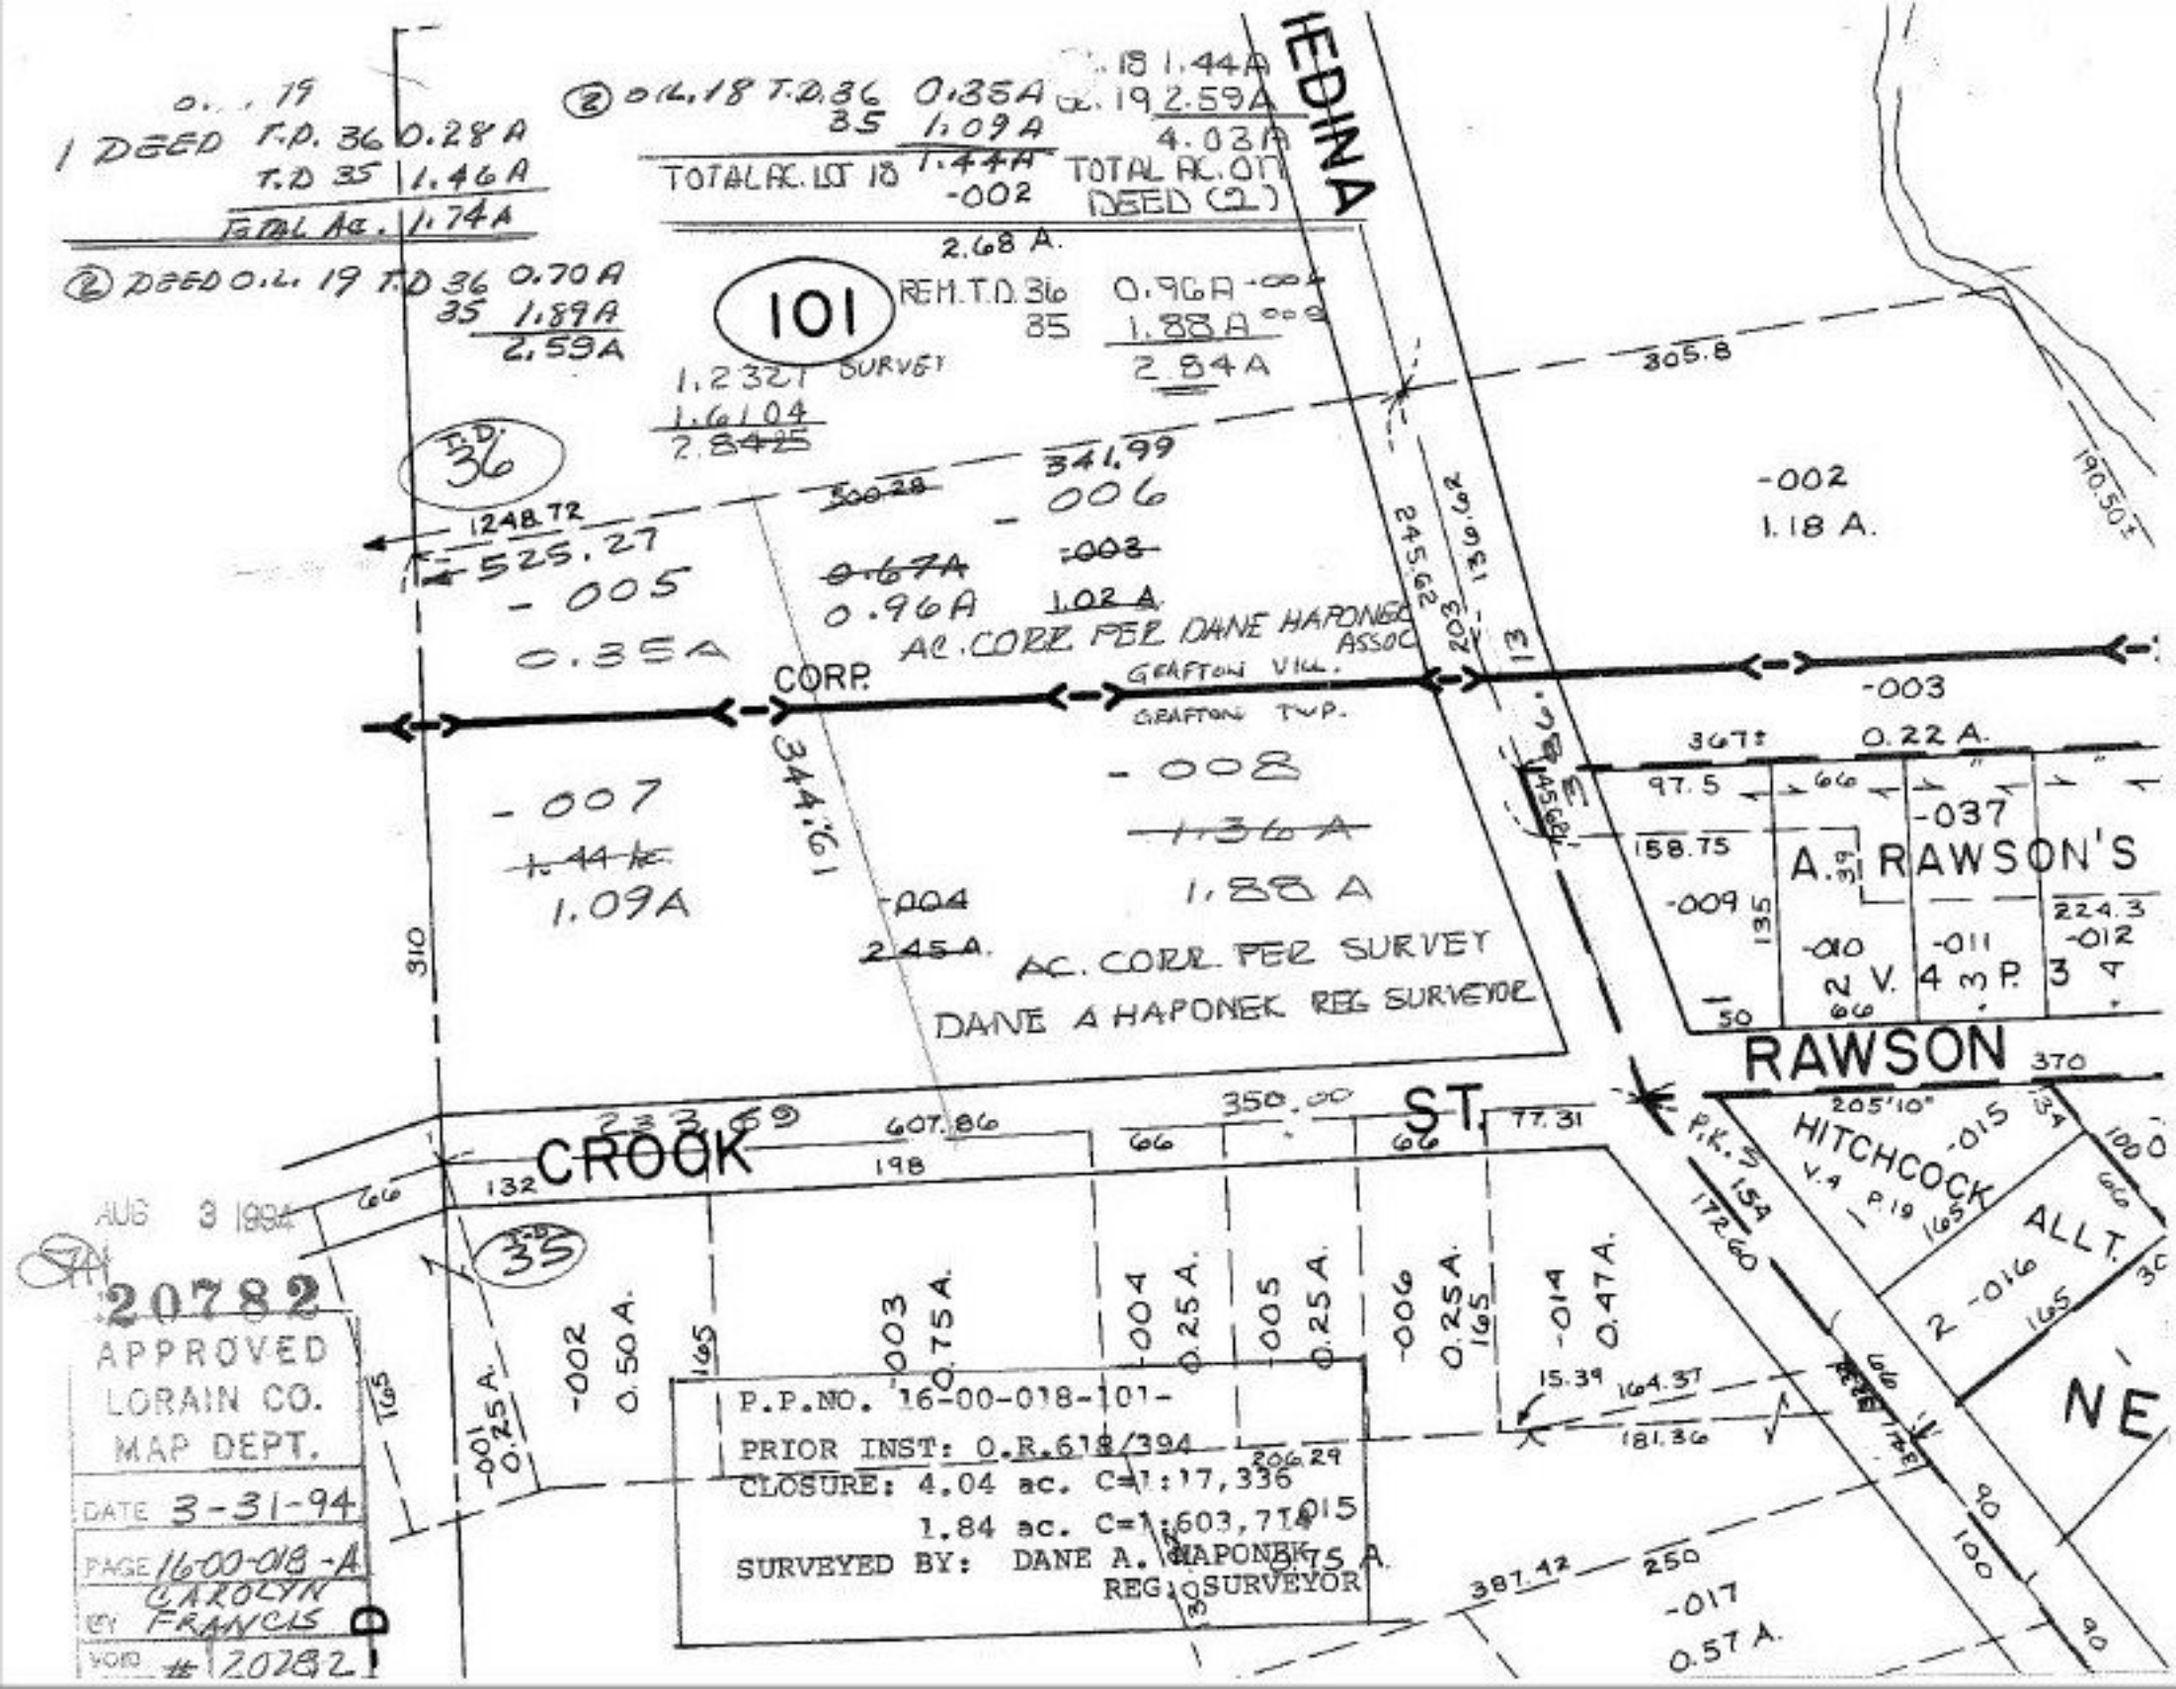

1 DEED T.D. 36 0.28 A
T.D 35 1.46 A
TOTAL AC. 1.74 A
② DEED O.L. 19 T.D 36 0.70 A
35 1.89 A
2.59 A
② O.L. 18 T.D. 36 0.35 A
35 1.09 A
1.44 A
TOTAL AC. LOT 18
-002
2.68 A.
18 1.44 A
19 2.59 A
4.03 A
TOTAL AC. OF DEED (2)
101
REM. T.D. 36 0.96 A
35 1.88 A
2.84 A
1.2321 SURVEY
1.6104
2.8425
T.D. 36
1248.72
525.27
-005
0.35 A
341.99
-006
0.96 A
1.02 A
AC. CORR. PER DANE HAPONEK ASSOC
CORP.
GRAFTON VILL.
GRAFTON TWP.
-007
1.09 A
344.61
-008
1.88 A
-004
2.45 A.
AC. CORR. PER SURVEY
DANE A HAPONEK REG SURVEYOR
305.8
-002
1.18 A.
-003
0.22 A.
-037
A. RAWSON'S
-009
-010
-011
-012
2 V. 4 3 P. 3
RAWSON
HITCHCOCK
ALLT.
-015
-016
CROOK
ST.
35
-002
0.50 A.
-003
0.75 A.
-004
0.25 A.
-005
0.25 A.
-006
0.25 A.
-014
0.47 A.
-001
0.25 A.
-017
0.57 A.
P.K.S.
NE
P.P.NO. 16-00-018-101-
PRIOR INST: O.R.618/394
CLOSURE: 4.04 ac. C=1:17,336
1.84 ac. C=1:603,714
SURVEYED BY: DANE A. HAPONEK
REG. SURVEYOR
AUG 3 1994
20782
APPROVED
LORAIN CO.
MAP DEPT.
DATE 3-31-94
PAGE 16-00-018-A
BY CAROLYN FRANCIS
VOID # 20282