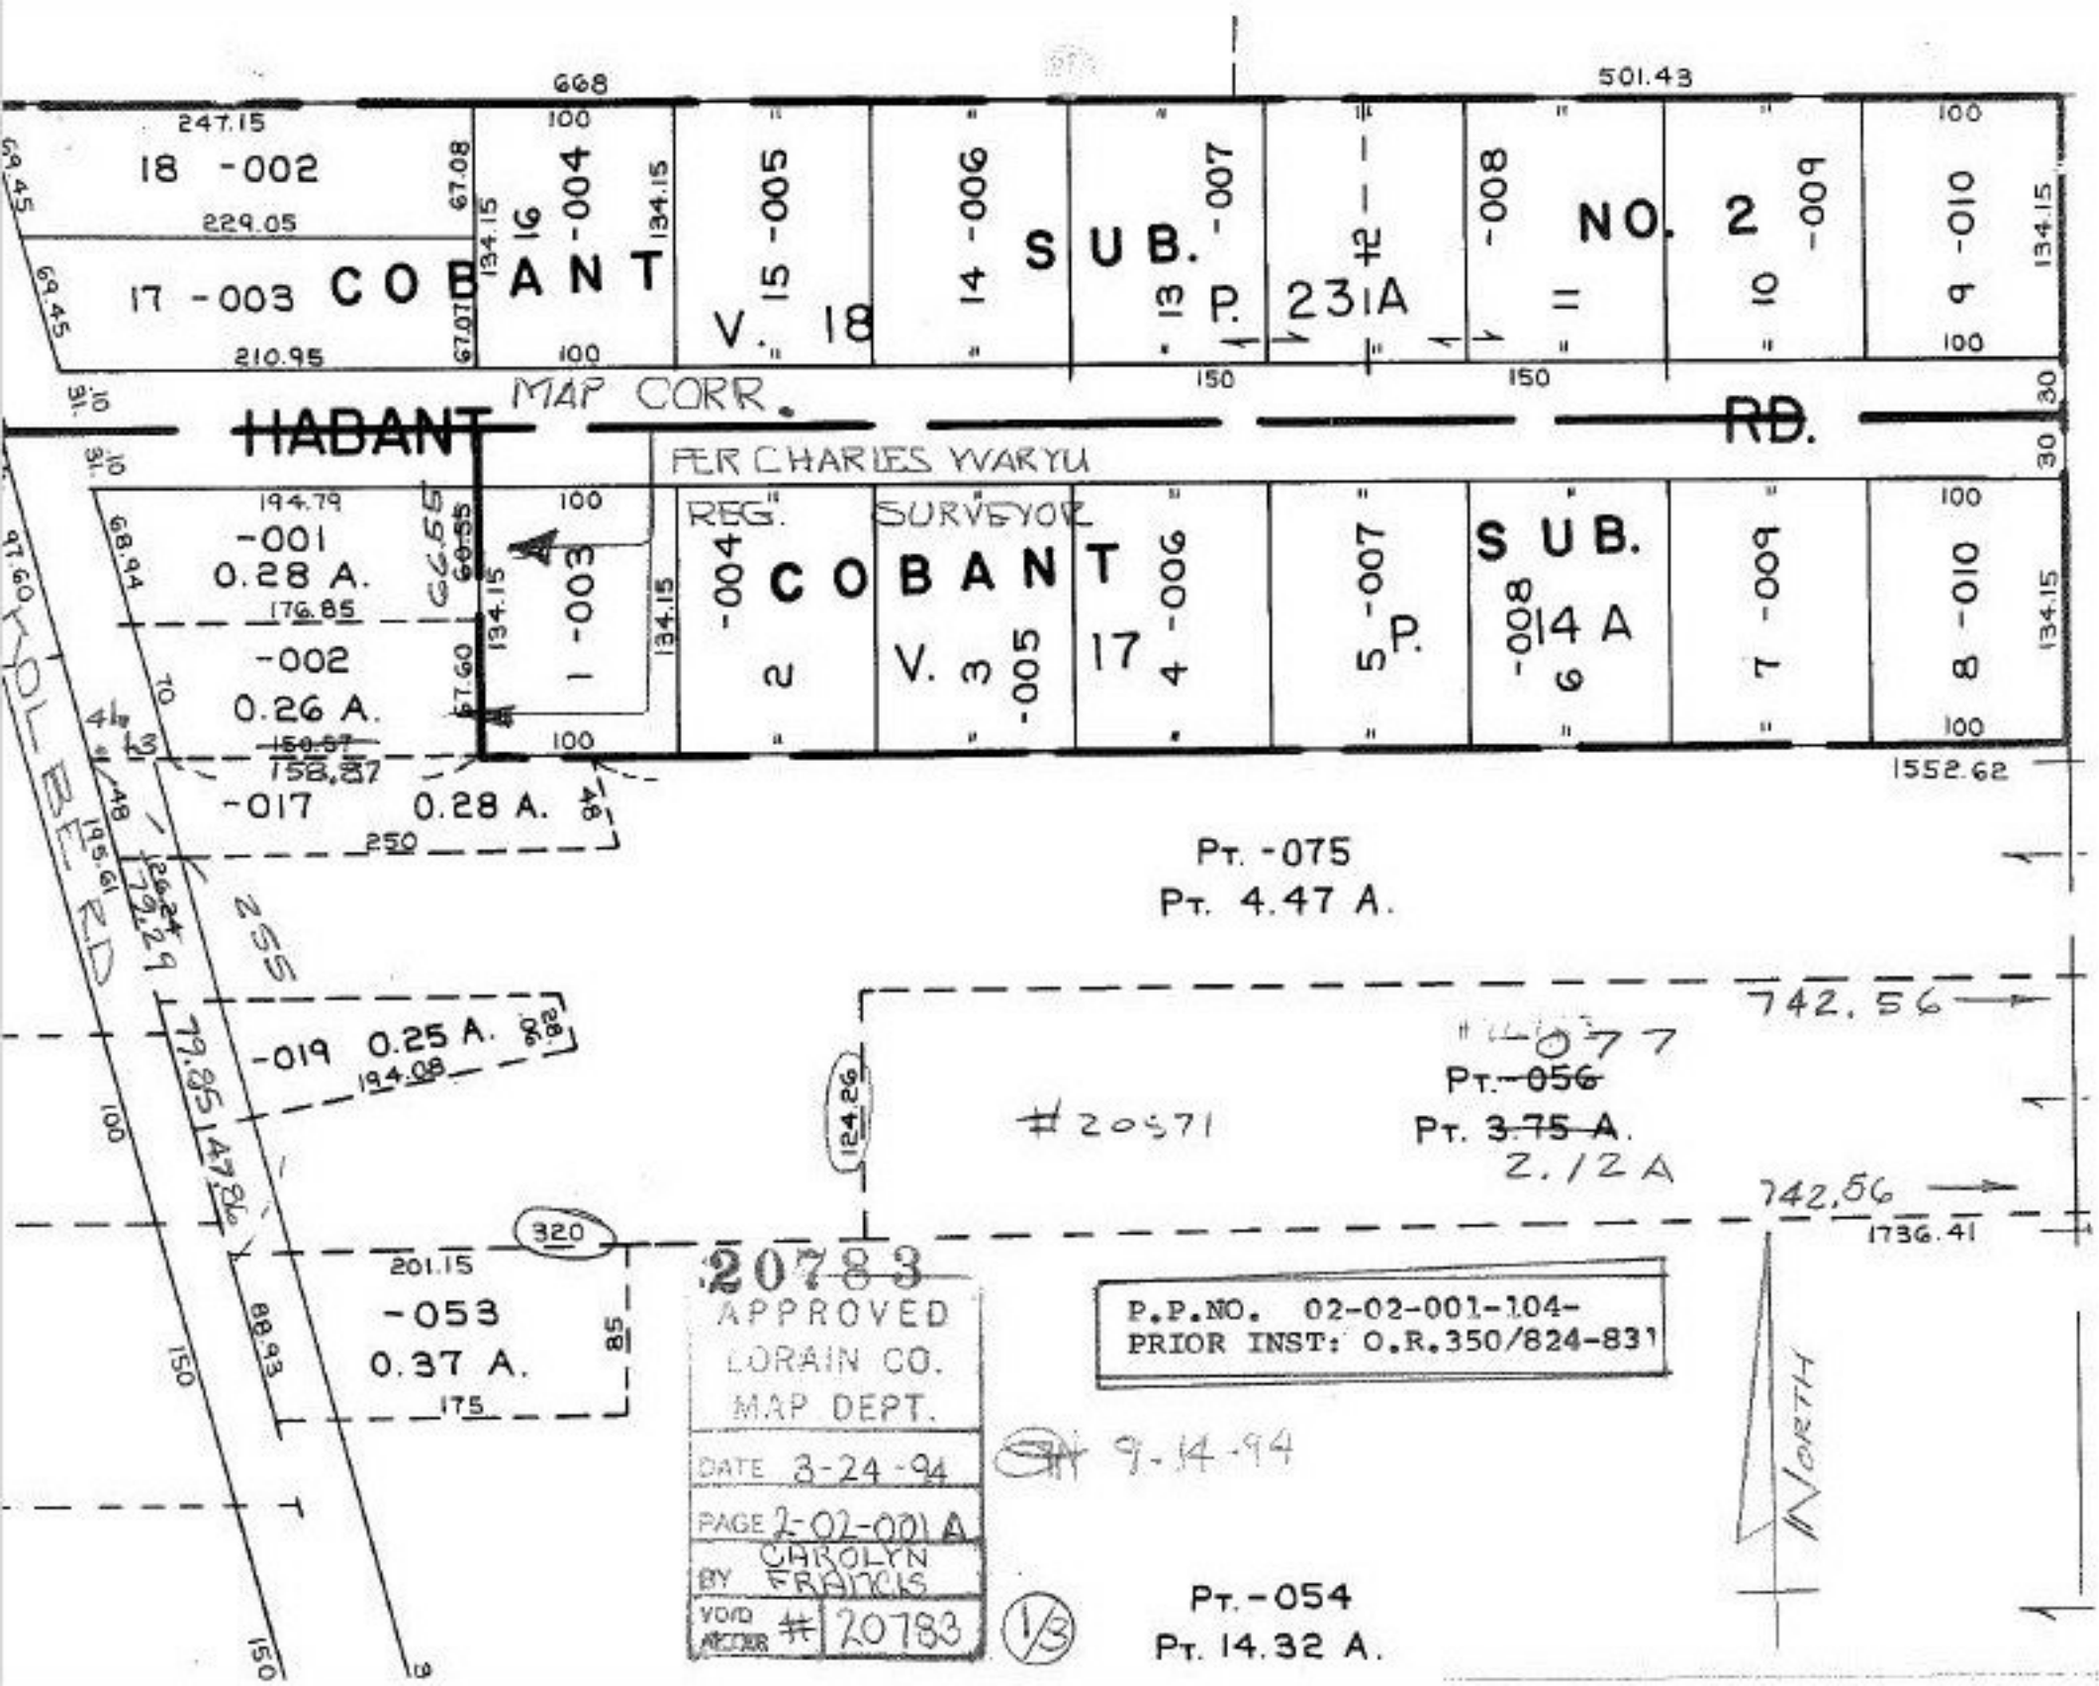
668
501.43
247.15
18 -002
229.05
17 -003
210.95
67.08
67.01
69.45
69.45
100
134.15
16 -004
134.15
100
15 -005
14 -006
13 -007
12 -008
11
10 -009
9 -010
100
134.15
COBANT
V. 18
SUB.
P. 231A
NO. 2
150
150
HABANT
MAP CORR.
RD.
30
30
31.10
31.10
PER CHARLES YVARYU
REG. SURVEYOR
194.79
-001
0.28 A.
176.85
-002
0.26 A.
158.87
-017
0.28 A.
250
68.94
97.60
KOLBE RD
195.61
70
48
255
100
134.15
1 -003
2 -004
COBANT
V. 3 -005
17 4 -006
5 -007
P.
6 -008
14 A
7 -009
8 -010
134.15
100
1552.62
Pt. -075
Pt. 4.47 A.
742.56
#20571
Pt. -056
Pt. 3.75 A.
2.12 A
742.56
1736.41
124.29
320
201.15
-053
0.37 A.
175
85
150
88.93
APPROVED
LORAIN CO.
MAP DEPT.
DATE 3-24-94
PAGE 2-02-001 A
BY CAROLYN FRANCIS
VOID AFFIDAVIT # 20783
20783
P.P.NO. 02-02-001-104-
PRIOR INST: O.R.350/824-831
9-14-94
1/3
Pt. -054
Pt. 14.32 A.
NORTH