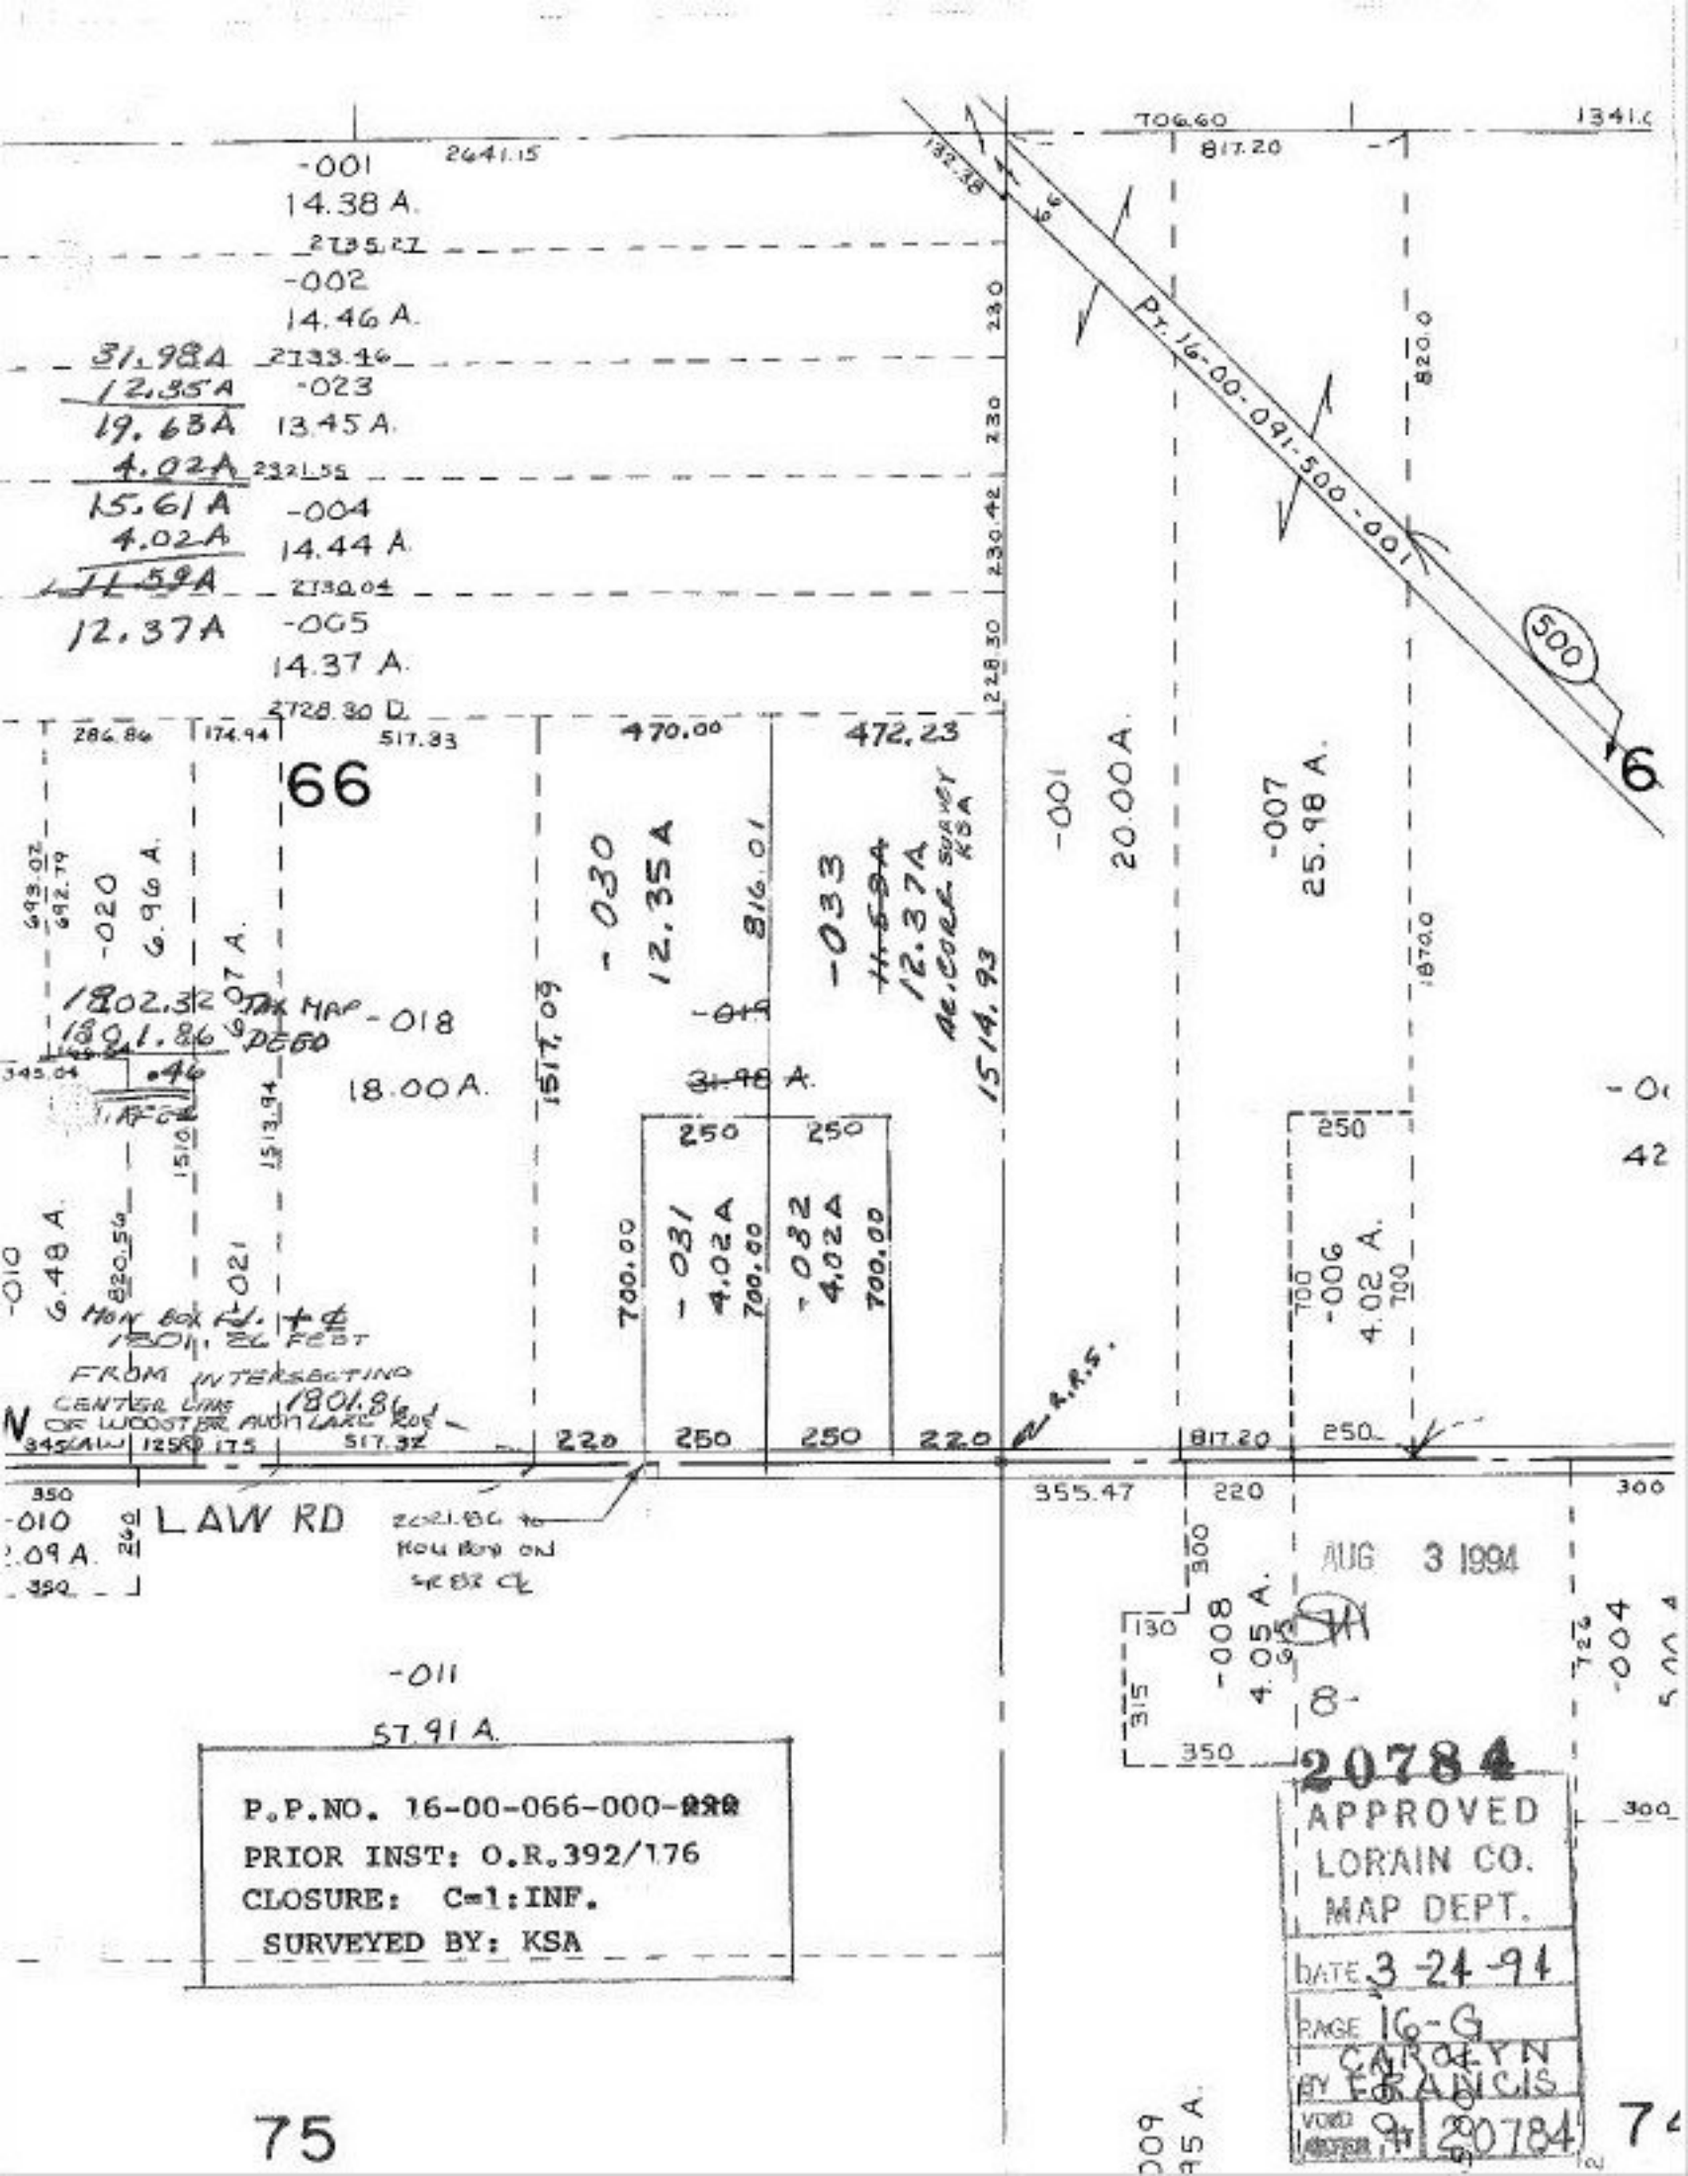
-001
14.38 A.
2135.21
-002
14.46 A.
2133.46
-023
13.45 A.
2132.55
-004
14.44 A.
2130.04
-005
14.37 A.
2728.30 D.
2641.15
1341.6
706.60
817.20
132.38
Pt. 16-00-091-500-001
500
6
66
-001
20.00A.
-007
25.98 A.
-030
12.35A
-033
12.37A
AE, CORE SURVEY KSA
1514.93
1517.09
816.01
470.00
472.23
284.86
174.94
517.33
693.02
692.79
-020
6.96 A.
1802.32
1801.86
PEGO
18.00A.
345.04
.46
1510
1513.94
-021
6.48 A.
820.54
1801.86
FEET
FROM INTERSECTING
345.04
1258.175
517.32
700.00
-031
4.02A
700.00
-032
4.02A
700.00
250
220
817.20
355.47
-006
4.02 A.
700
-008
4.05 A.
-004
-010
6.09 A.
260
350
LAW RD
2021.80 to Row Box on Rear Ck
-011
57.91 A.
P.P.NO. 16-00-066-000-020
PRIOR INST: O.R.392/176
CLOSURE: C=1:INF.
SURVEYED BY: KSA
AUG 3 1994
20784
APPROVED
LORAIN CO.
MAP DEPT.
DATE 3-24-94
PAGE 16-G
BY CAROLYN FRANCIS
VOID 94 20784
75
74