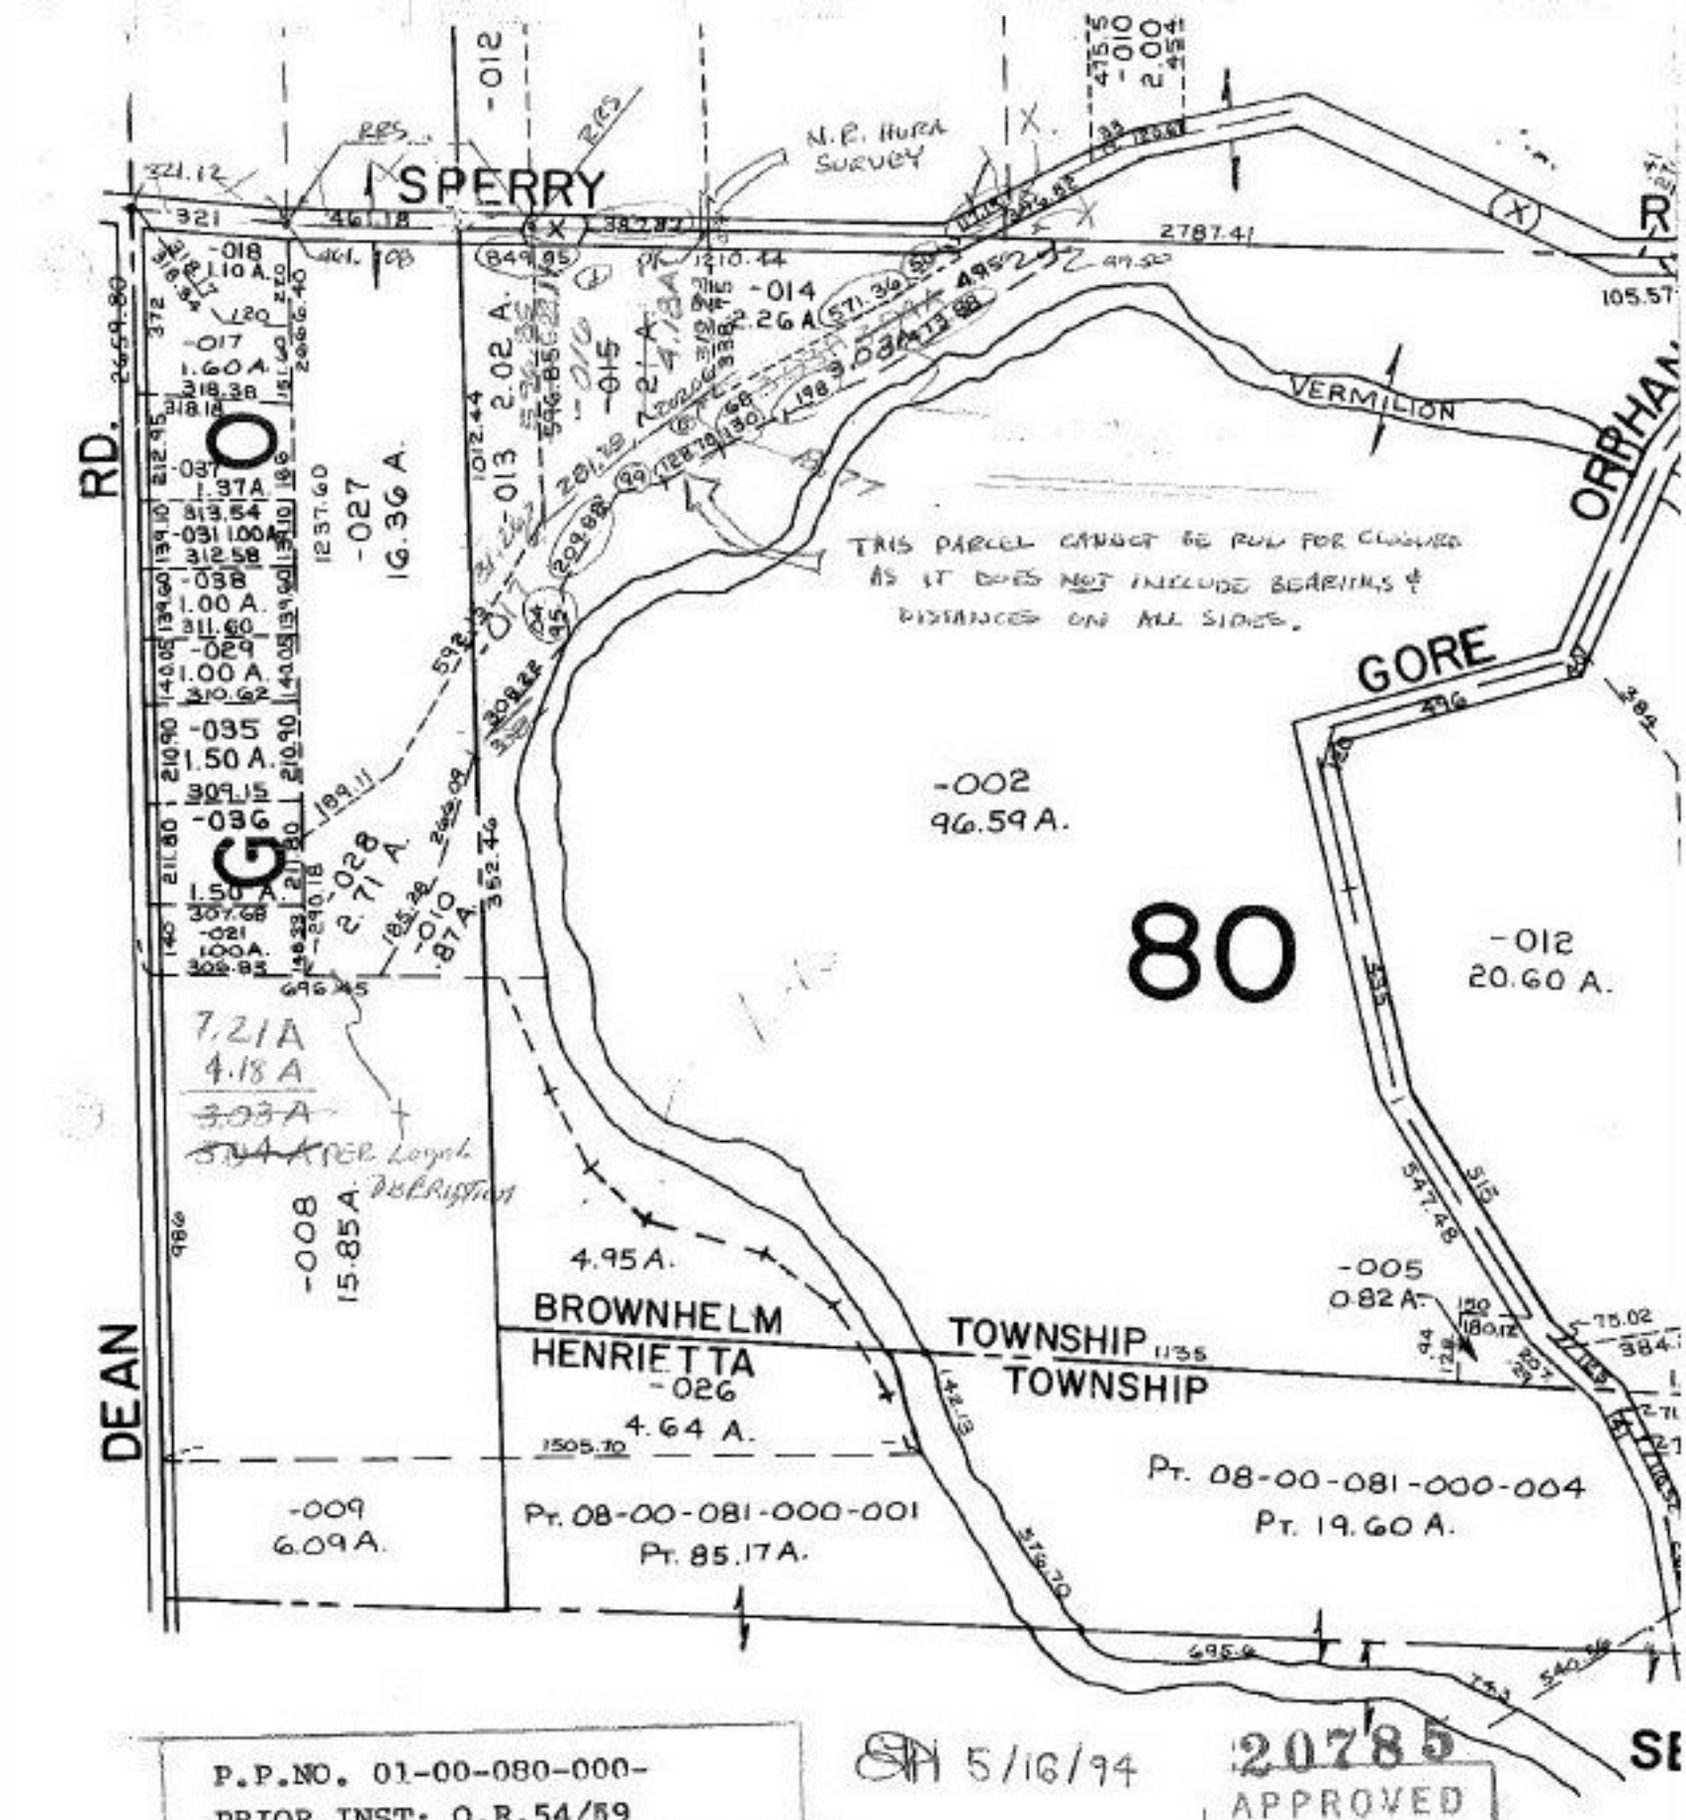

P.P.NO. 01-00-080-000-
PRIOR INST: O.R.54/59
CLOSURE: 4.18 ac. C=1:339,782
SURVEYED BY: N.R.HURA
REG. SURVEYOR

PARCEL B = BOTTOMLAND 3.037 A.

SN 5/16/94

20785

APPROVED
LORAIN CO.
MAP DEPT.
DATE 3-28-94
PAGE 1-I
BY CAROLYN FRANCIS
VOID # 20785