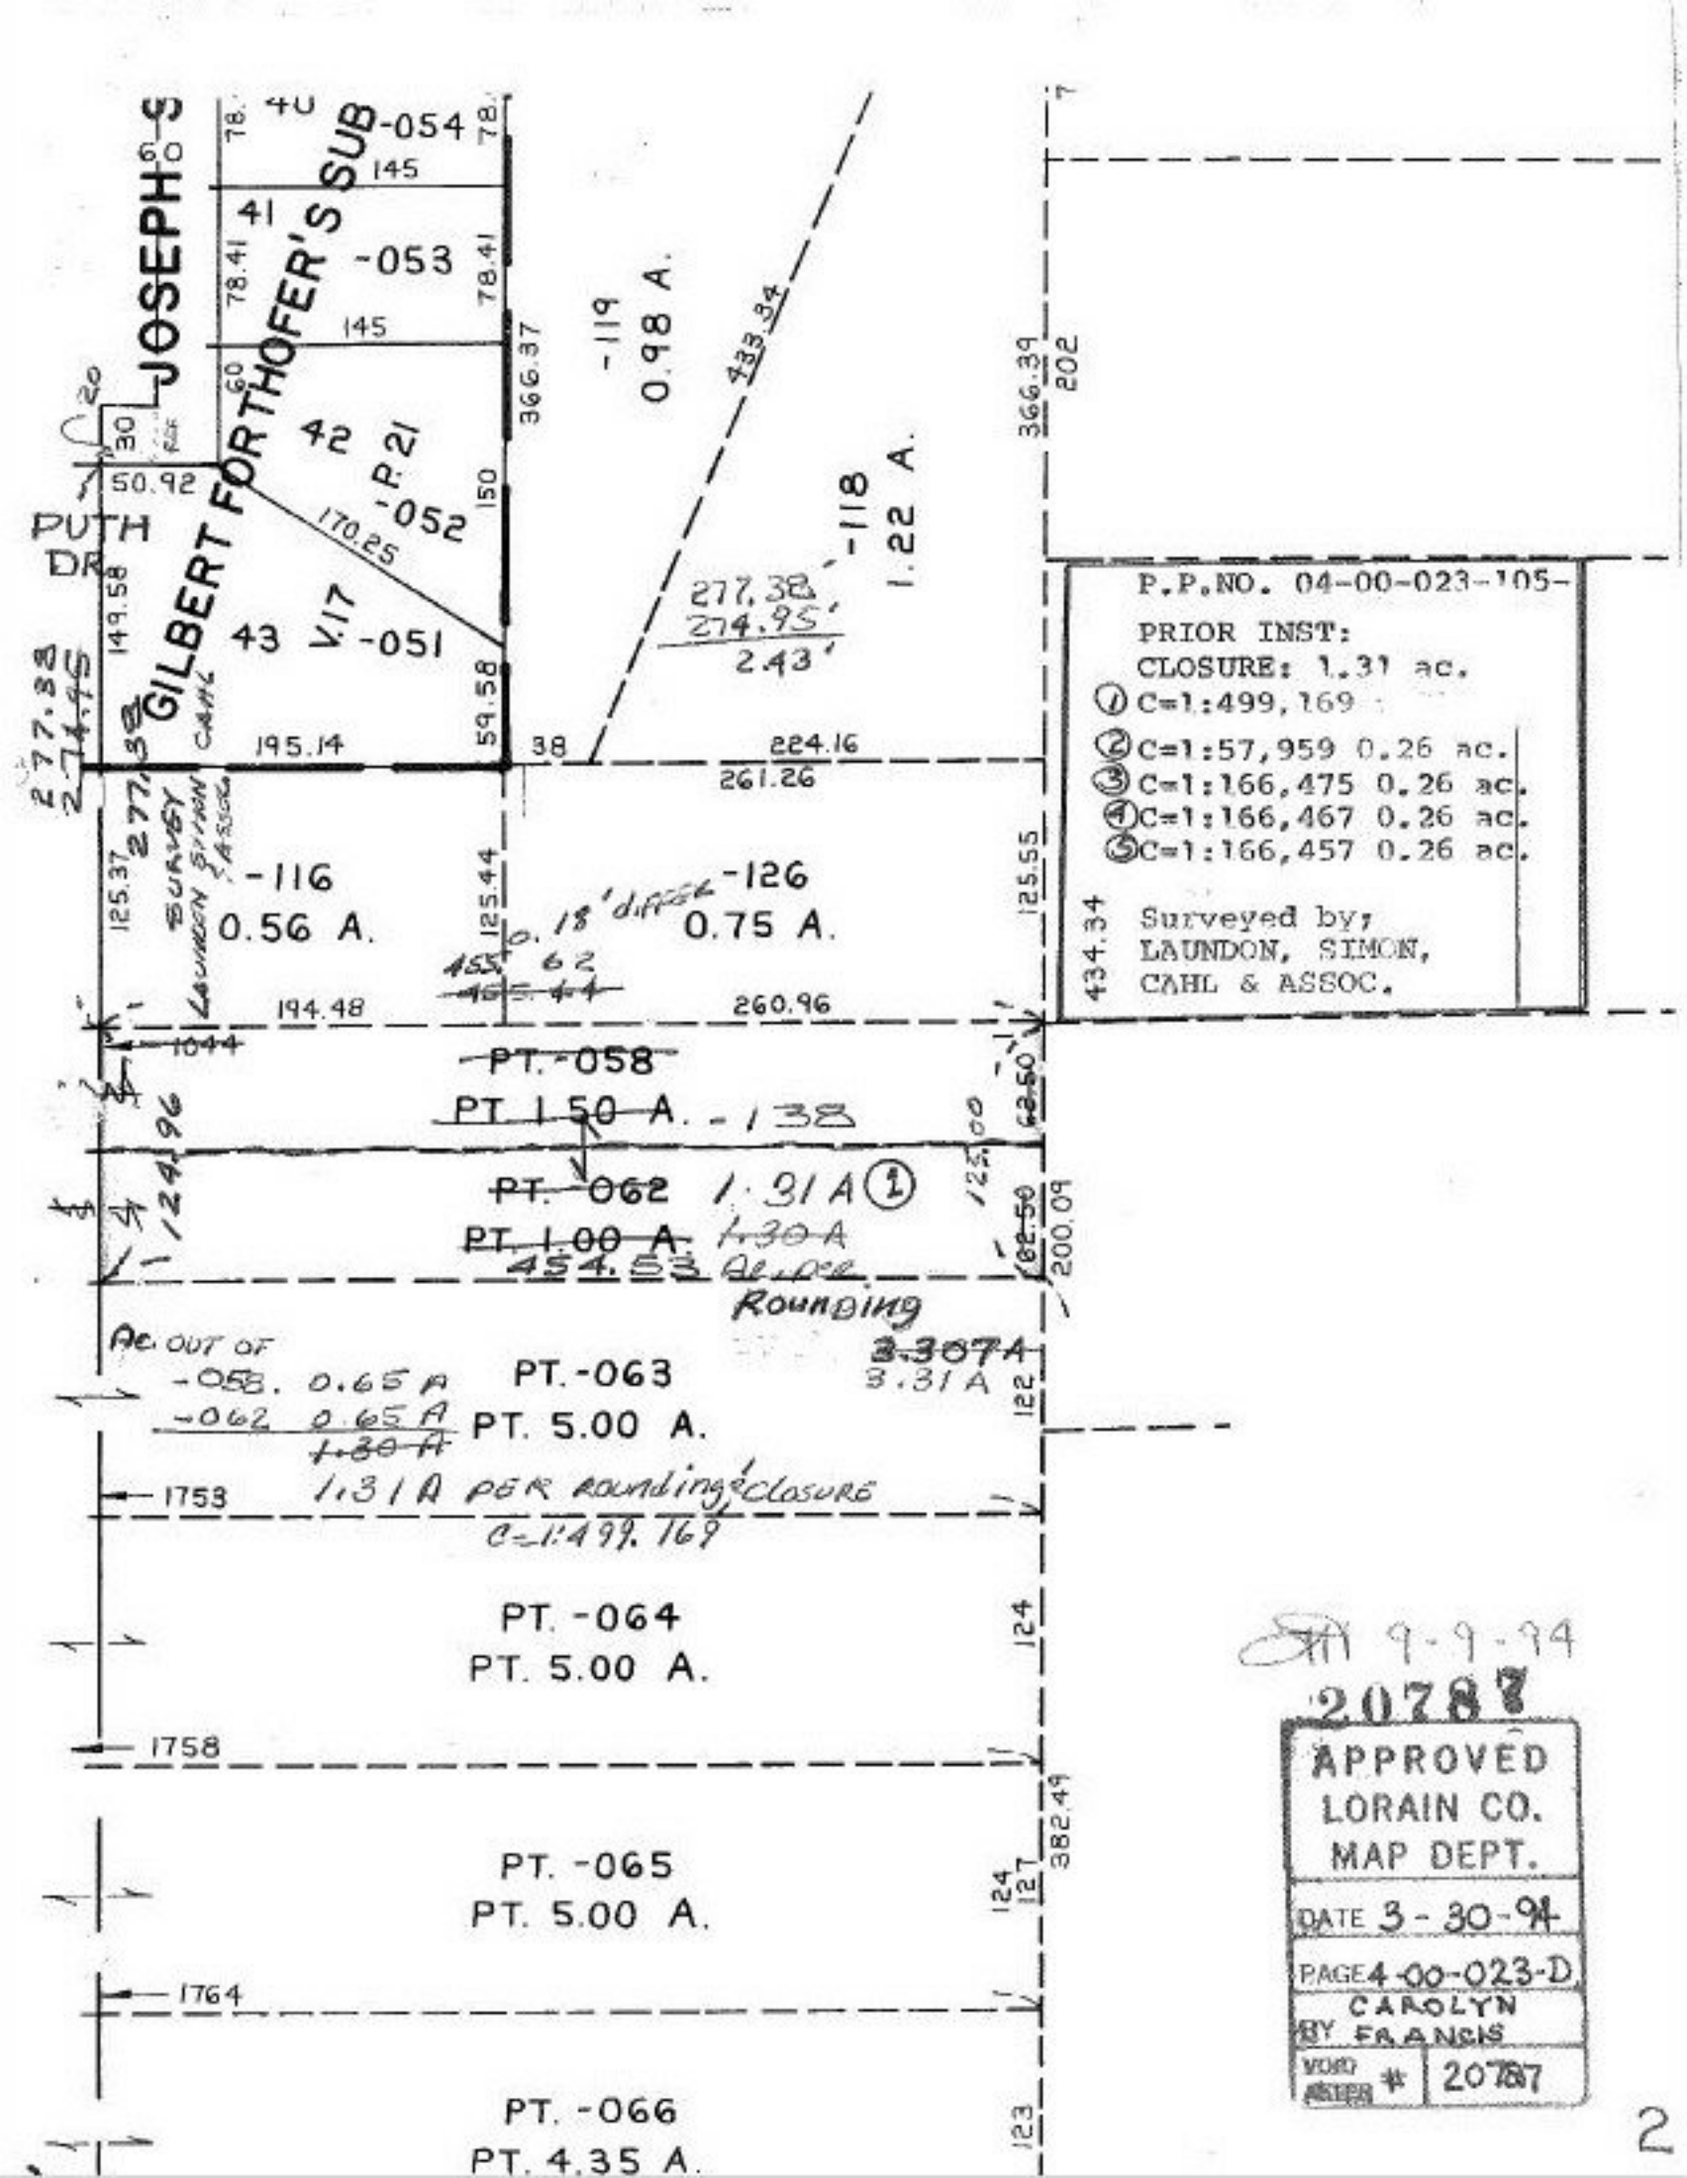
JOSEPH S
GILBERT FORTHOFER'S SUB
PUTH DR
-054
-053
-052
-051
-119
0.98 A.
-118
1.22 A.
-116
0.56 A.
-126
0.75 A.
PT. -058
PT. 1.50 A. -138
PT. -062 1.31 A
PT. 1.00 A. 1.30 A
454.53 Ac. per Rounding
3.307 A
3.31 A
Ac. OUT OF
-058. 0.65 A
-062 0.65 A
1.30 A
1.31 A PER rounding & closure
C=1:499.169
PT. -063
PT. 5.00 A.
PT. -064
PT. 5.00 A.
PT. -065
PT. 5.00 A.
PT. -066
PT. 4.35 A.
P.P.NO. 04-00-023-105-
PRIOR INST:
CLOSURE: 1.31 ac.
1 C=1:499,169
2 C=1:57,959 0.26 ac.
3 C=1:166,475 0.26 ac.
4 C=1:166,467 0.26 ac.
5 C=1:166,457 0.26 ac.
Surveyed by;
LAUNDON, SIMON,
CAHL & ASSOC.
9-9-94
20787
APPROVED
LORAIN CO.
MAP DEPT.
DATE 3-30-94
PAGE 4-00-023-D
BY CAROLYN FRANCIS
VOID AFTER # 20787