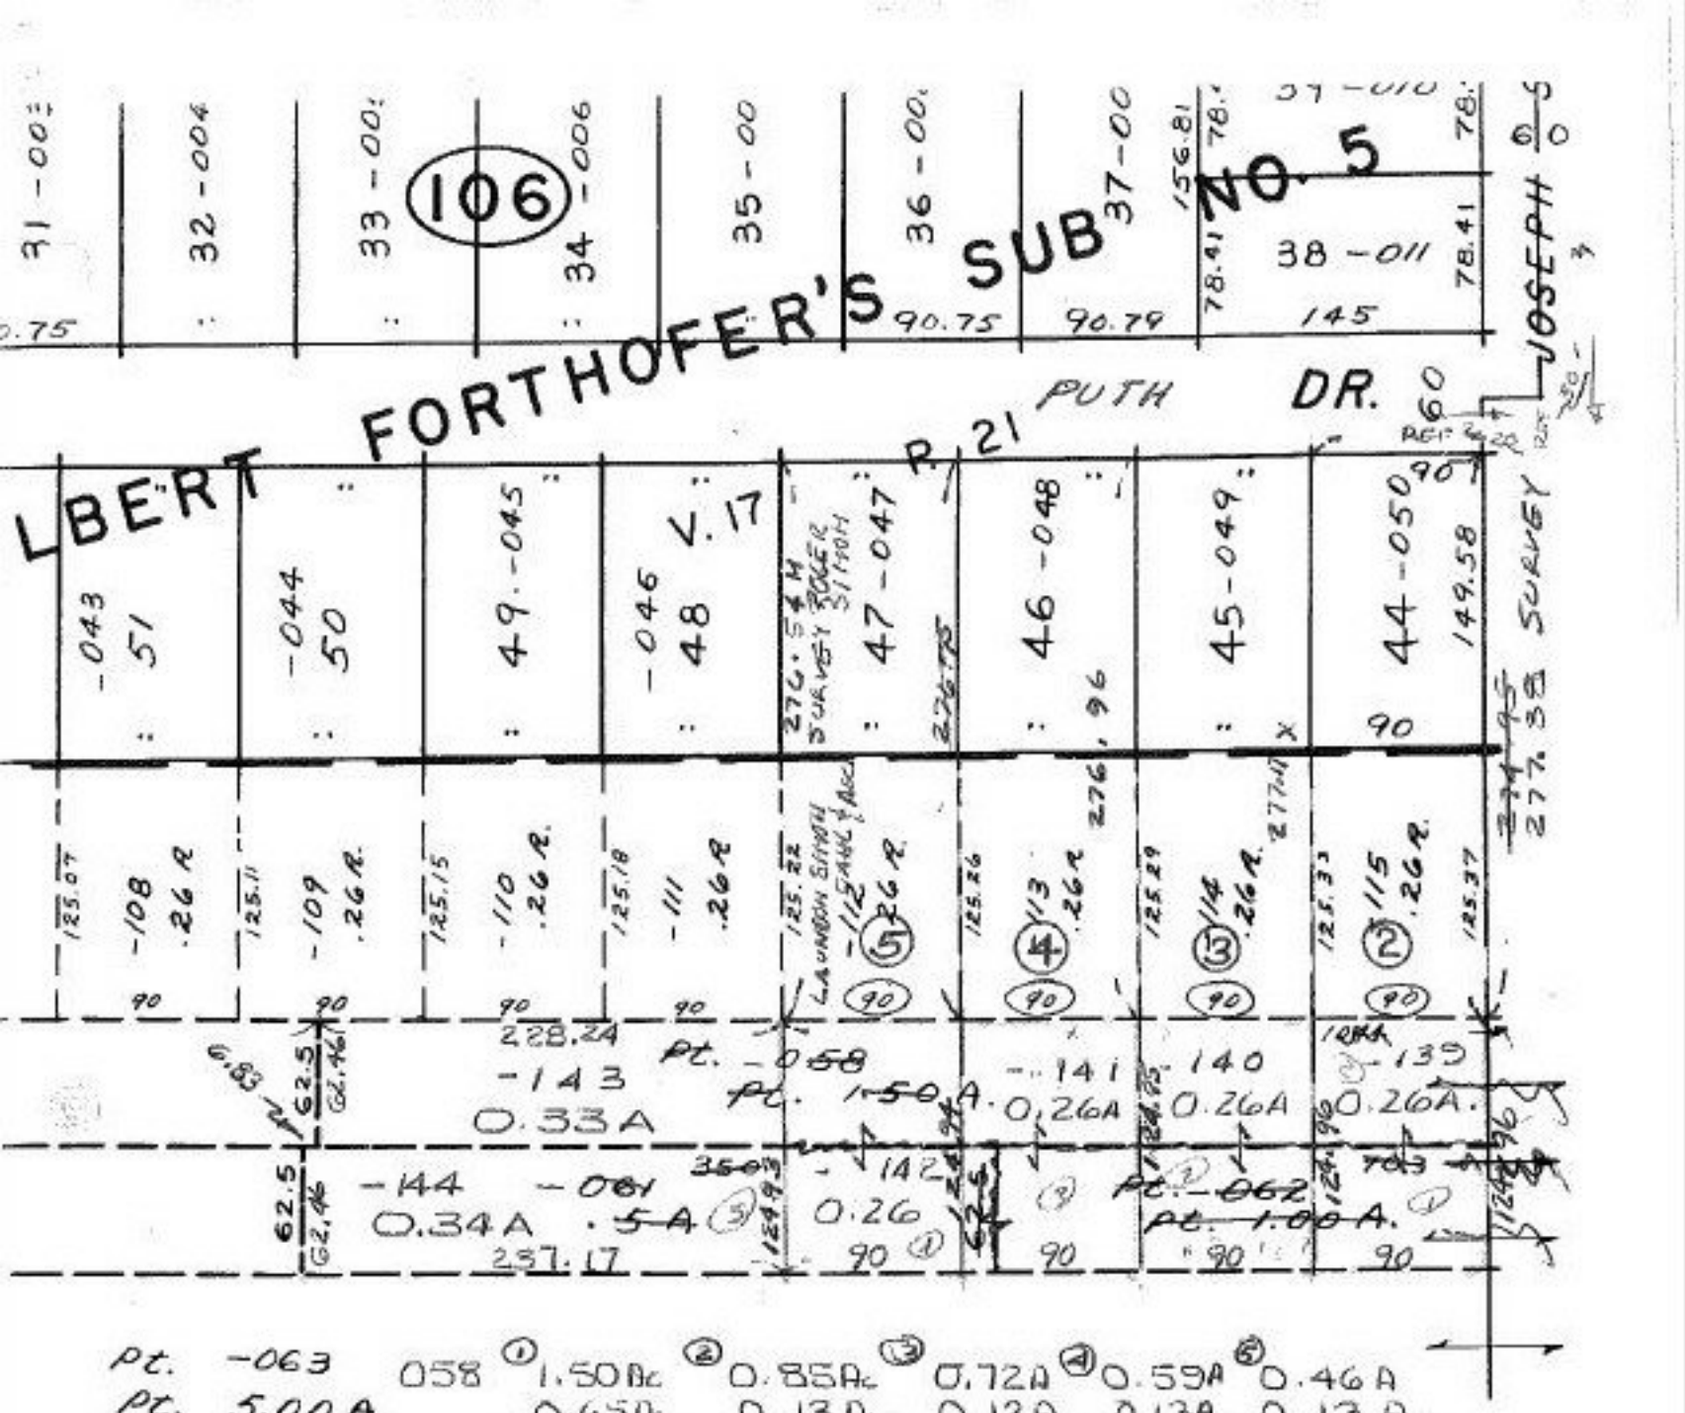

20787

SM 9-9-94

APPROVED
LORAIN CO.
MAP DEPT.
DATE 3-30-94
PAGE 4-00-023C
CAROLYN
BY FRANCIS
VOL # 20787