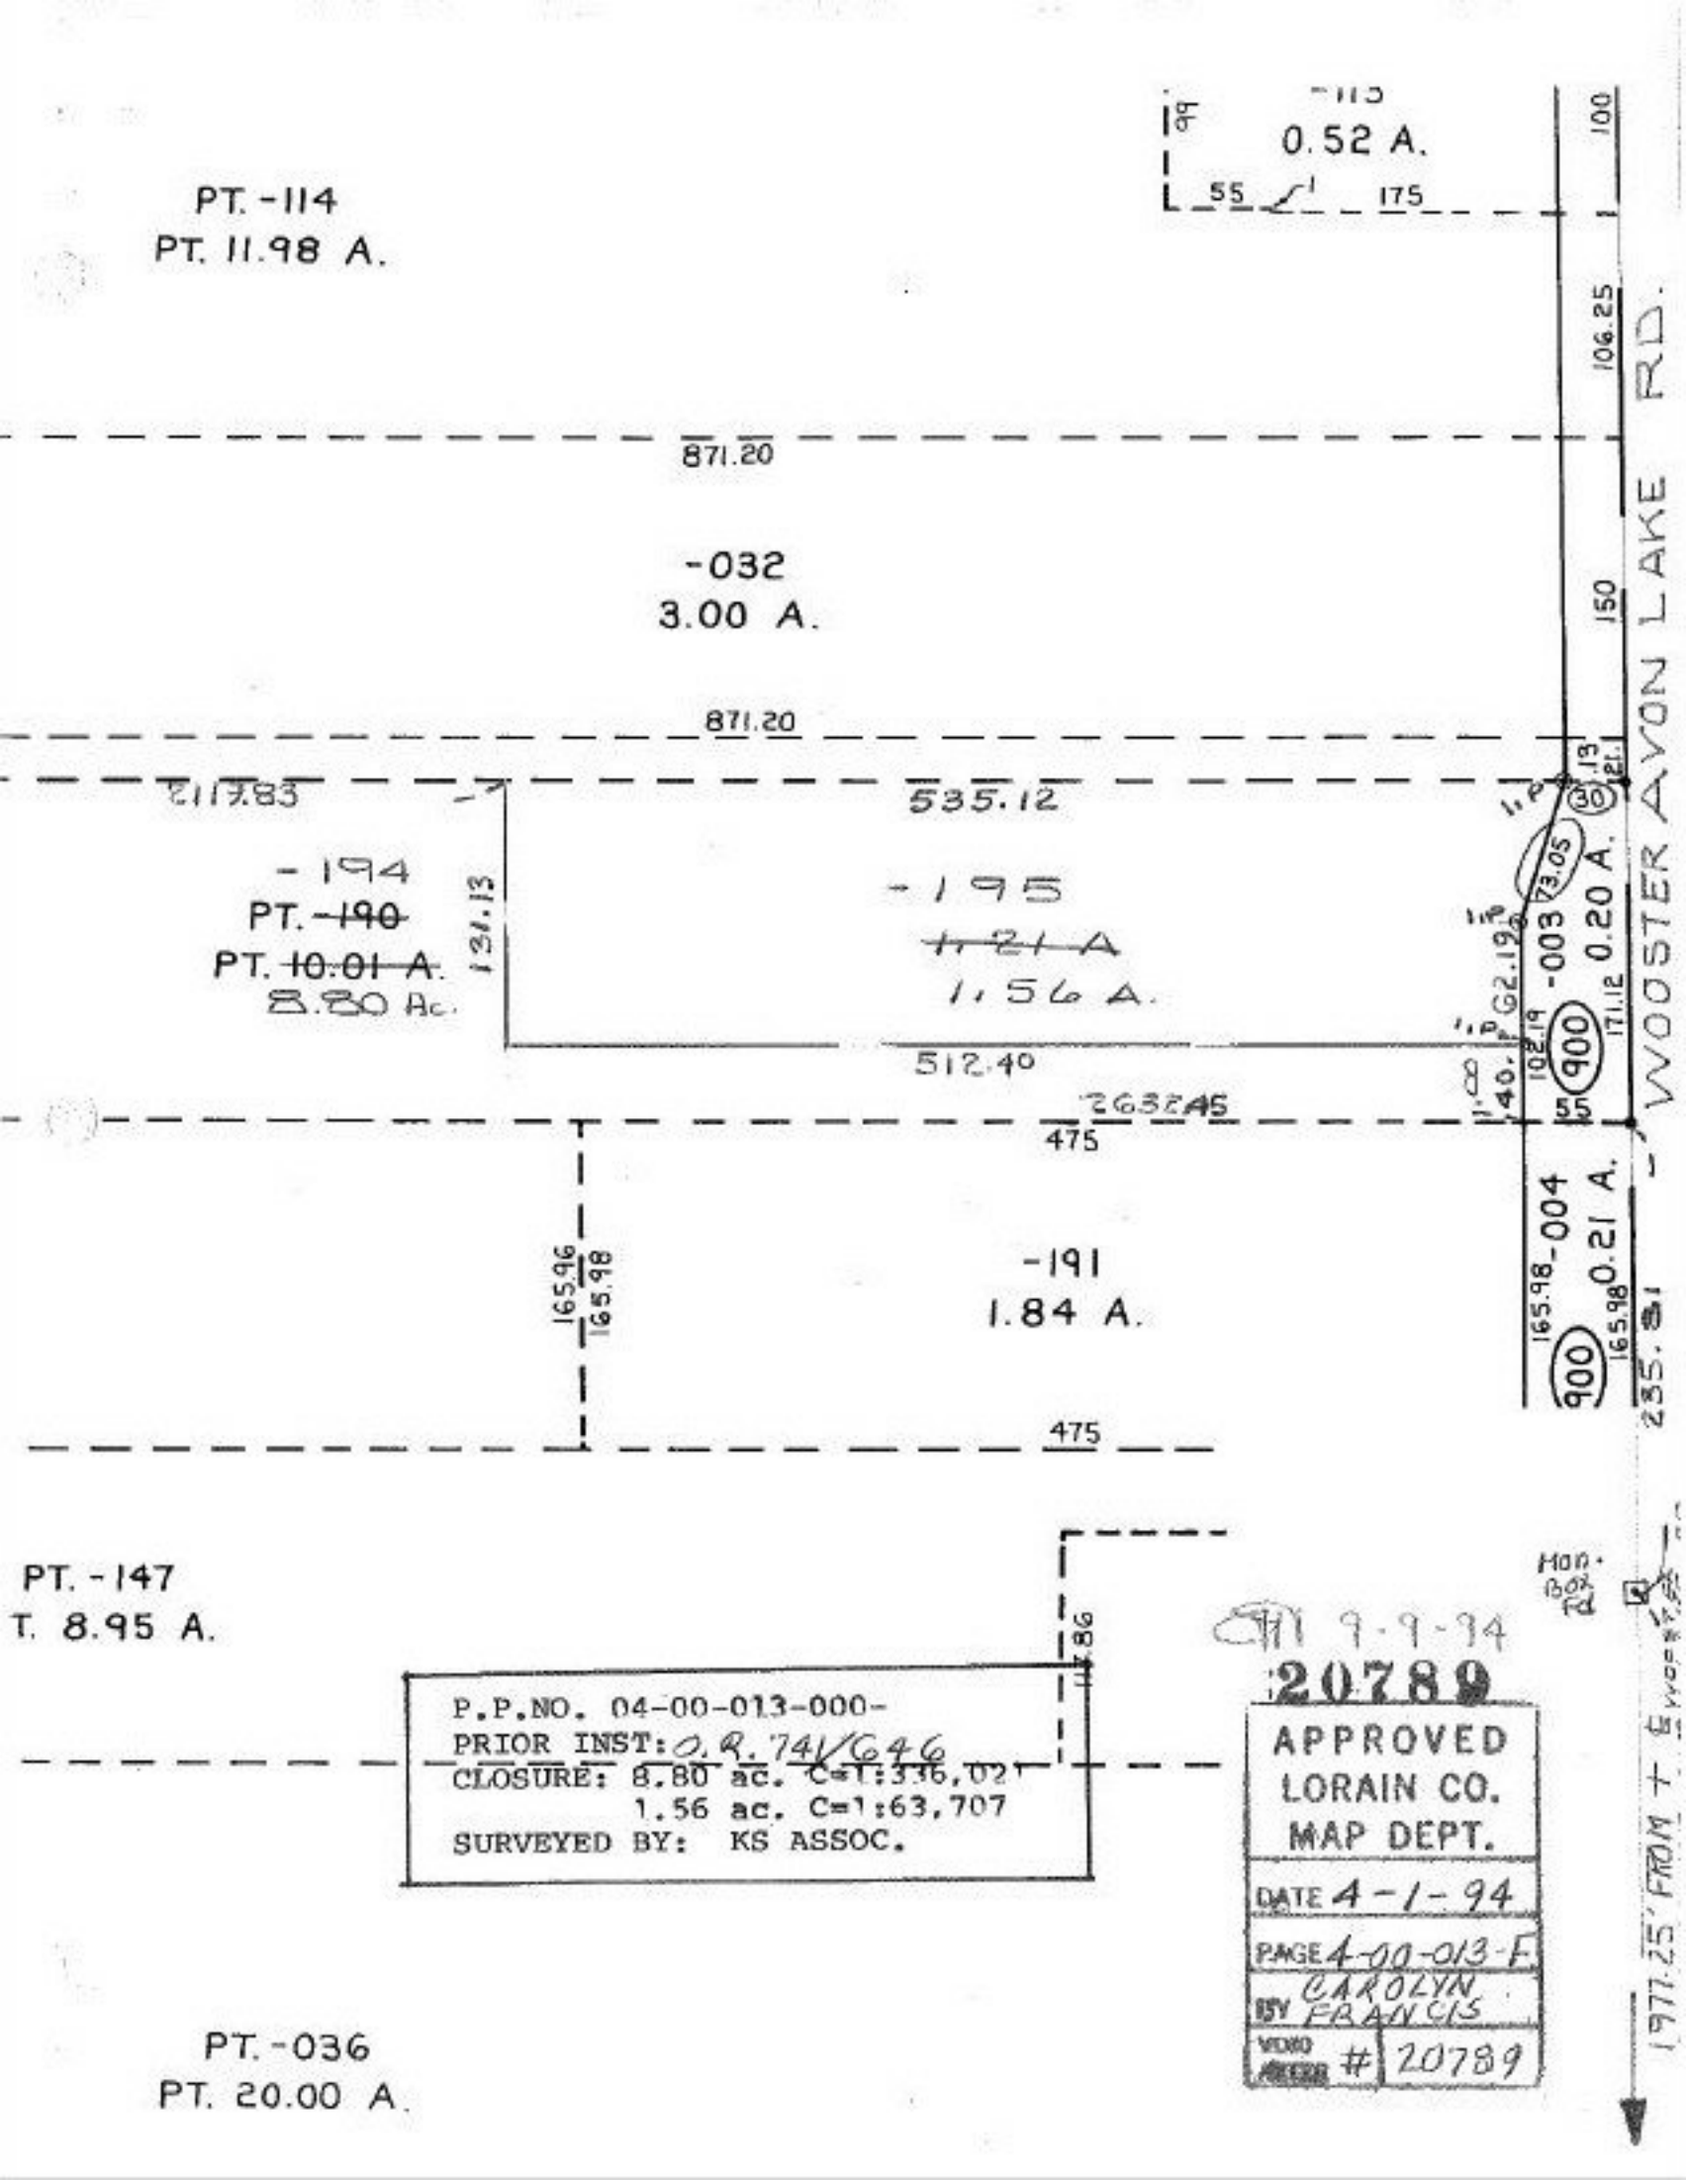

PT. -114
PT. 11.98 A.
-113
0.52 A.
55
175
100
106.25
871.20
-032
3.00 A.
150
871.20
2117.83
535.12
-194
PT. ~~-190~~
PT. ~~10.01 A.~~
8.80 Ac.
131.13
-195
~~1.21 A~~
1.56 A.
512.40
2632.45
475
-003
0.20 A.
900
171.12
55
WOOSTER AVON LAKE RD.
-004
0.21 A.
165.98
165.98
-191
1.84 A.
165.96
165.98
475
PT. -147
T. 8.95 A.
P.P.NO. 04-00-013-000-
PRIOR INST: O.R. 741/646
CLOSURE: 8.80 ac. C=1:336,021
1.56 ac. C=1:63,707
SURVEYED BY: KS ASSOC.
9-9-94
20789
APPROVED
LORAIN CO.
MAP DEPT.
DATE 4-1-94
PAGE 4-00-013-F
BY CAROLYN FRANCIS
VOID # 20789
1977.25' FROM
PT. -036
PT. 20.00 A.