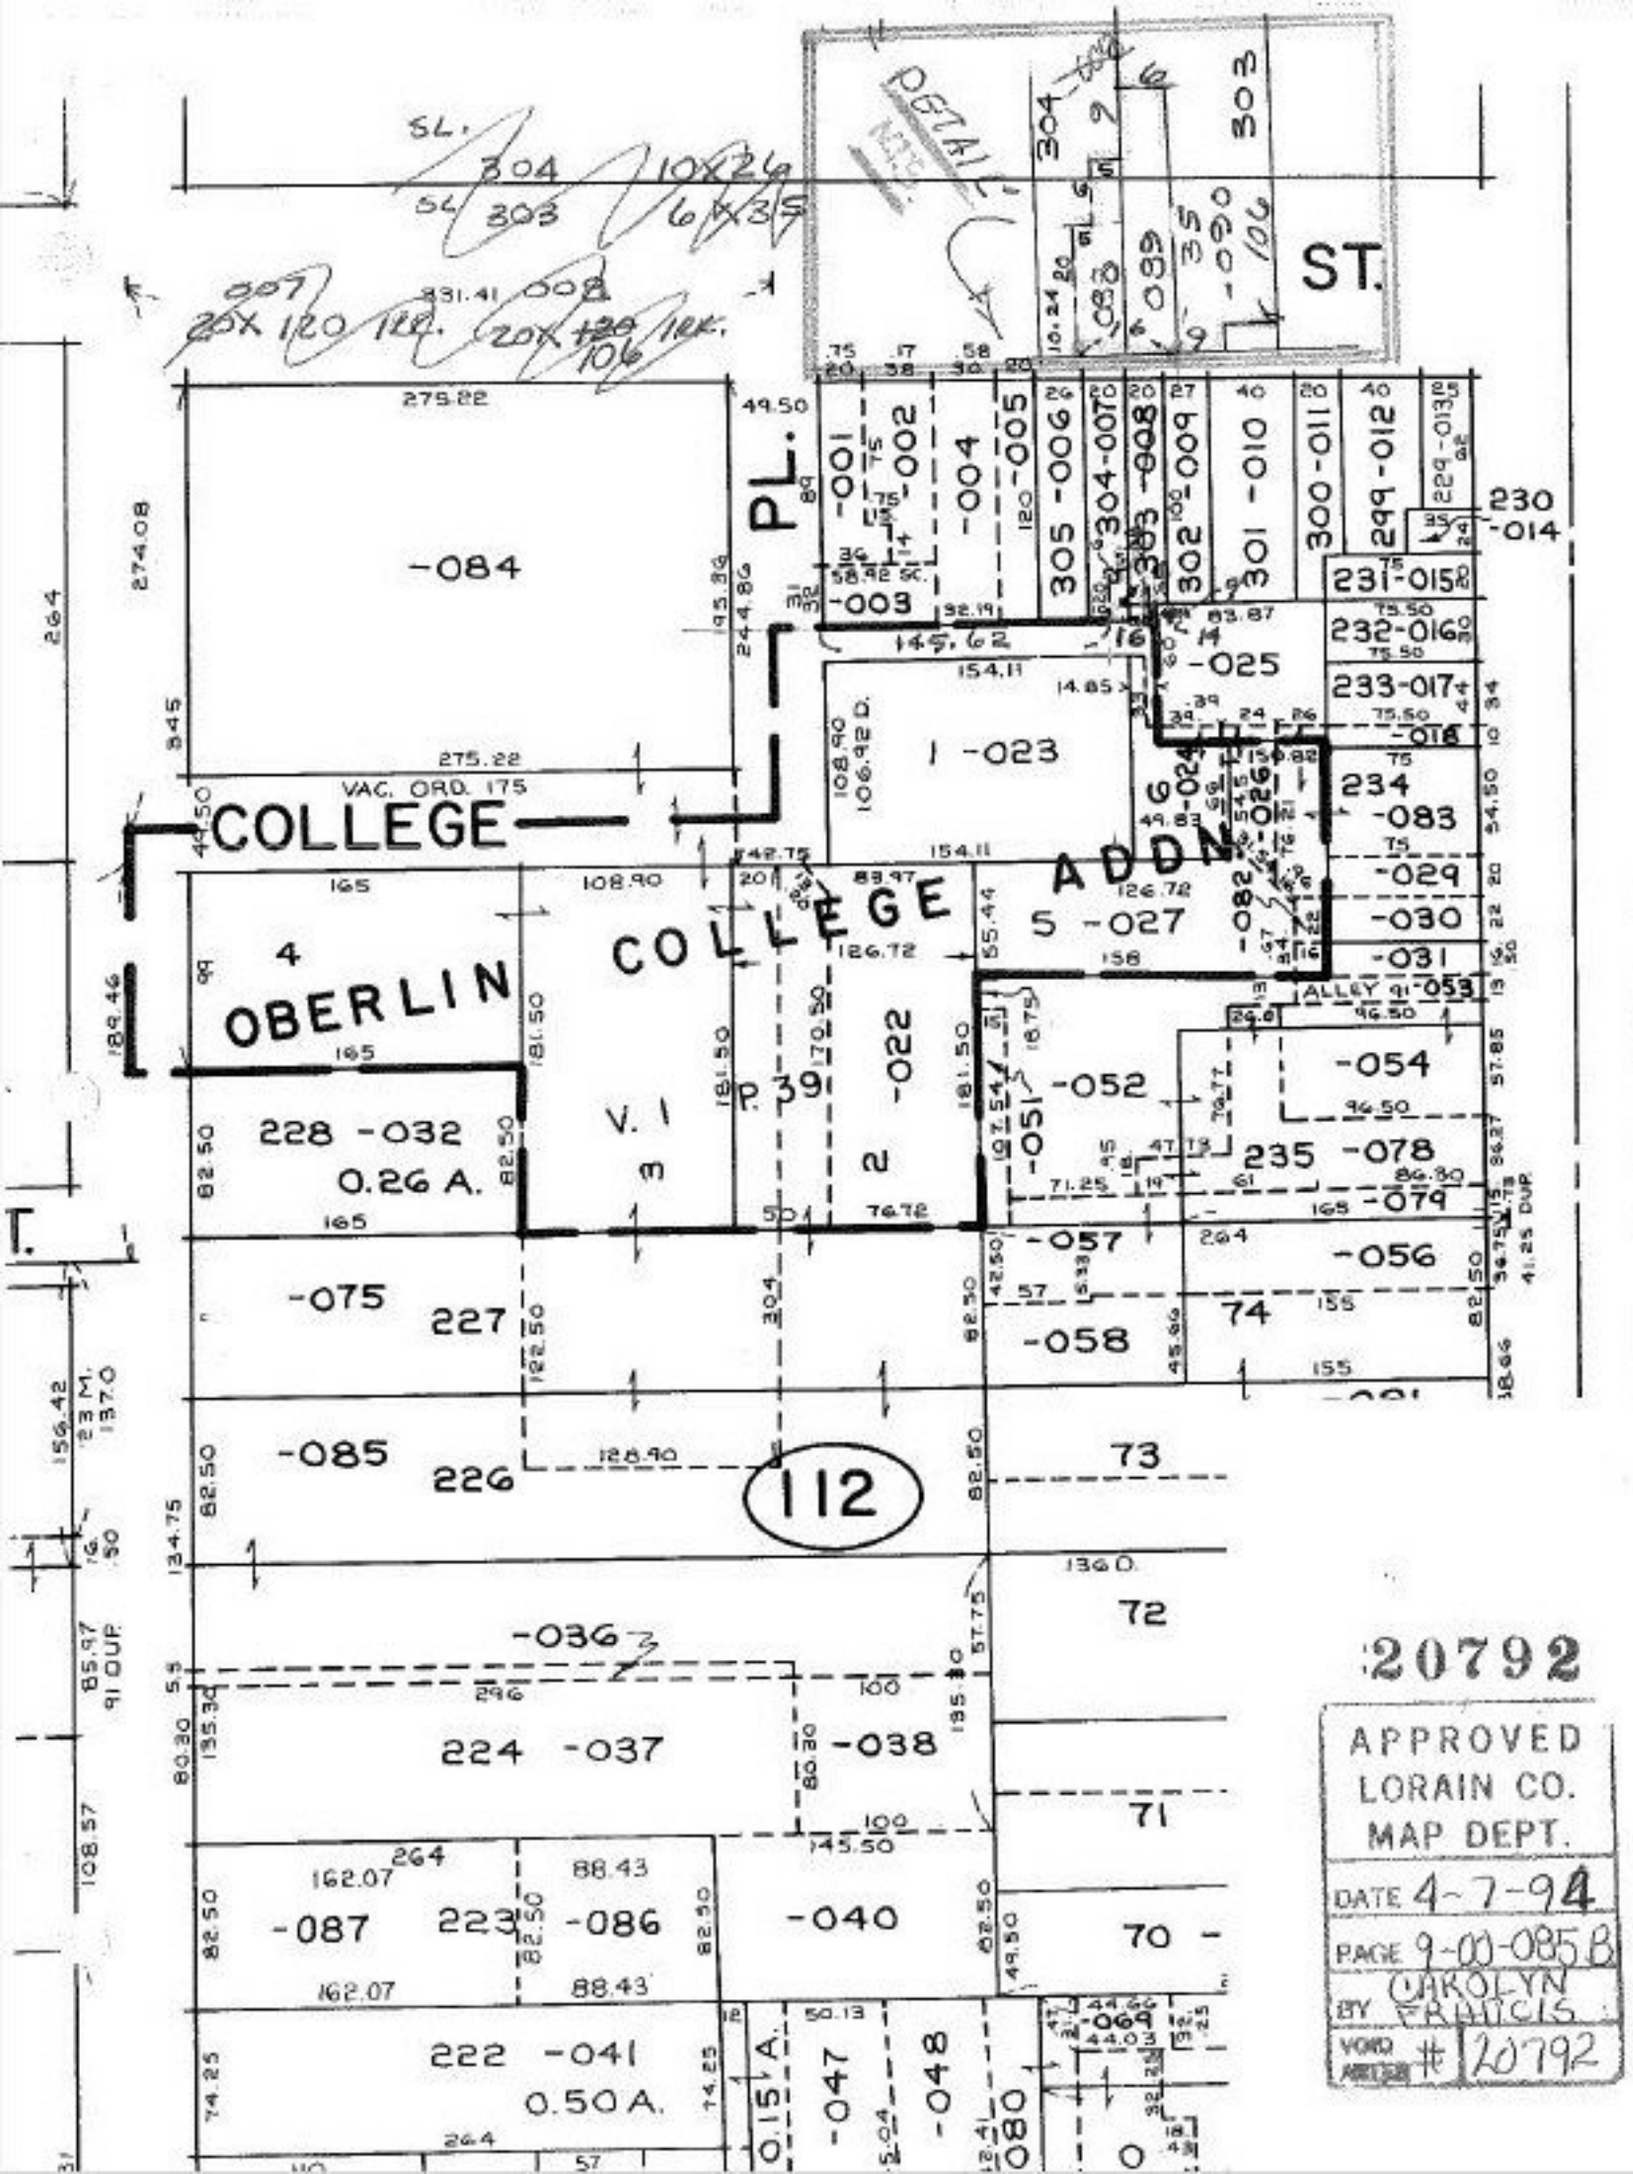

ST.
PL.
COLLEGE
OBERLIN COLLEGE ADDN
VAC. ORD. 175
ALLEY
112
20792
APPROVED
LORAIN CO.
MAP DEPT.
DATE 4-7-94
PAGE 9-00-085 B
BY CAROLYN FRANCIS
VOID ARTER # 20792