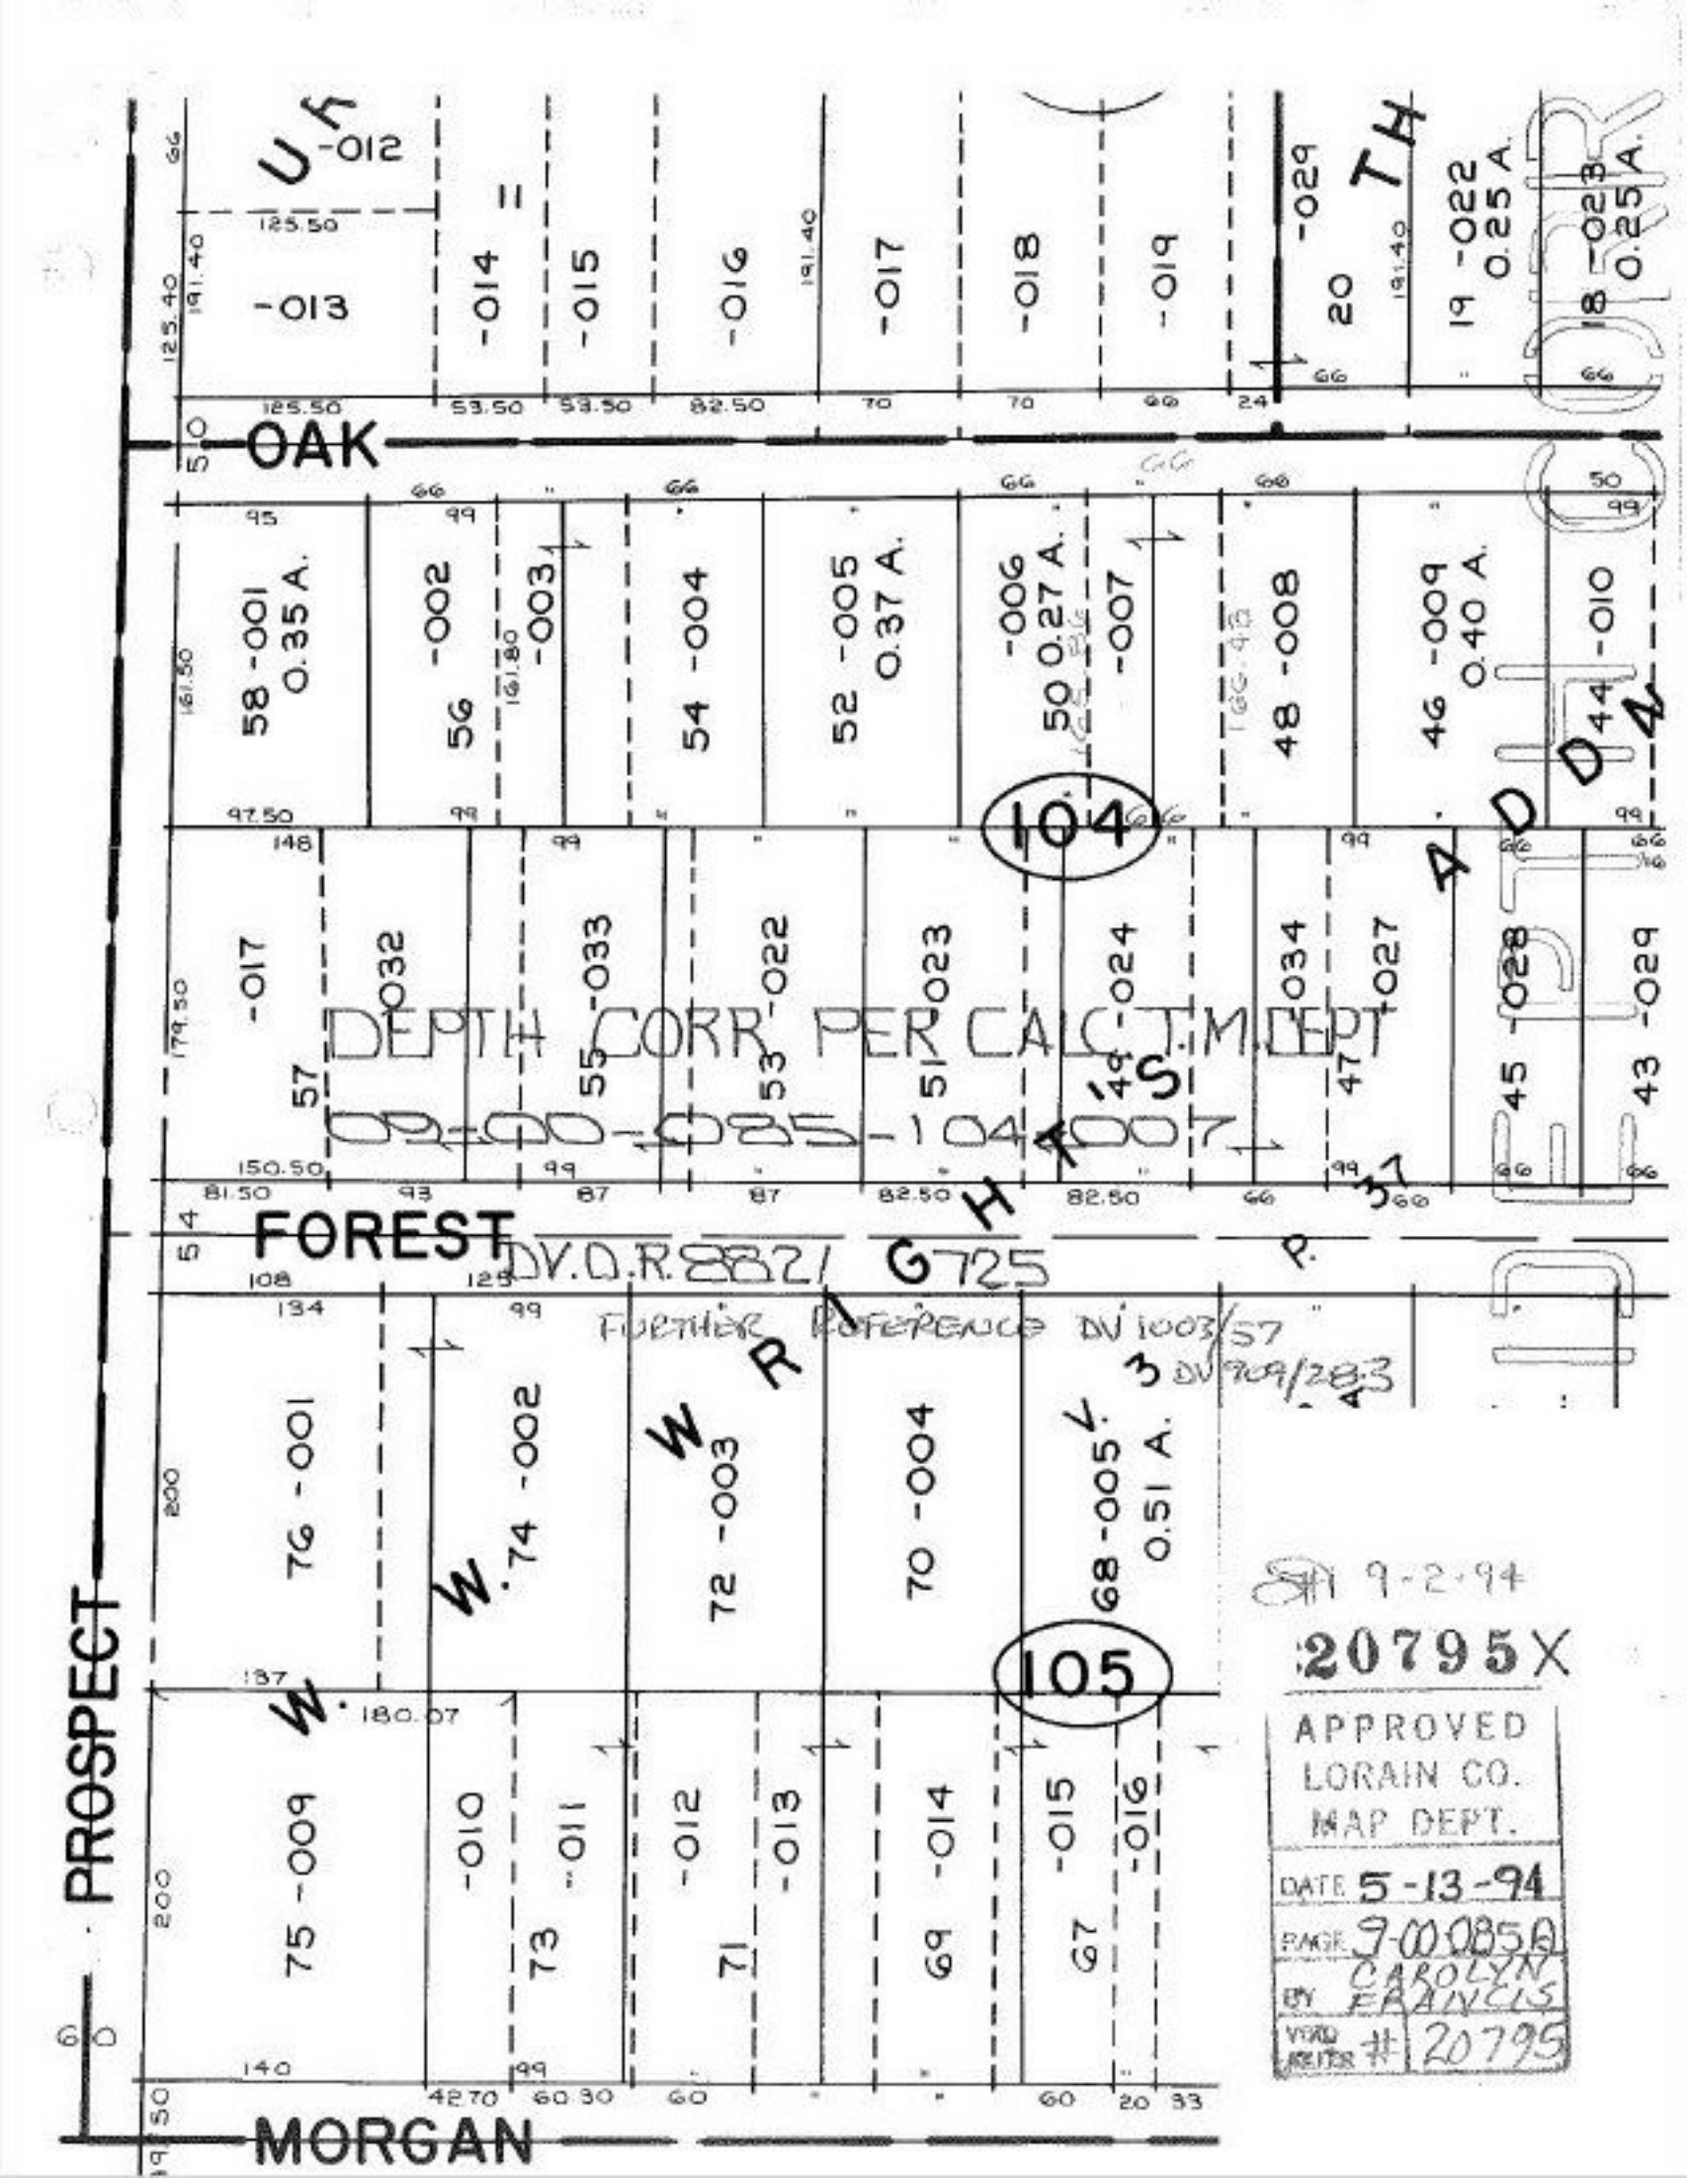
OAK
FOREST
MORGAN
PROSPECT
104
105
DEPTH CORR PER CALC T.M.DEPT
09-00-085-104-007
DV.O.R.8821 G725
FURTHER REFERENCE DV 1003/57
DV 909/283
9-2-94
20795X
APPROVED
LORAIN CO.
MAP DEPT.
DATE 5-13-94
PAGE 9-00-085A
BY CAROLYN FRANCIS
VERD REFER # 20795