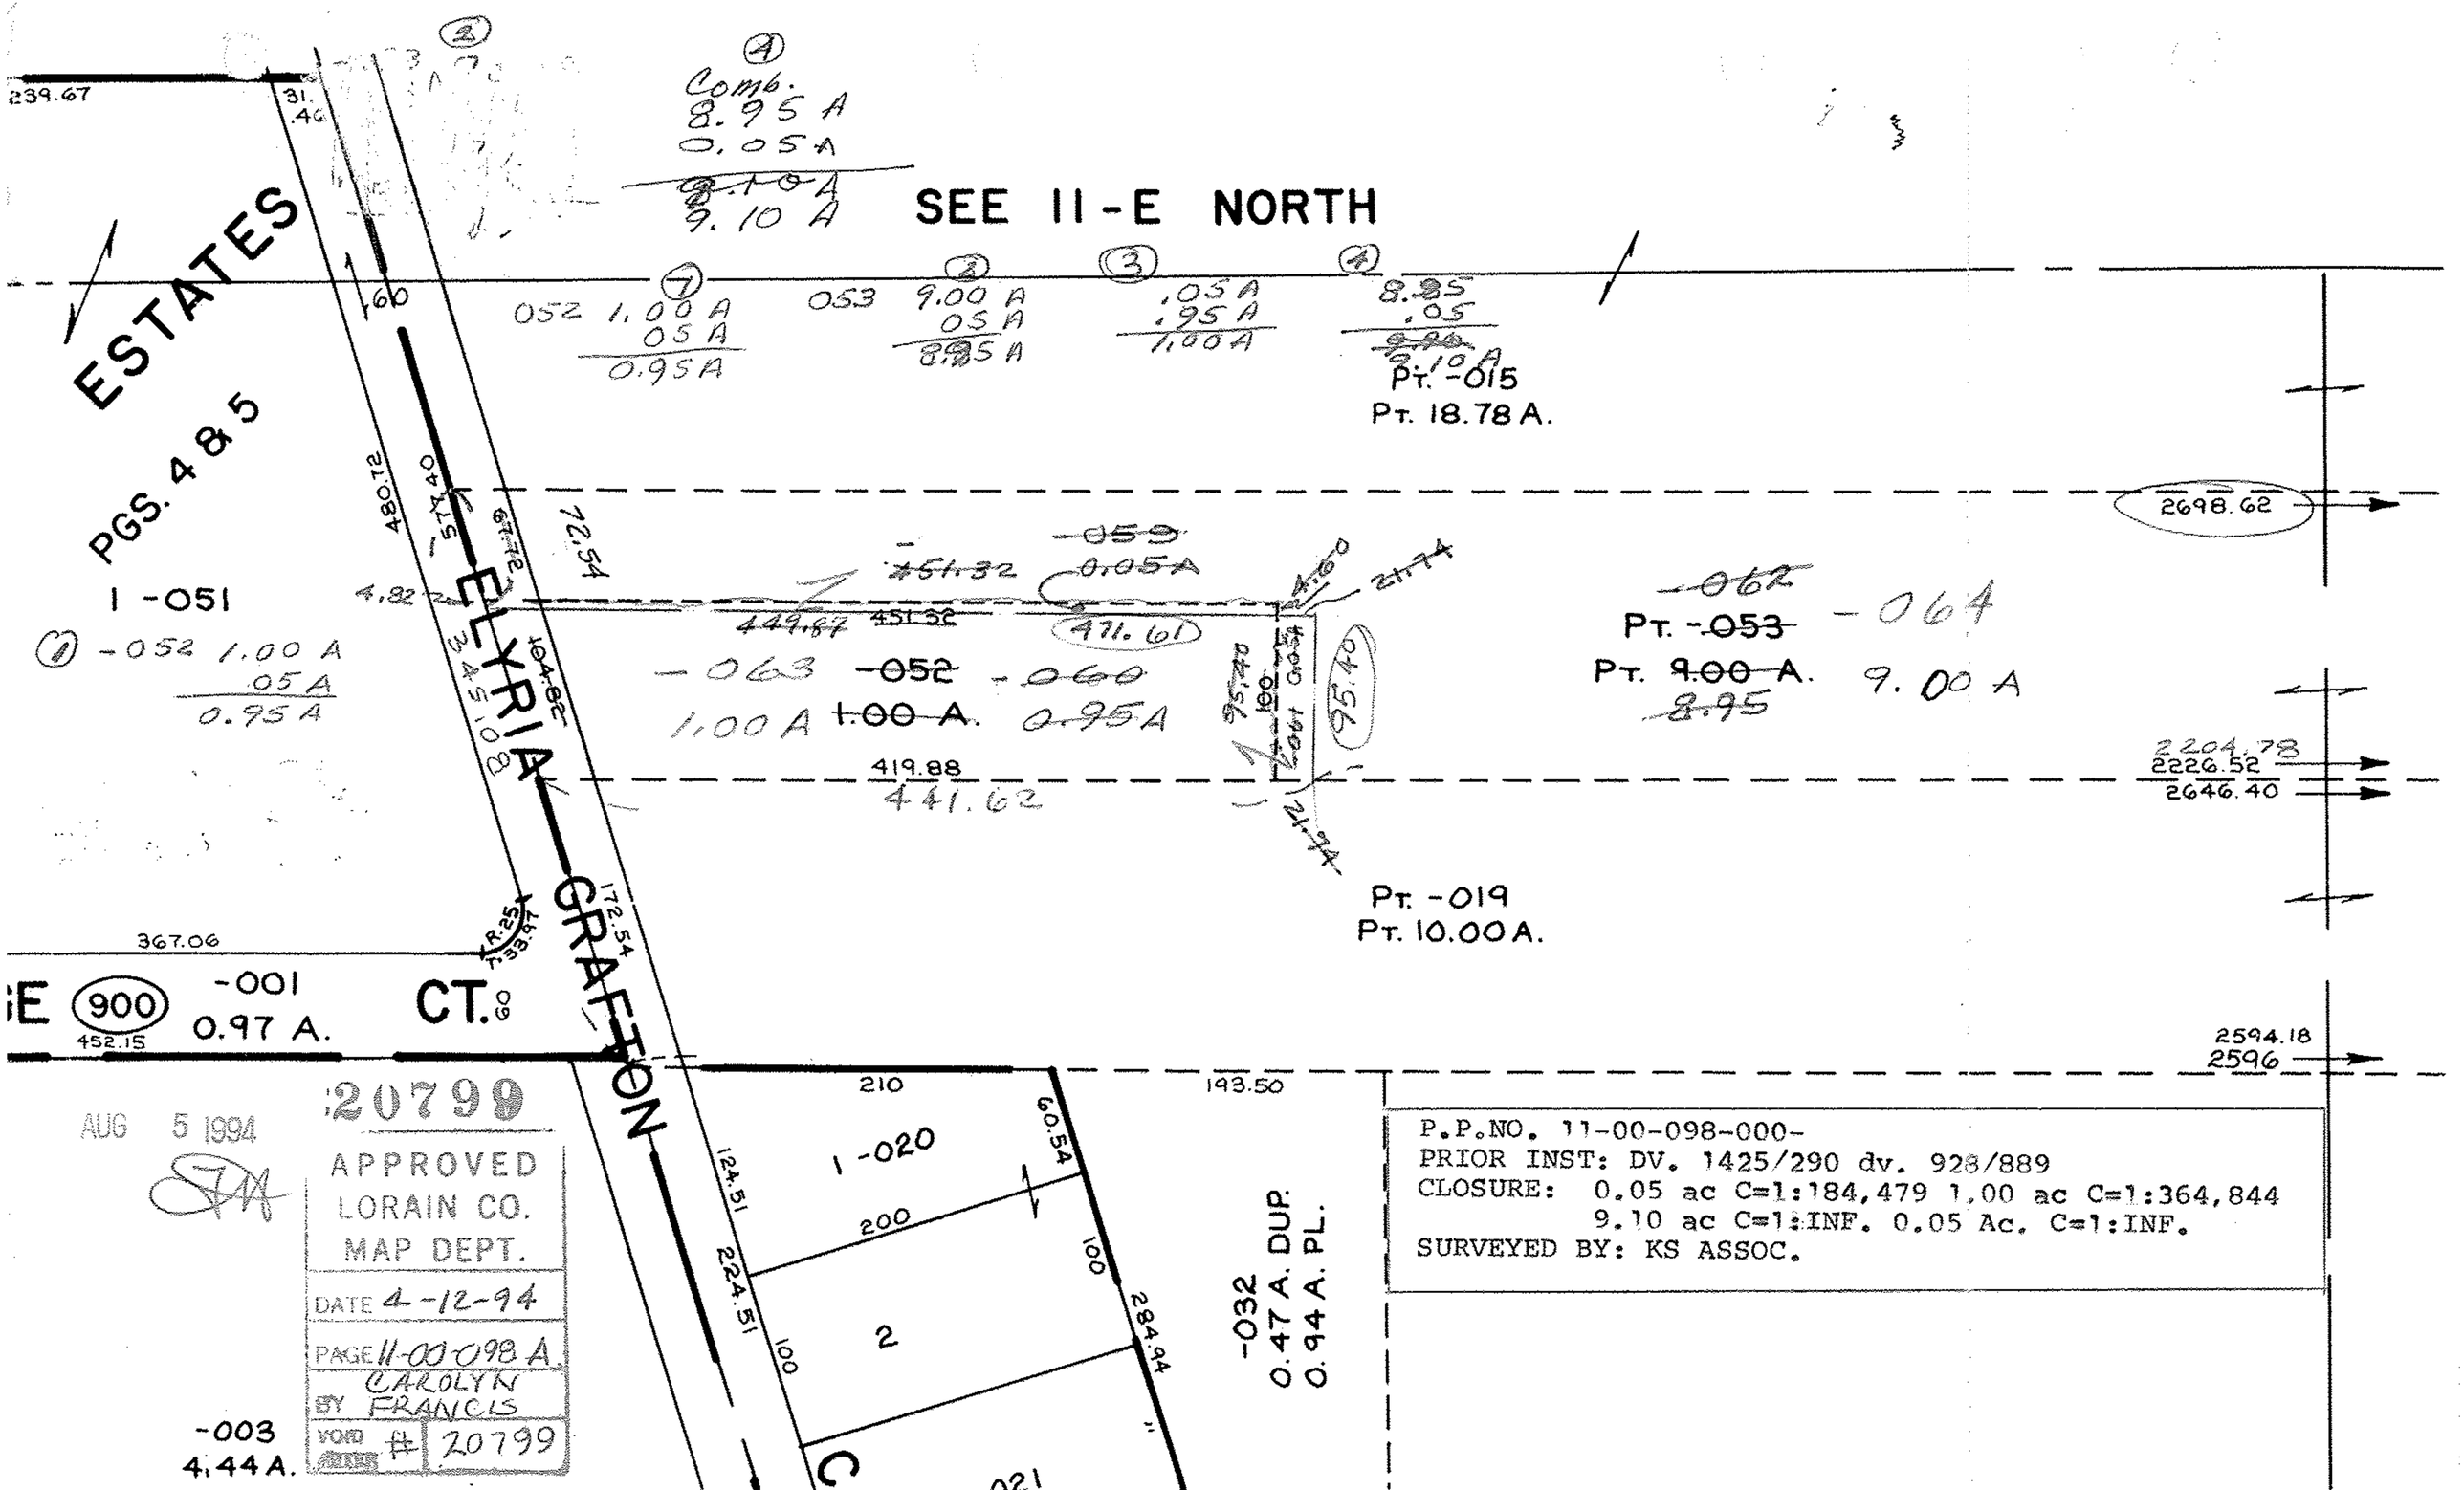

P.P.NO. 11-00-098-000-
PRIOR INST: DV. 1425/290 dv. 928/889
CLOSURE: 0.05 ac C=1:184,479 1.00 ac C=1:364,844
9.10 ac C=1:INF. 0.05 Ac. C=1:INF.
SURVEYED BY: KS ASSOC.