20805

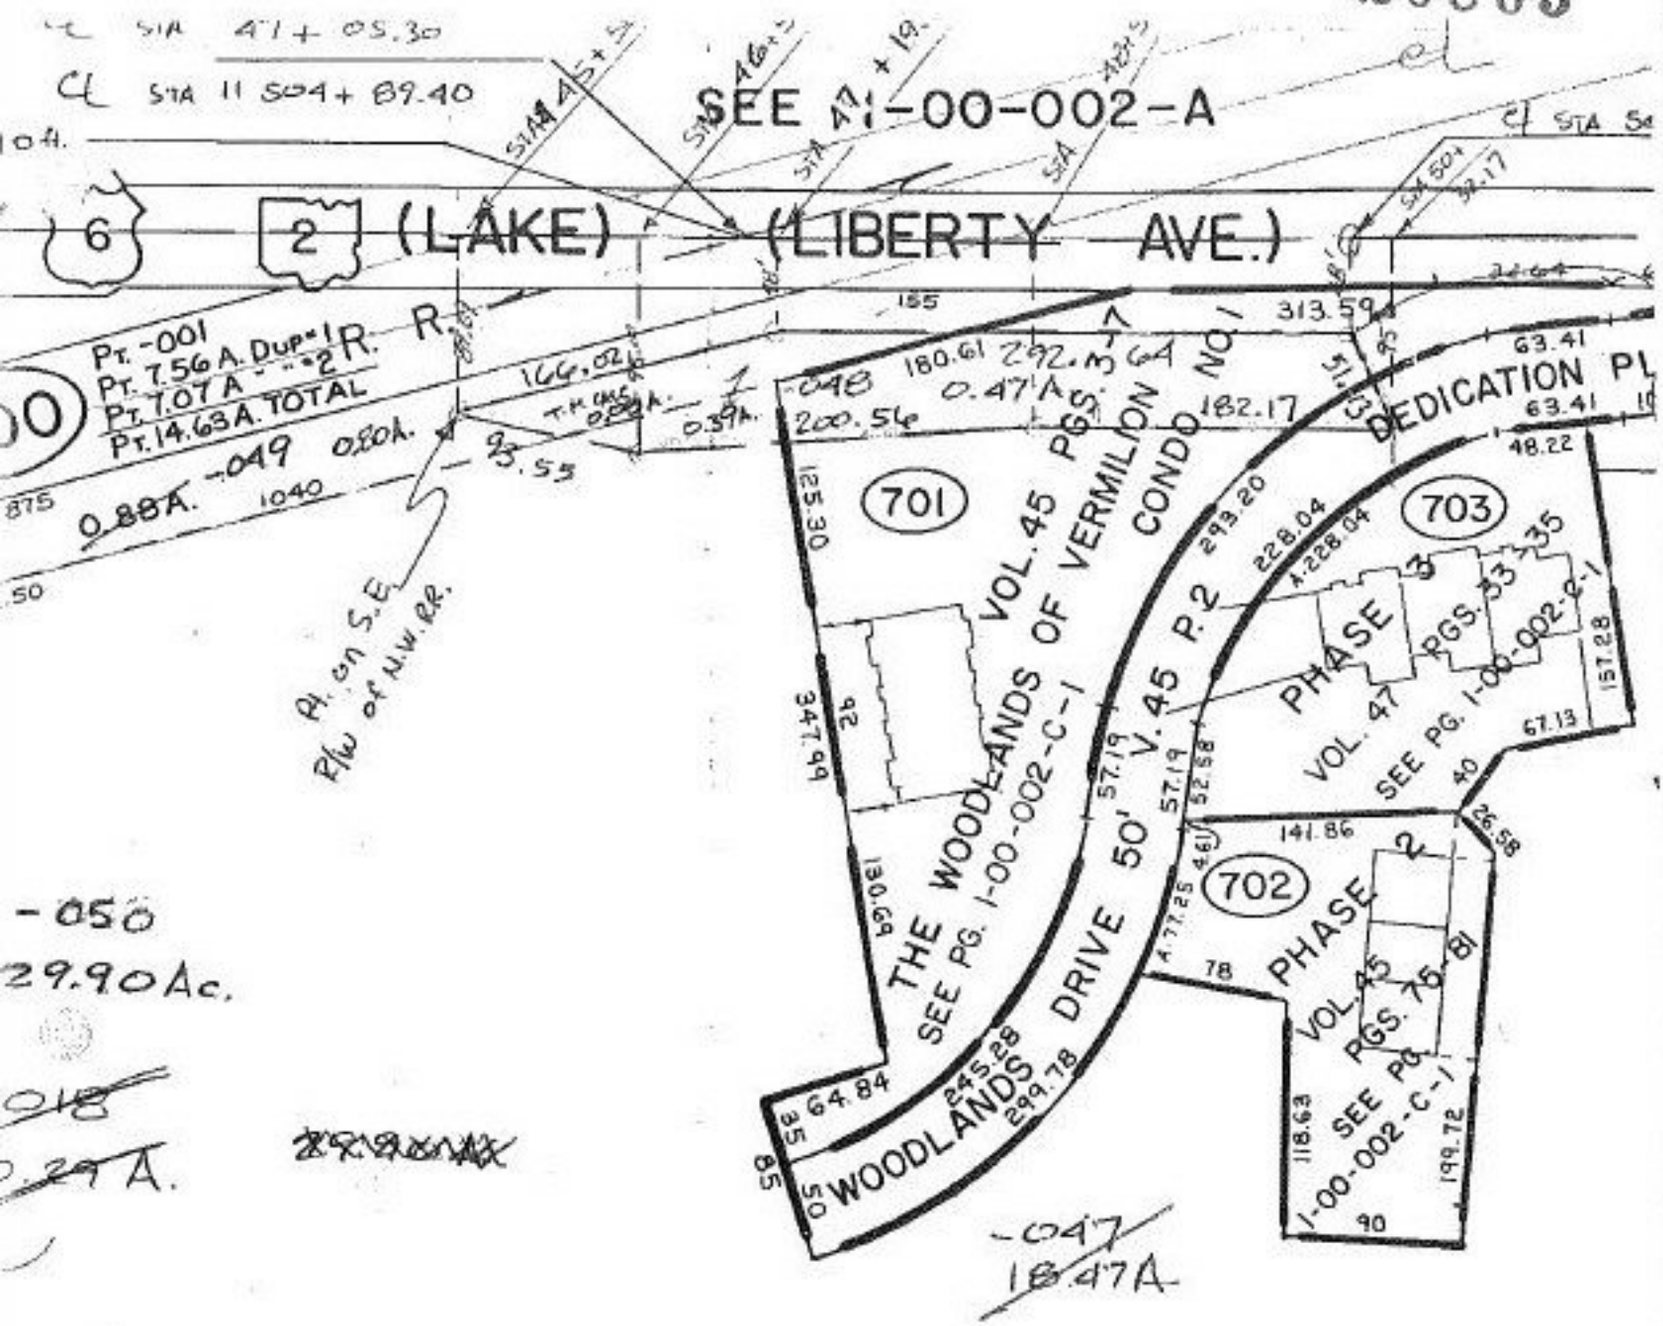

#20805

APPROVED
LORAIN CO.
MAP DEPT.

DATE 6-2-94

PAGE 1-00-002-C

BY T. McMain

VERD. NO. 20805

558.16
548.46
558.46

SEE SURVEY BY — ODOT
DAVID ARMSTRONG PS 5788
JAN. '88

CL. 1: 88,430

PRIOR INST. REF. - OR 192/281

115