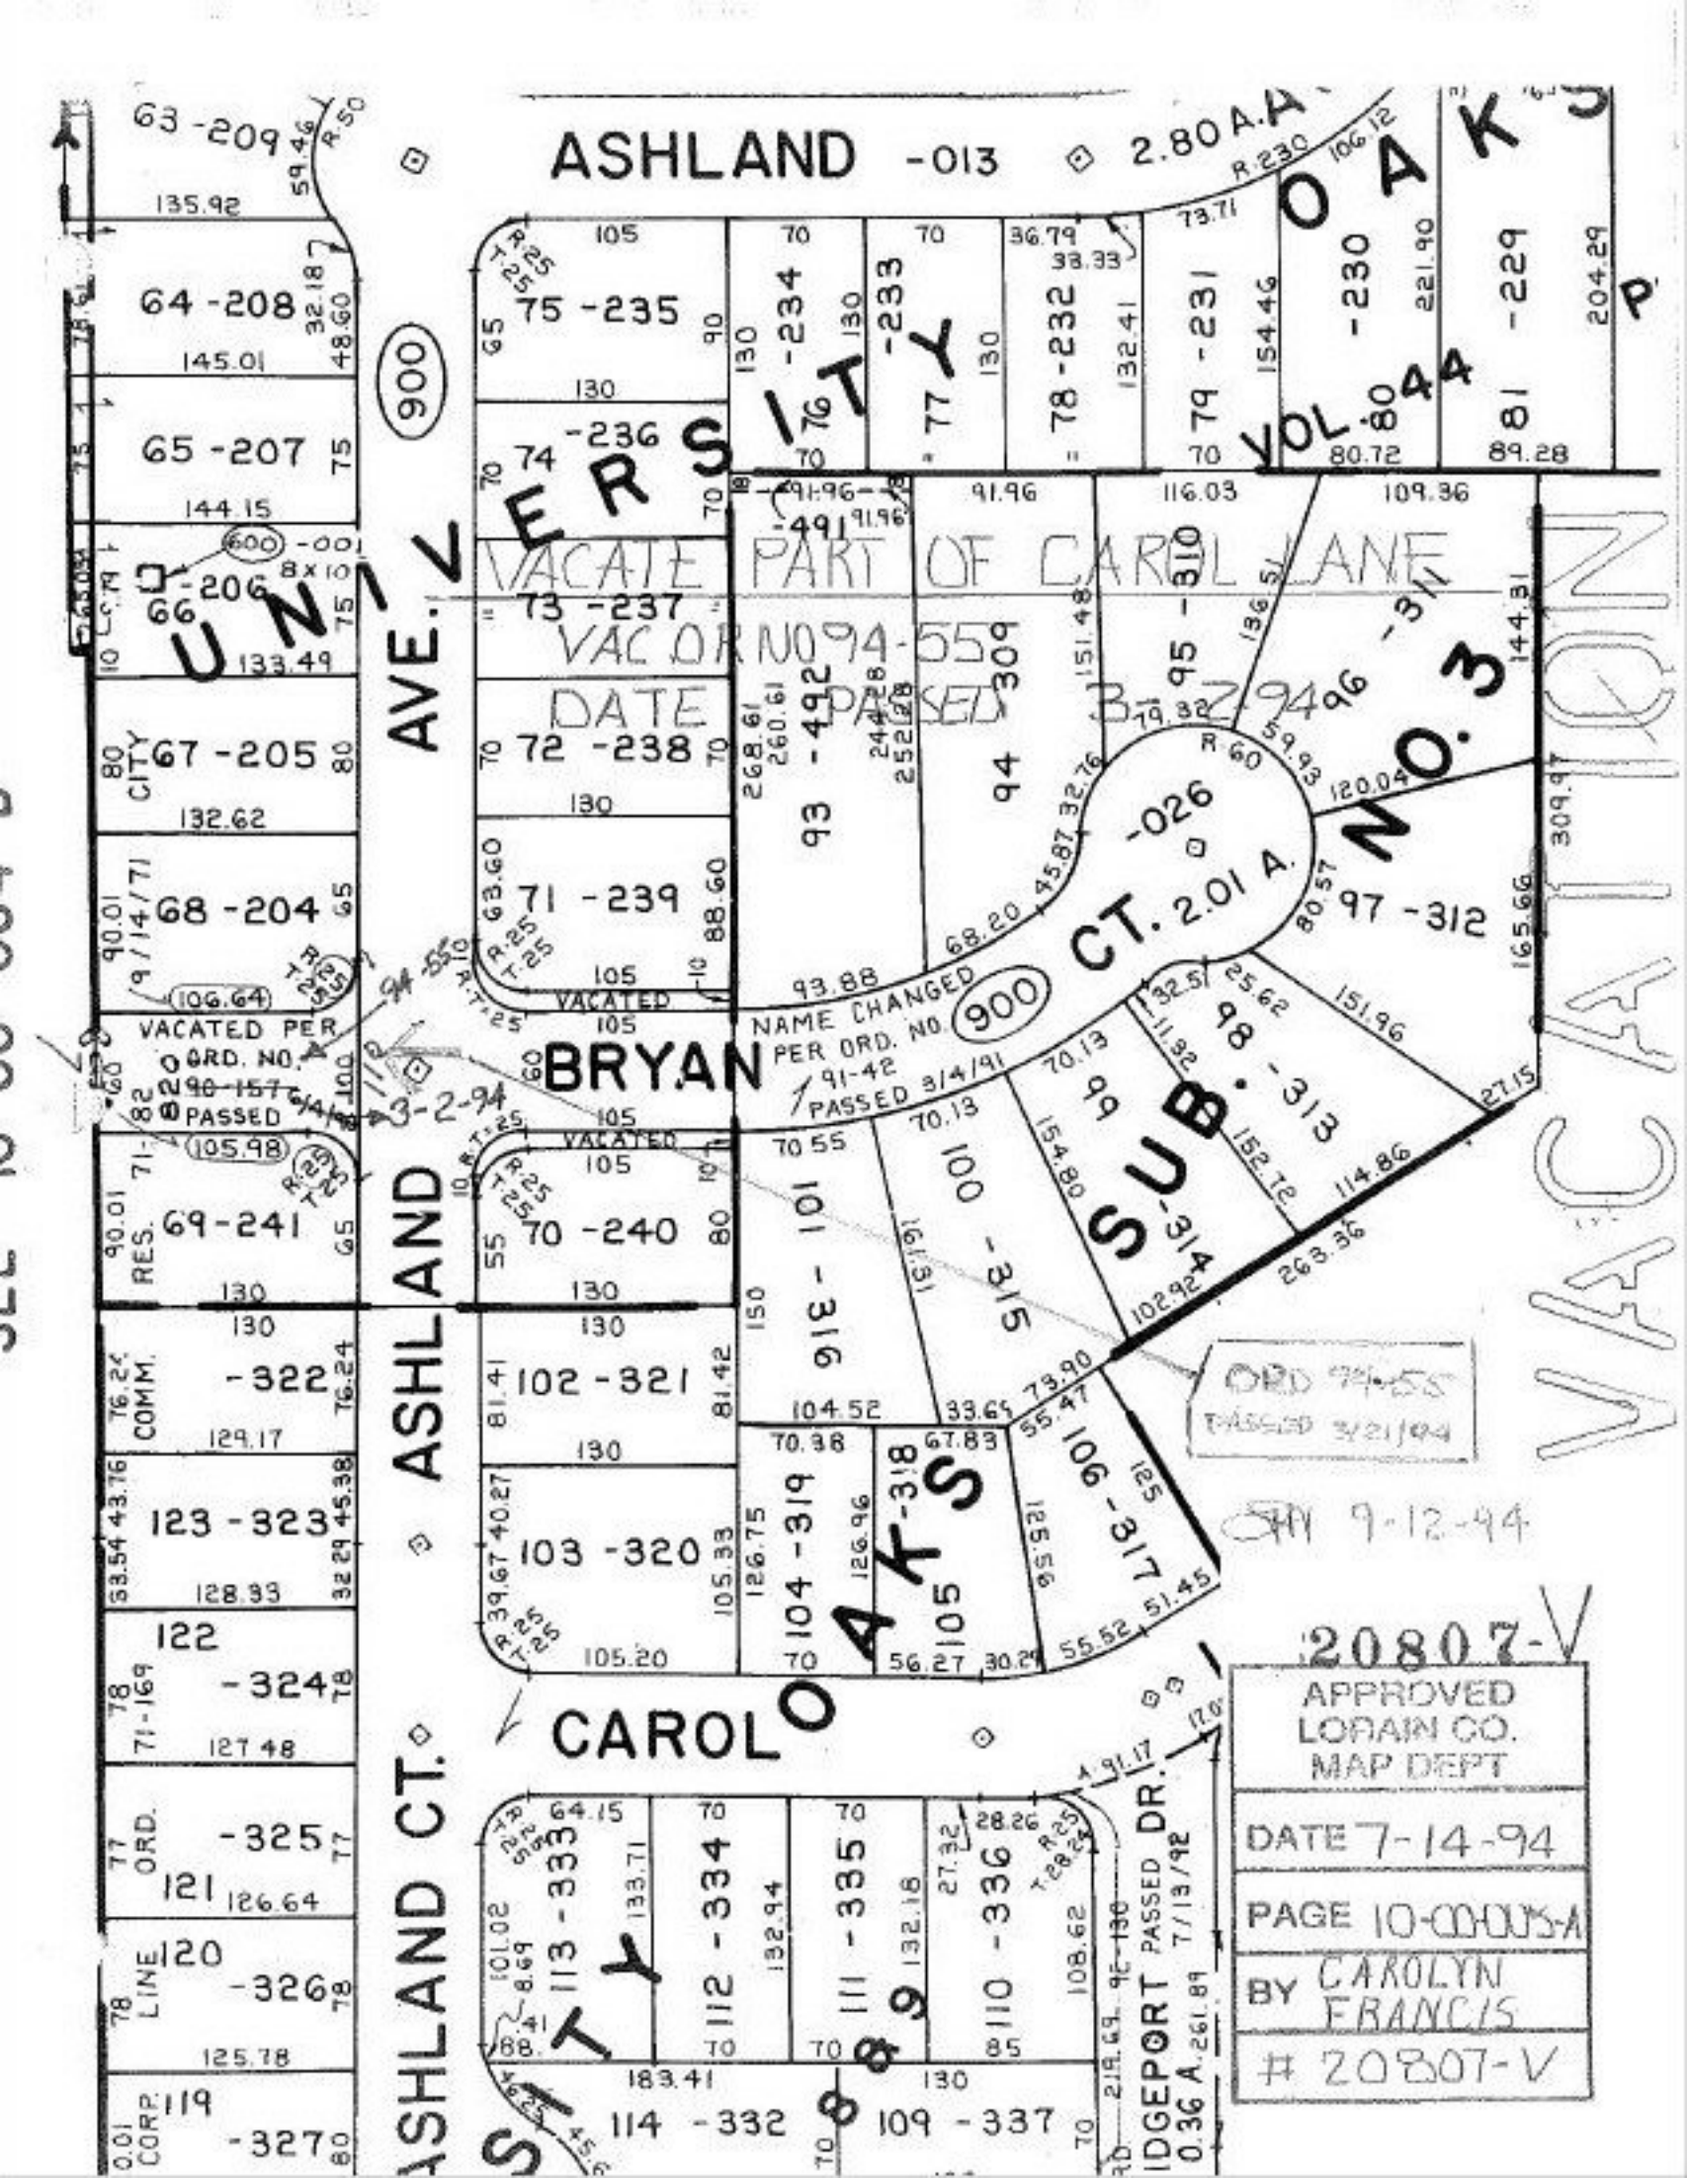
ASHLAND -013
2.80 A.A.
VOL 44 P
ASHLAND AVE.
ASHLAND CT.
BRYAN
CAROL OAKS
VACATION
VACATE PART OF CAROL LANE
VACATED
NAME CHANGED PER ORD. NO. 91-42 PASSED 3/4/91
VACATED PER ORD. NO. 90-157 PASSED 6/4/90
ORD 94-55 PASSED 3/21/94
SUB. NO. 3
CT. 2.01 A.
APPROVED LORAIN CO. MAP DEPT
DATE 7-14-94
PAGE 10-00005-A
BY CAROLYN FRANCIS
20807-V
20807-V
9-12-94