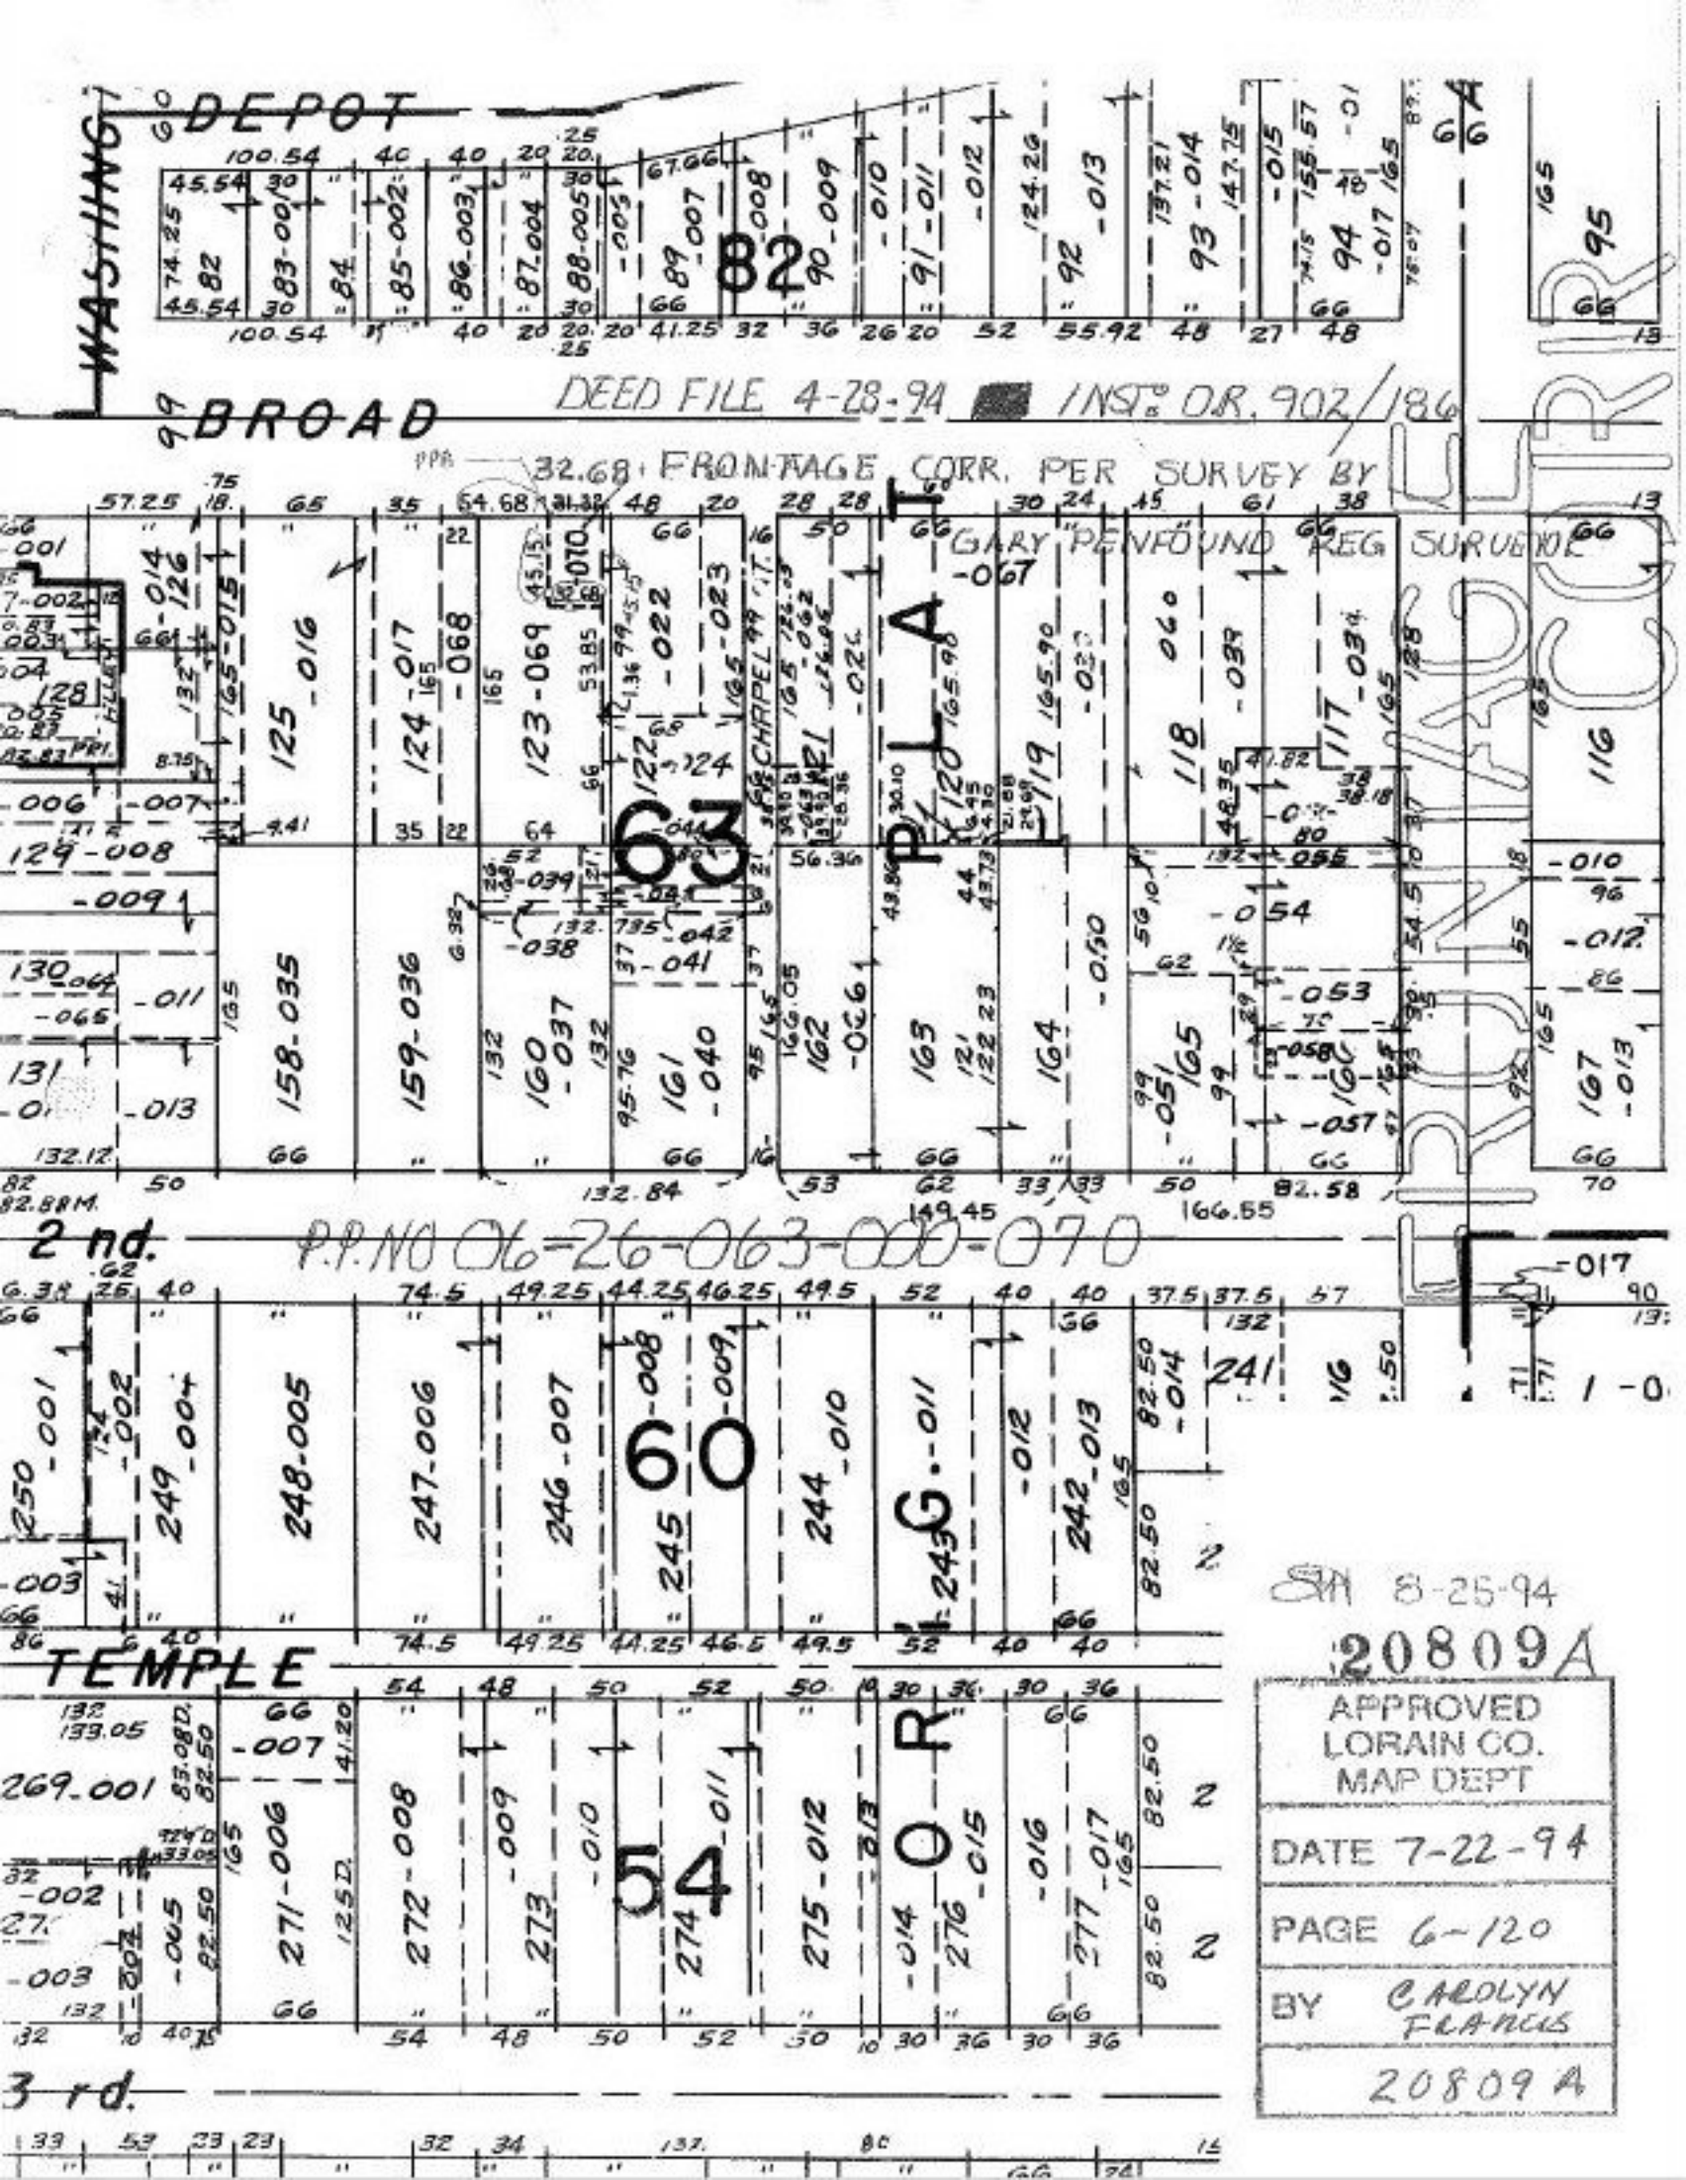
DEPOT
WASHINGTON
BROAD
DEED FILE 4-28-94 INST. O.R. 902/186
FRONTAGE CORR. PER SURVEY BY
GARY PENFOUND REG SURVEYOR
PLAT
CHAPEL
2nd.
P.P. NO 06-26-063-000-070
TEMPLE
3rd.
SM 8-25-94
20809A
APPROVED
LORAIN CO.
MAP DEPT
DATE 7-22-94
PAGE 6-120
BY CAROLYN FRANCIS
20809 A