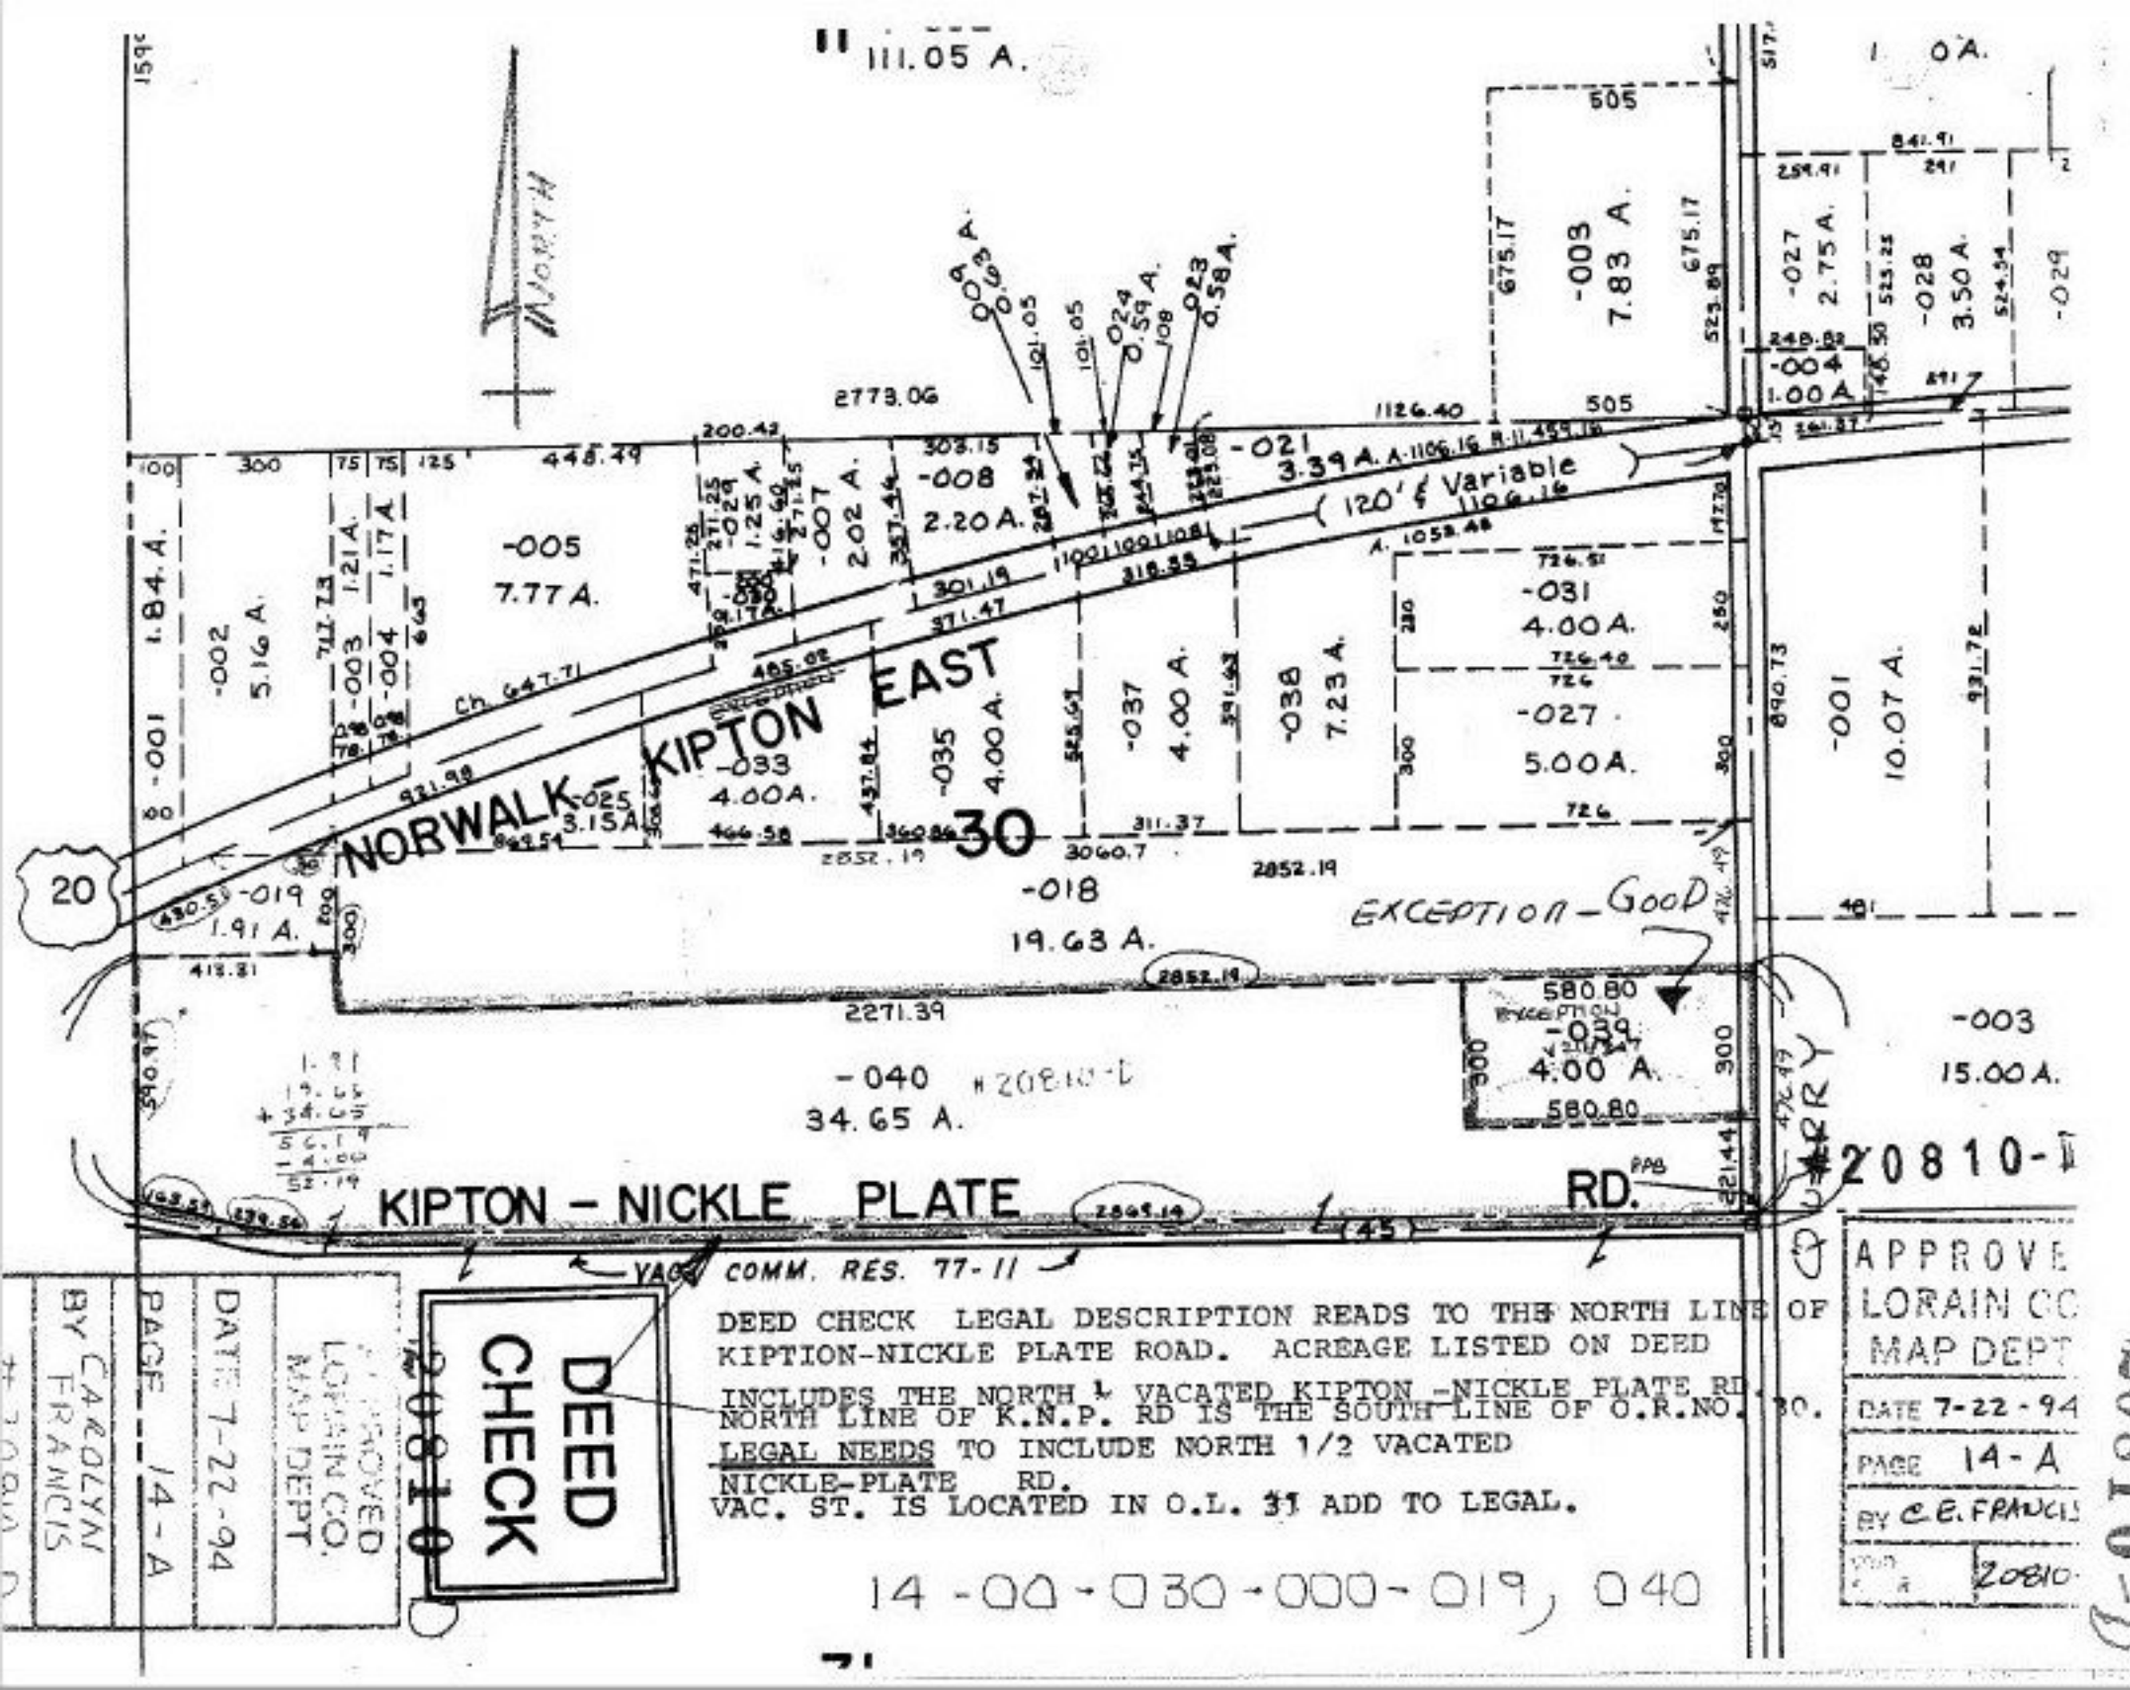
111.05 A.
NORTH
-003
7.83 A.
-027
2.75 A.
-028
3.50 A.
-029
-004
1.00 A.
-021
3.39 A.
120' & Variable
-008
2.20 A.
-007
2.02 A.
-005
7.77 A.
-002
5.16 A.
-001
1.84 A.
-003
1.21 A.
-004
1.17 A.
-031
4.00 A.
-027
5.00 A.
-001
10.07 A.
NORWALK - KIPTON EAST
-033
4.00 A.
-035
4.00 A.
-037
4.00 A.
-038
7.23 A.
-025
3.15 A.
30
-018
19.63 A.
-019
1.91 A.
20
EXCEPTION - GOOD
-040
34.65 A.
-003
15.00 A.
KIPTON - NICKLE PLATE RD.
VAC. COMM. RES. 77-11
DEED CHECK
DEED CHECK LEGAL DESCRIPTION READS TO THE NORTH LINE OF KIPTON-NICKLE PLATE ROAD. ACREAGE LISTED ON DEED INCLUDES THE NORTH ½ VACATED KIPTON-NICKLE PLATE RD. NORTH LINE OF K.N.P. RD IS THE SOUTH LINE OF O.R.NO. 30.
LEGAL NEEDS TO INCLUDE NORTH 1/2 VACATED NICKLE-PLATE RD.
VAC. ST. IS LOCATED IN O.L. 31 ADD TO LEGAL.
14-00-030-000-019, 040
APPROVED LORAIN CO. MAP DEPT.
DATE 7-22-94
PAGE 14-A
BY CAROLYN FRANCIS
20810-D