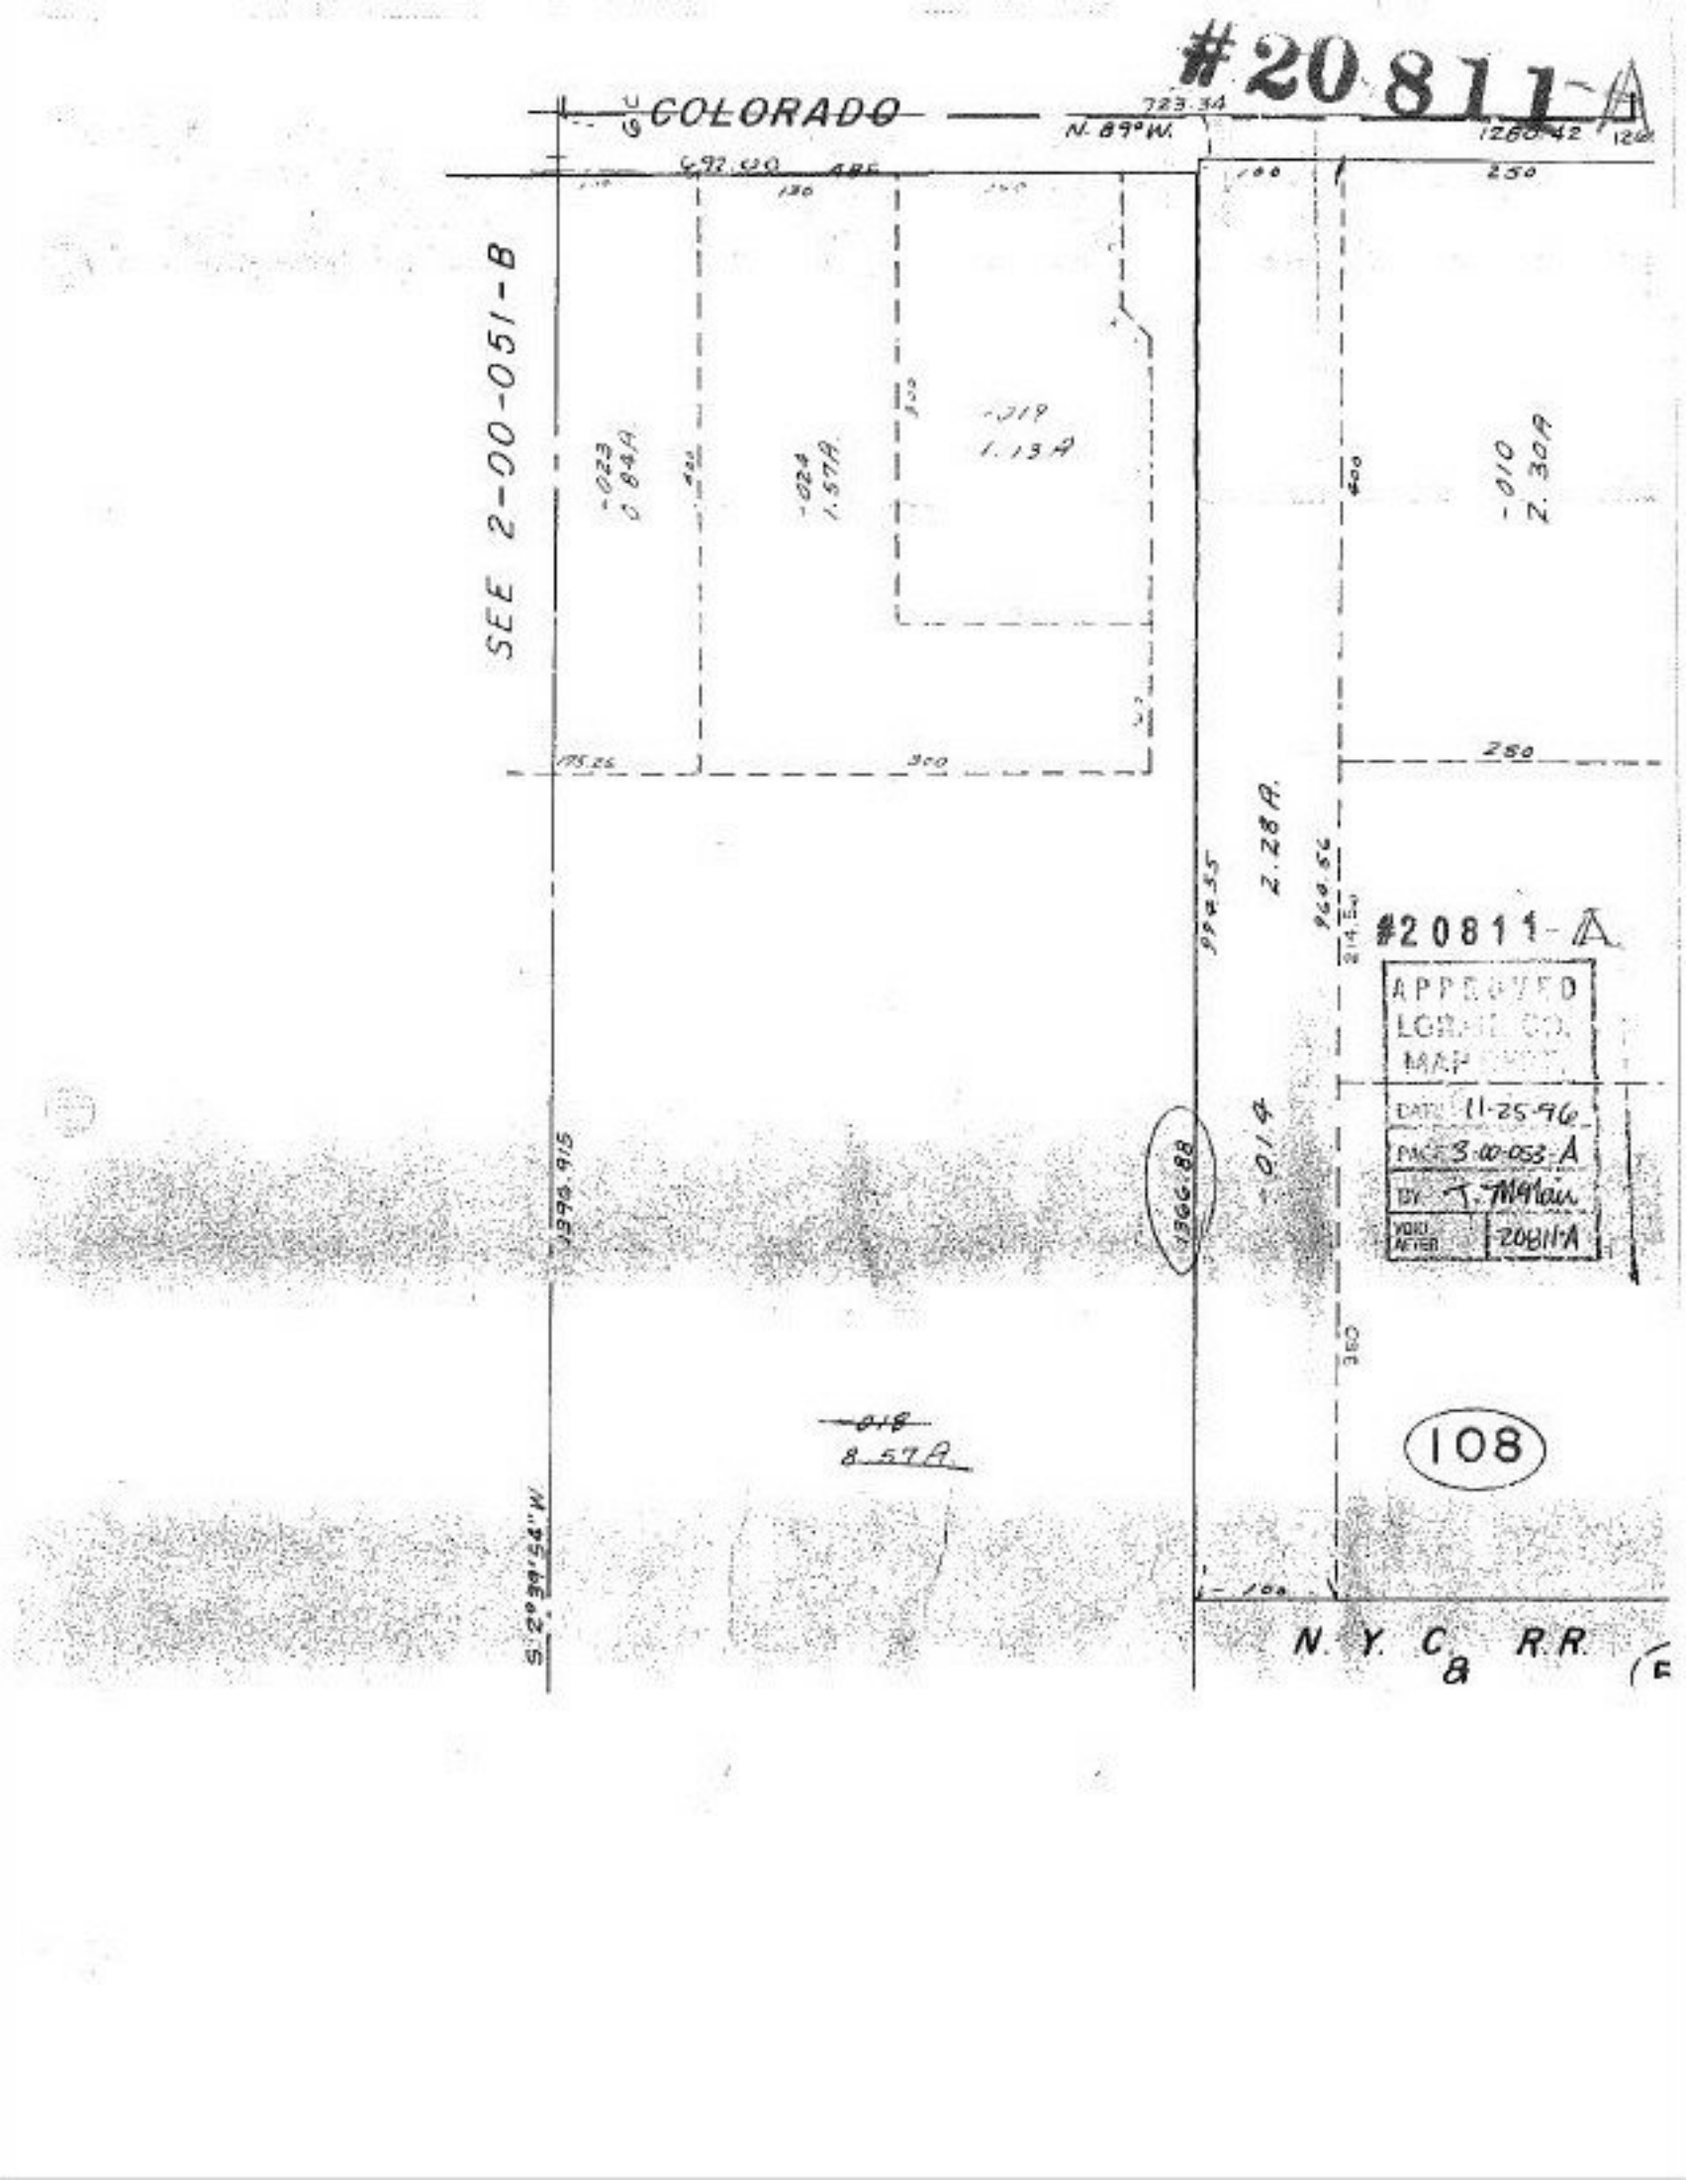
#20811-A
COLORADO
723.34
N. 89°W.
1280.42
SEE 2-00-051-B
-023
0.84A
-024
1.57A
-019
1.13A
-010
2.30A
2.28A.
#20811-A
APPROVED
MAP
DATE 11-25-96
MAP 3-00-053-A
BY T. McClain
YOKI AFTER 20811-A
-014
-018
8.57A
108
S. 2°39'54" W.
N. Y. C & R.R.