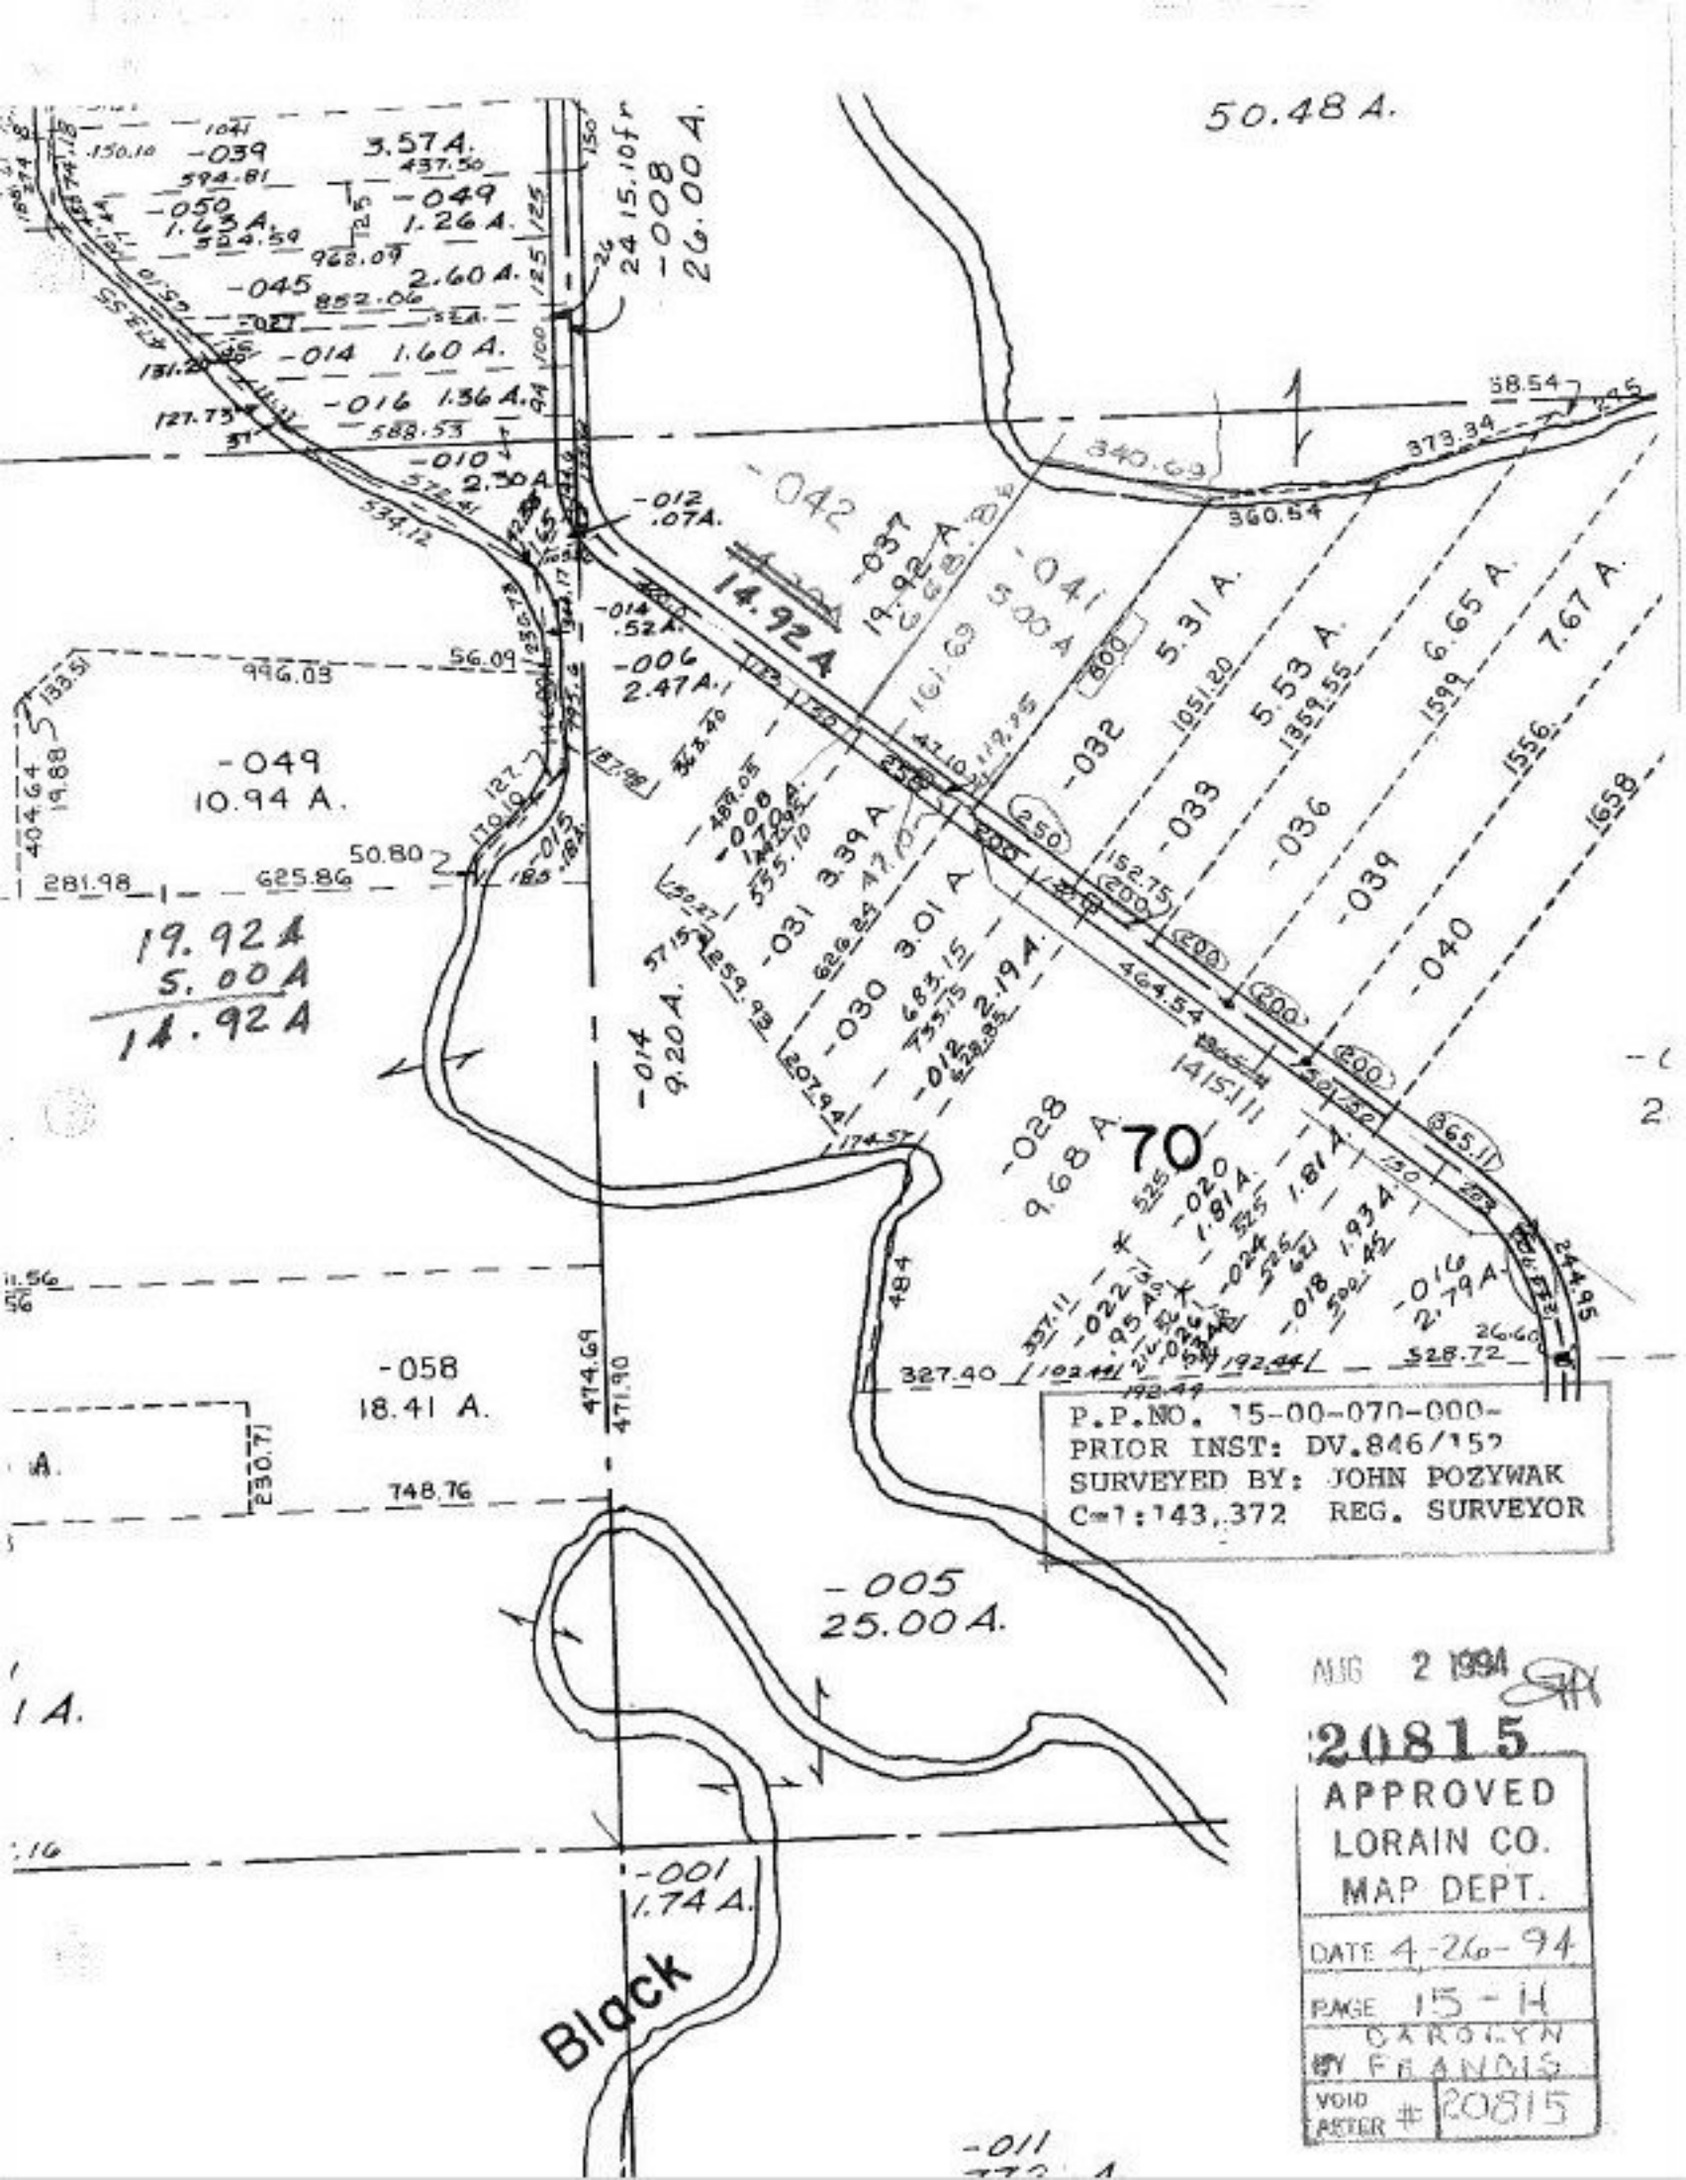
50.48 A.
-039 3.57 A.
-050 1.63 A.
-049 1.26 A.
-045 2.60 A.
-014 1.60 A.
-016 1.36 A.
-010 2.30 A.
-008 26.00 A.
-012 .07 A.
-042
-037 19.92 A.
14.92 A
-041 5.00 A
-014 .52 A.
-006 2.47 A.
-049 10.94 A.
-032 5.31 A.
-033 5.53 A.
-036 6.65 A.
-039 7.67 A.
-040
-031 3.39 A.
-030 3.01 A.
-012 2.19 A.
-014 9.20 A.
-028 9.68 A.
-020 1.81 A.
-024 1.93 A.
-022 .95 A.
-018
-016 2.79 A.
-058 18.41 A.
-005 25.00 A.
-001 1.74 A.
19.92 A
5.00 A
14.92 A
70
Black
P.P.NO. 15-00-070-000-
PRIOR INST: DV.846/152
SURVEYED BY: JOHN POZYWAK
C=1:143,372 REG. SURVEYOR
AUG 2 1994
20815
APPROVED
LORAIN CO.
MAP DEPT.
DATE 4-26-94
PAGE 15 - H
BY CAROLYN FRANCIS
VOID AFTER # 20815