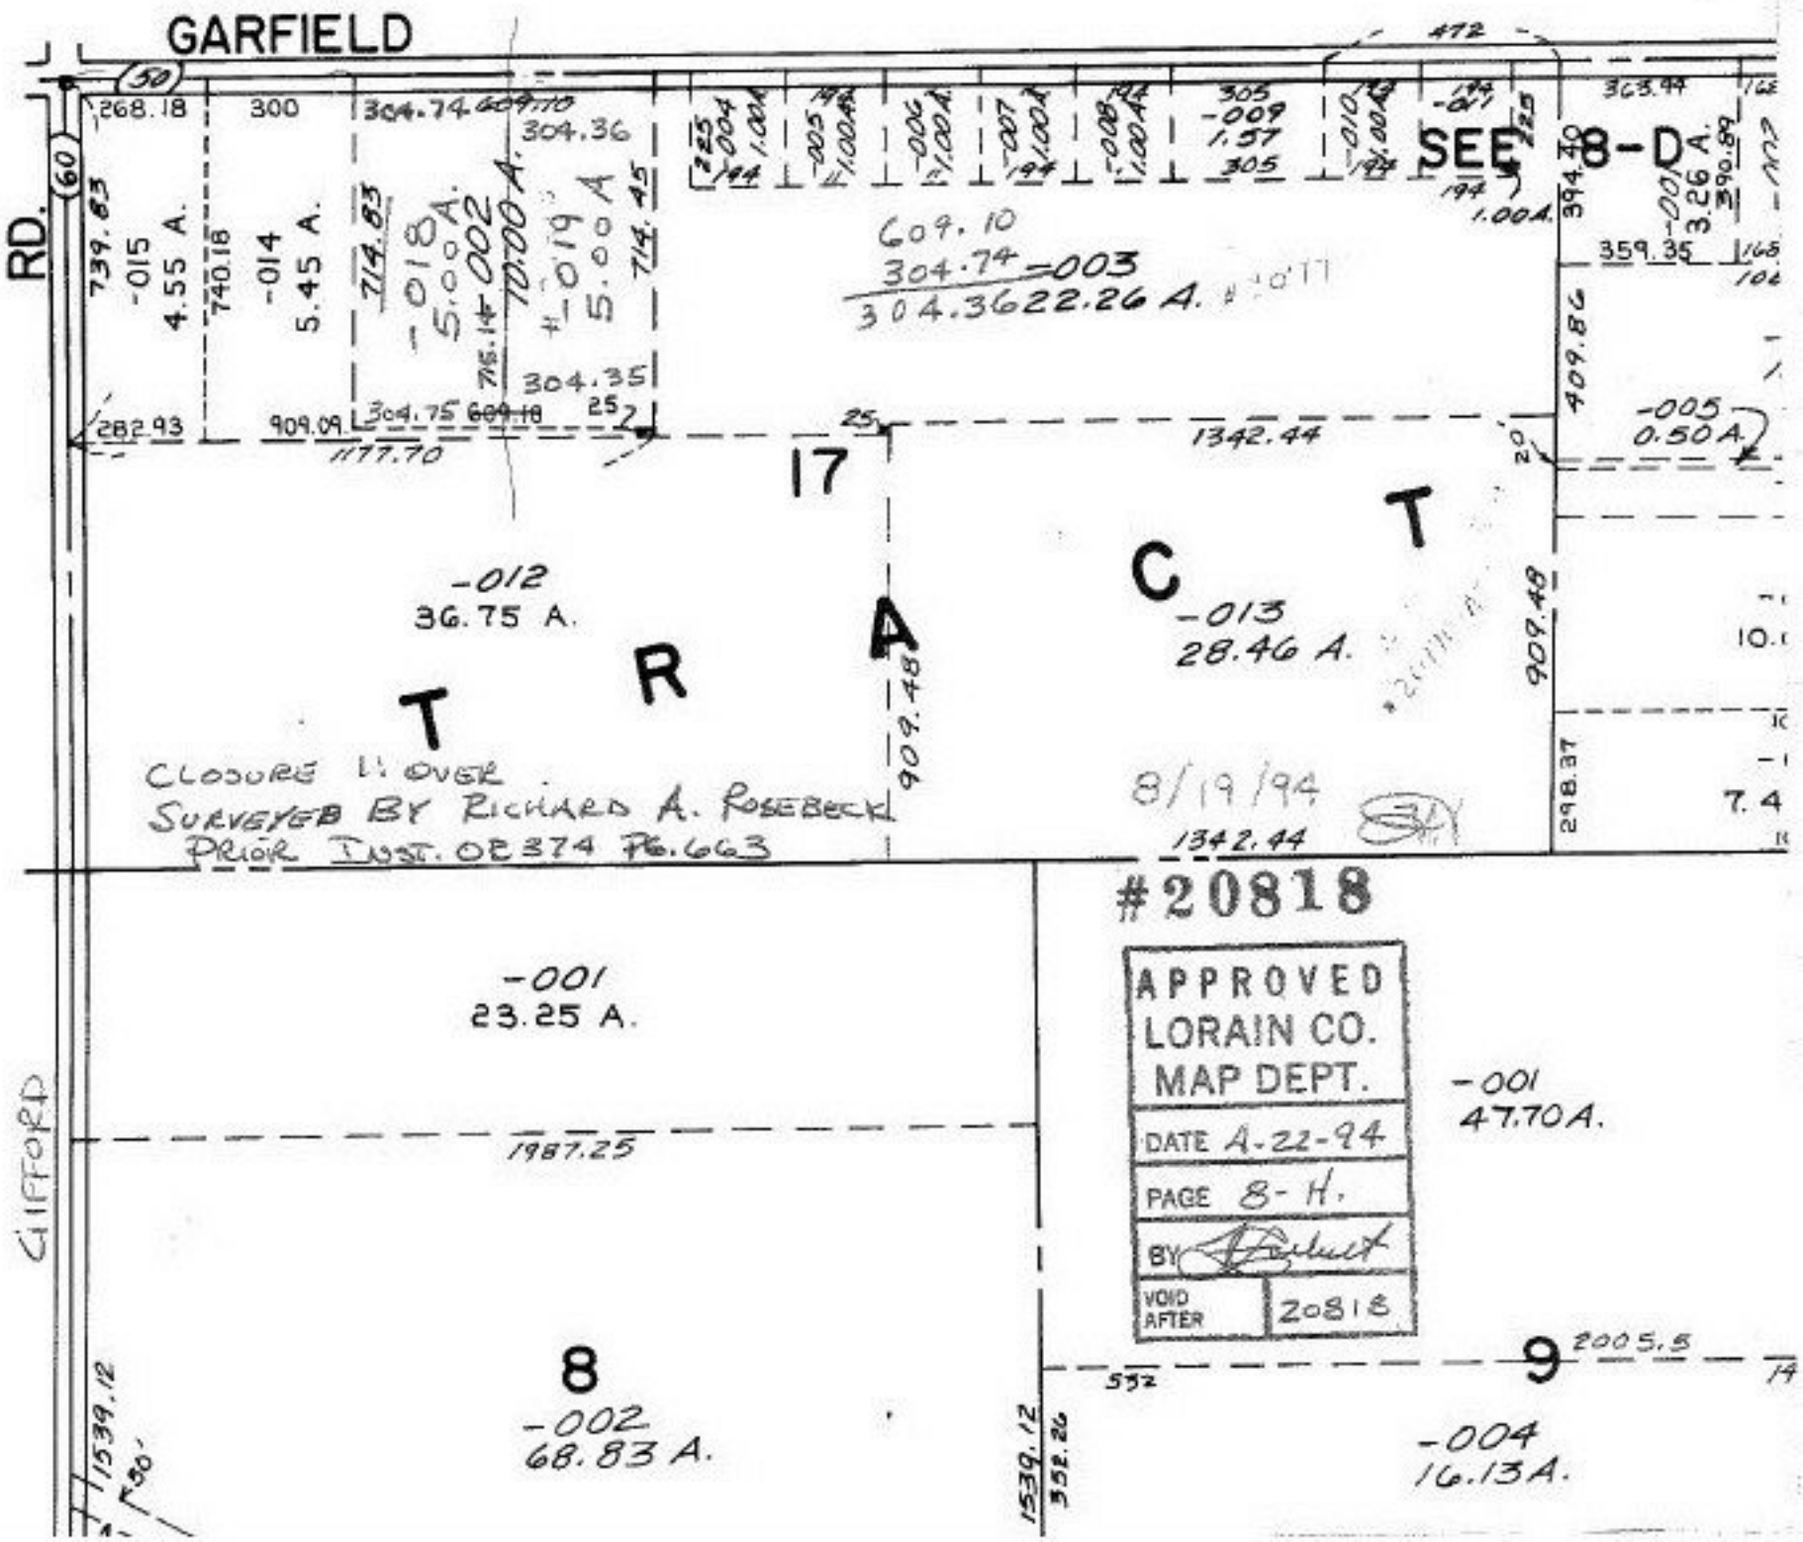
GARFIELD
RD.
GIFFORD
SEE 8-D
17
T R A C T
-012
36.75 A.
-013
28.46 A.
-001
23.25 A.
-001
47.70 A.
8
-002
68.83 A.
9
-004
16.13 A.
-005
0.50 A.
-015
4.55 A.
-014
5.45 A.
-018
5.00 A.
-002
10.00 A.
-019
5.00 A.
-003
22.26 A.
609.10
304.74
304.36
304.35
1342.44
909.48
1177.70
1987.25
2005.5
1539.12
CLOSURE 1: OVER
SURVEYED BY RICHARD A. ROSEBECK
PRIOR INST. OR 374 PG. 663
8/19/94
#20818
APPROVED
LORAIN CO.
MAP DEPT.
DATE A-22-94
PAGE 8-H.
BY
VOID AFTER 20818