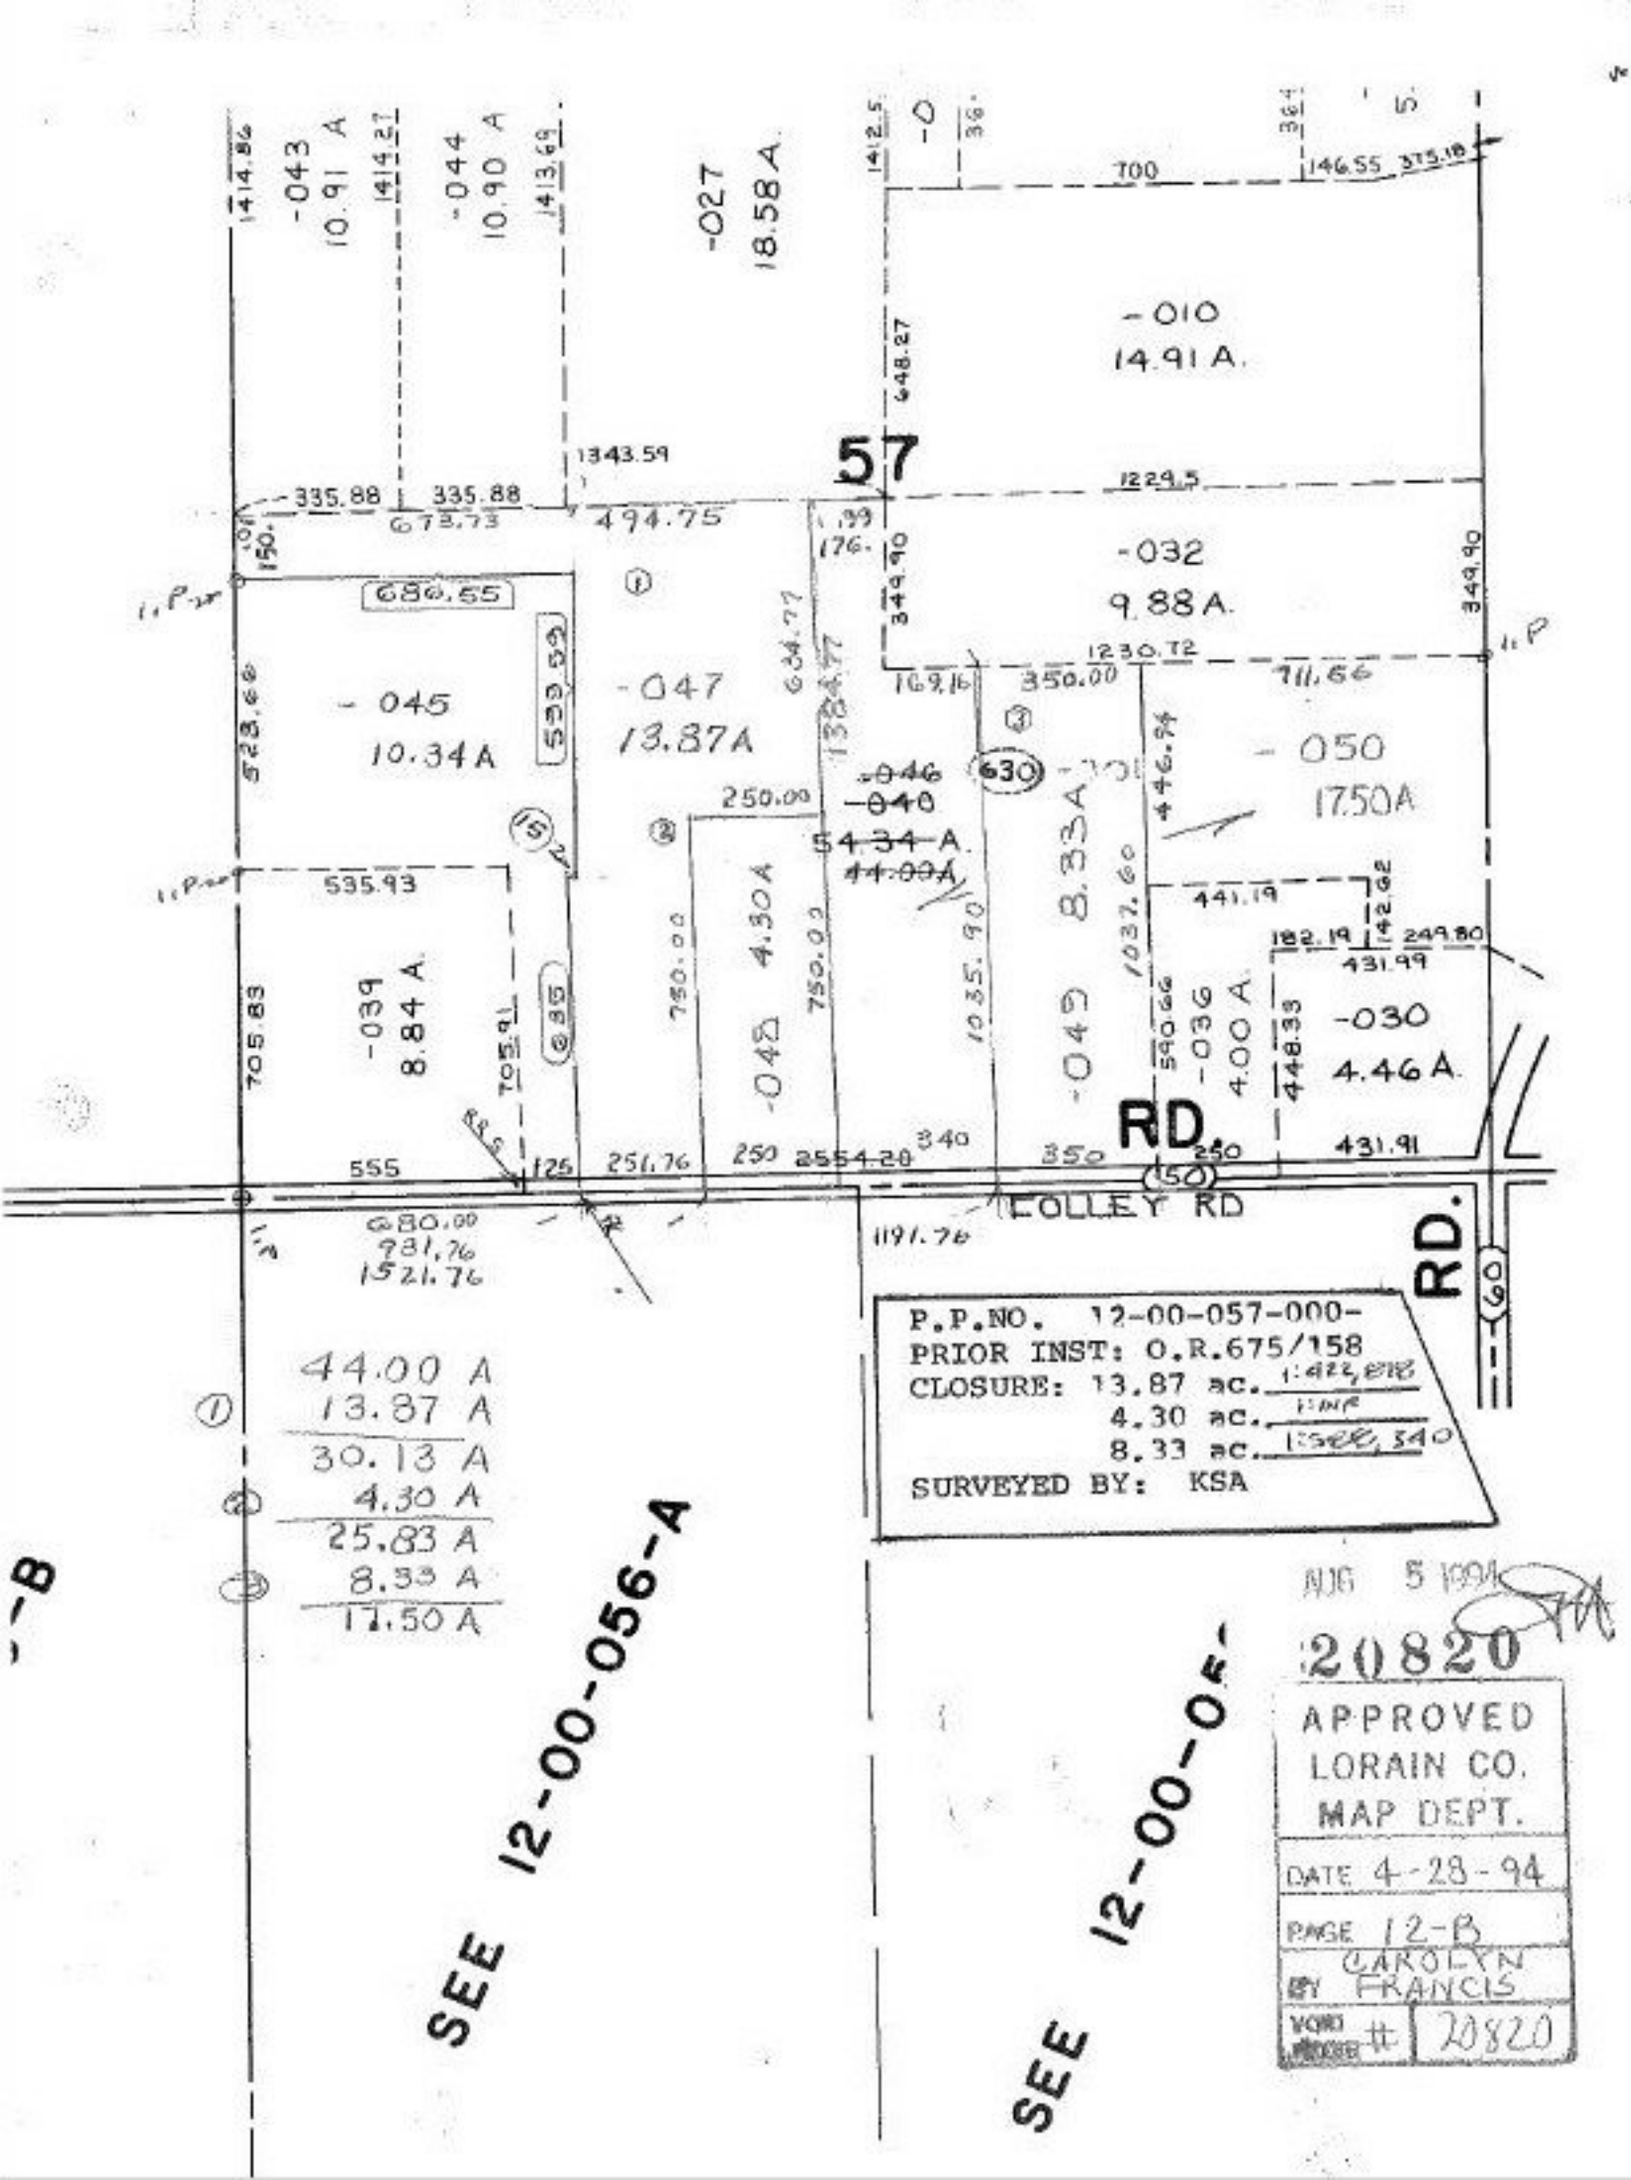
-043
10.91 A
-044
10.90 A
-027
18.58 A
-010
14.91 A.
57
-032
9.88 A.
-045
10.34 A
-047
13.87A
-046
-040
54.34 A.
44.00A
-050
17.50A
-039
8.84 A.
-048 4.30A
-049 8.33A
-036
4.00 A.
-030
4.46 A.
RD
LOLLEY RD
RD.
P.P.NO. 12-00-057-000-
PRIOR INST: O.R.675/158
CLOSURE: 13.87 ac.
4.30 ac.
8.33 ac.
SURVEYED BY: KSA
44.00 A
13.87 A
30.13 A
4.30 A
25.83 A
8.33 A
17.50 A
SEE 12-00-056-A
SEE 12-00-05
AUG 5 1994
20820
APPROVED
LORAIN CO.
MAP DEPT.
DATE 4-28-94
PAGE 12-B
BY CAROLYN FRANCIS
VOID # 20820